

JOSEPHINE COUNTY

3111 PETITION


1" = 200'

This map was prepared for assessment purposes only.

ALL WATER RIGHTS IDENTIFIED ON THIS MAP ARE PRIMARY WATER RIGHTS. SW 1/4 NE 1/4 SEE ATTACHMENT FOR SUPP. WATER RIGHTS.

NOTE: Srv. map indicates Lower River Road as 40' in width

SEE MAP 36 6 13 D

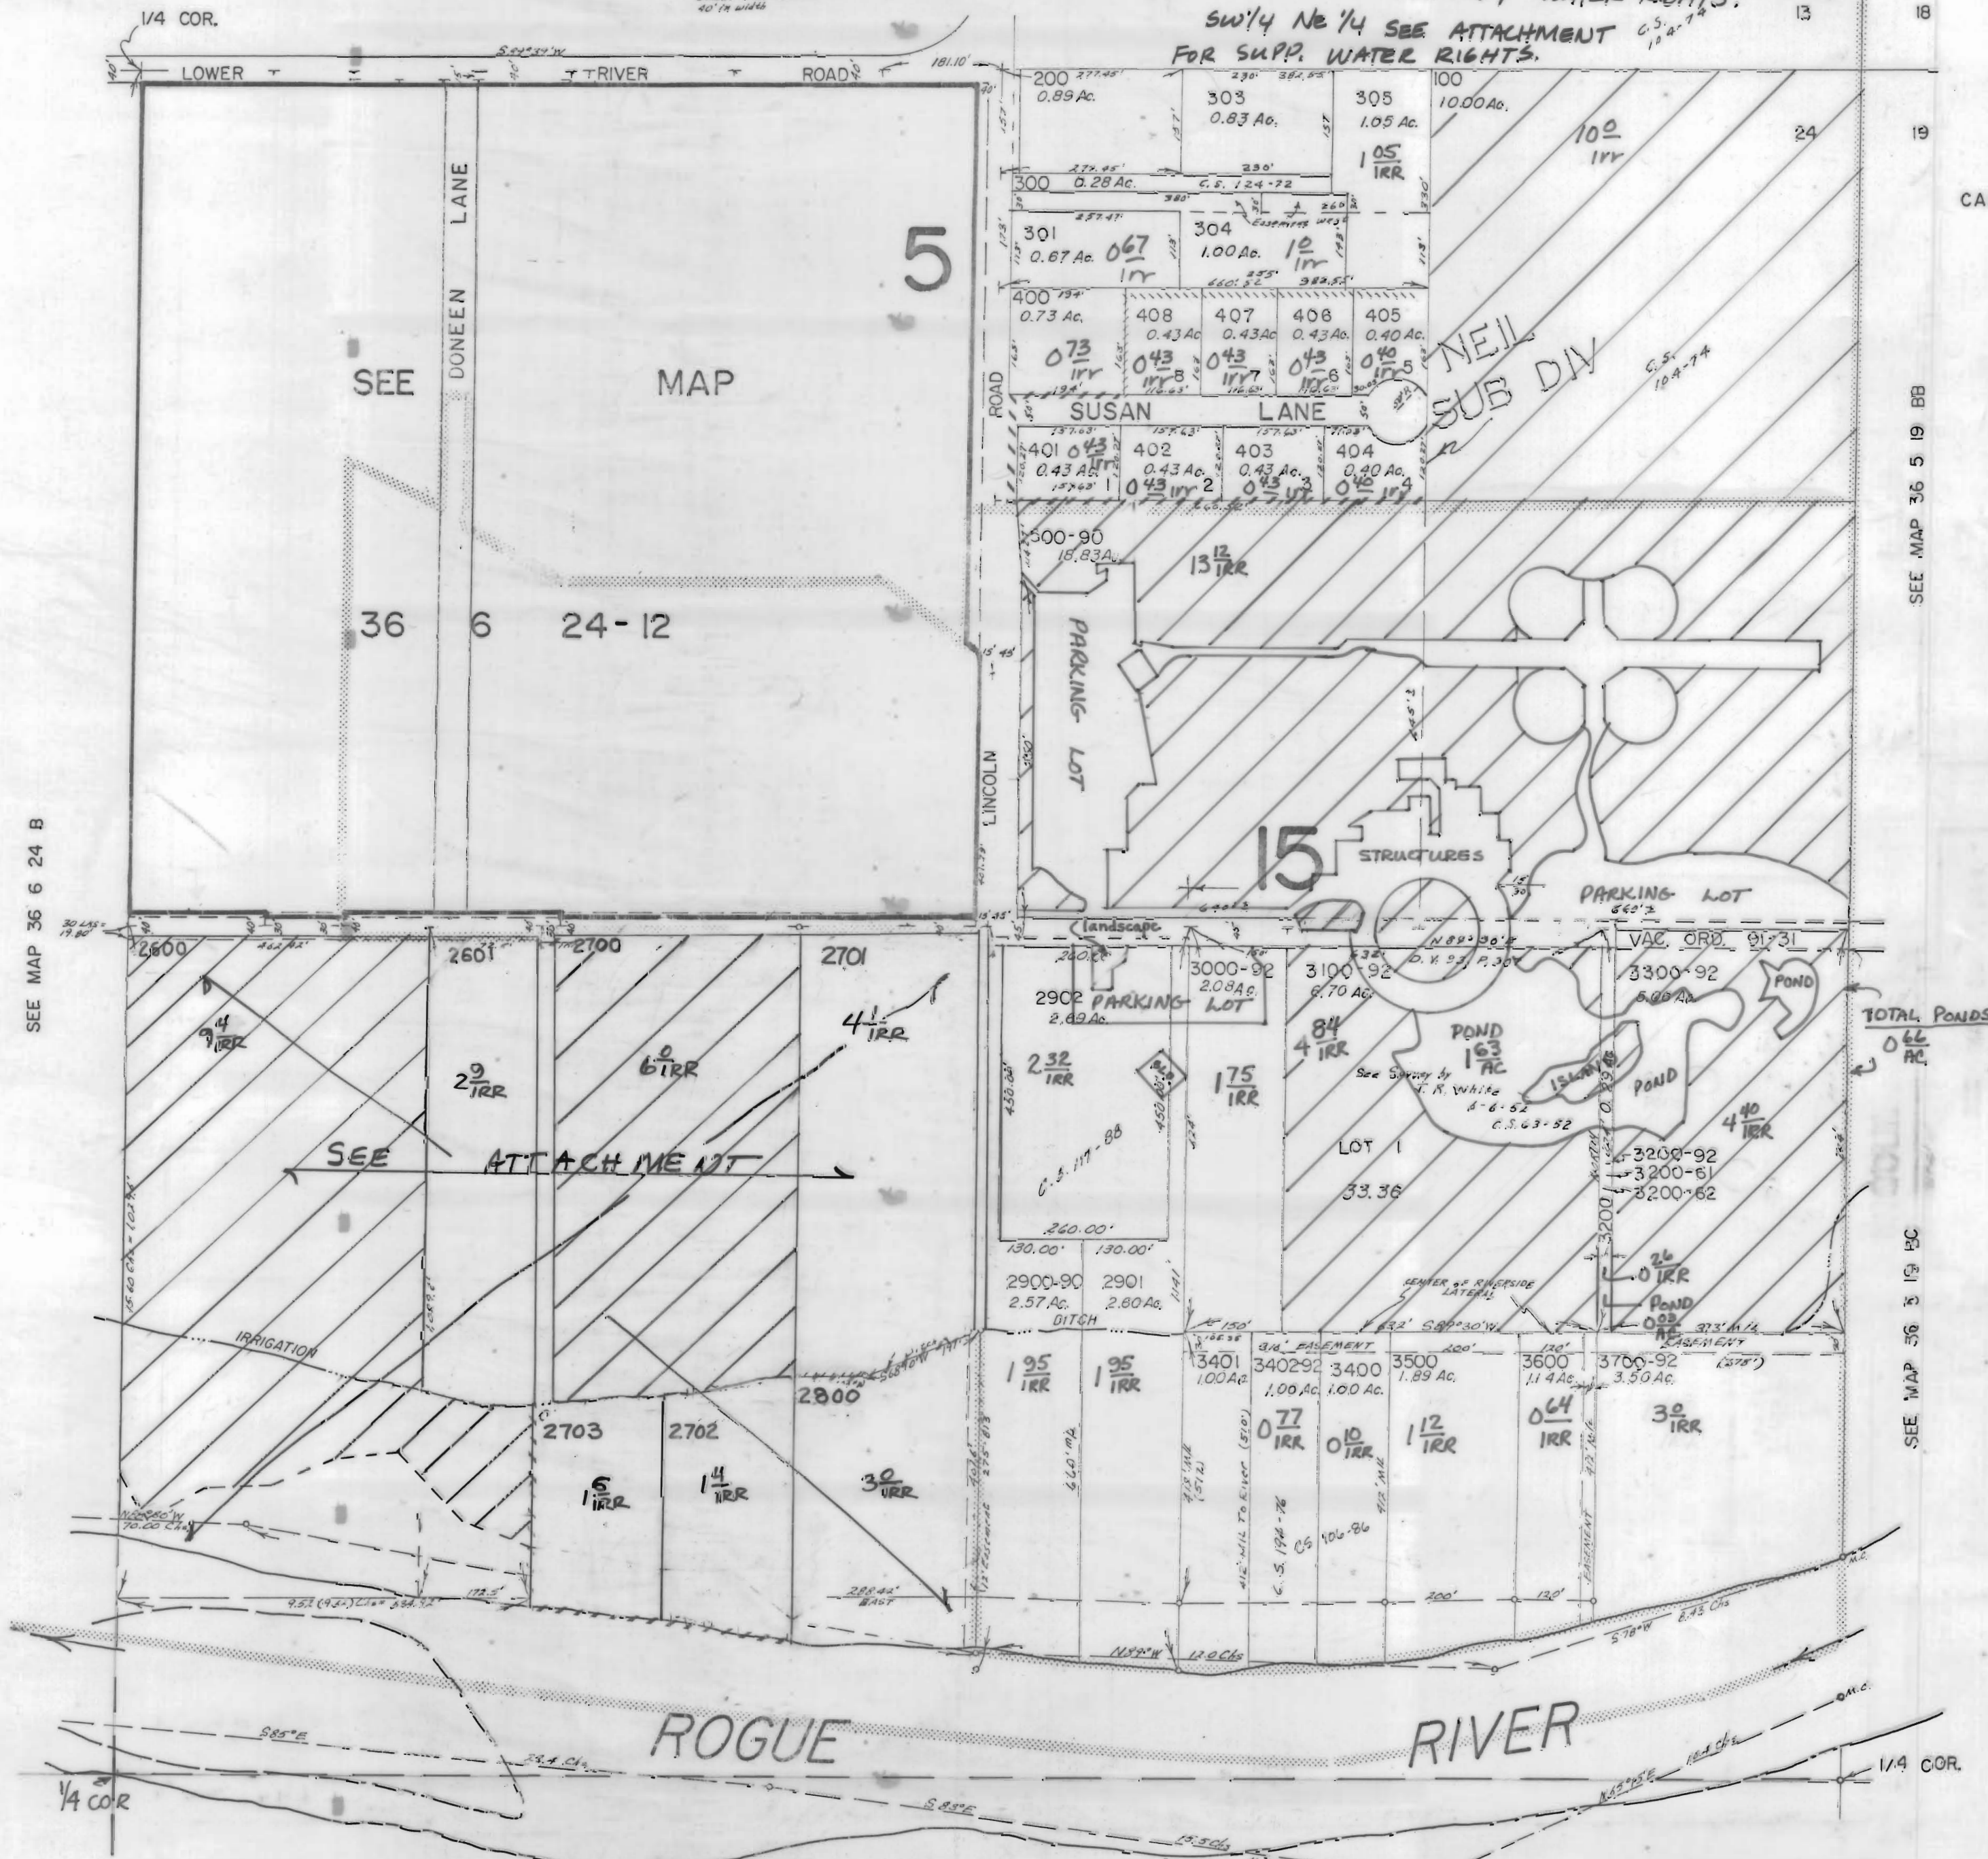

CANCELLED T.L.

- 2791
- 2300
- 2301
- 2790
- 390
- 302
- 3200-63
- 2792
- 2690
- 1701

SEE MAP 36 6 24 B

SEE MAP 36 5 19 BB

SEE MAP 36 6 19 BC



6 SEPT 03 RLH