


WORK COPY SECTION PLAT

Section 33 Township 26S Range 33E
County of HARNEY State of OREGON

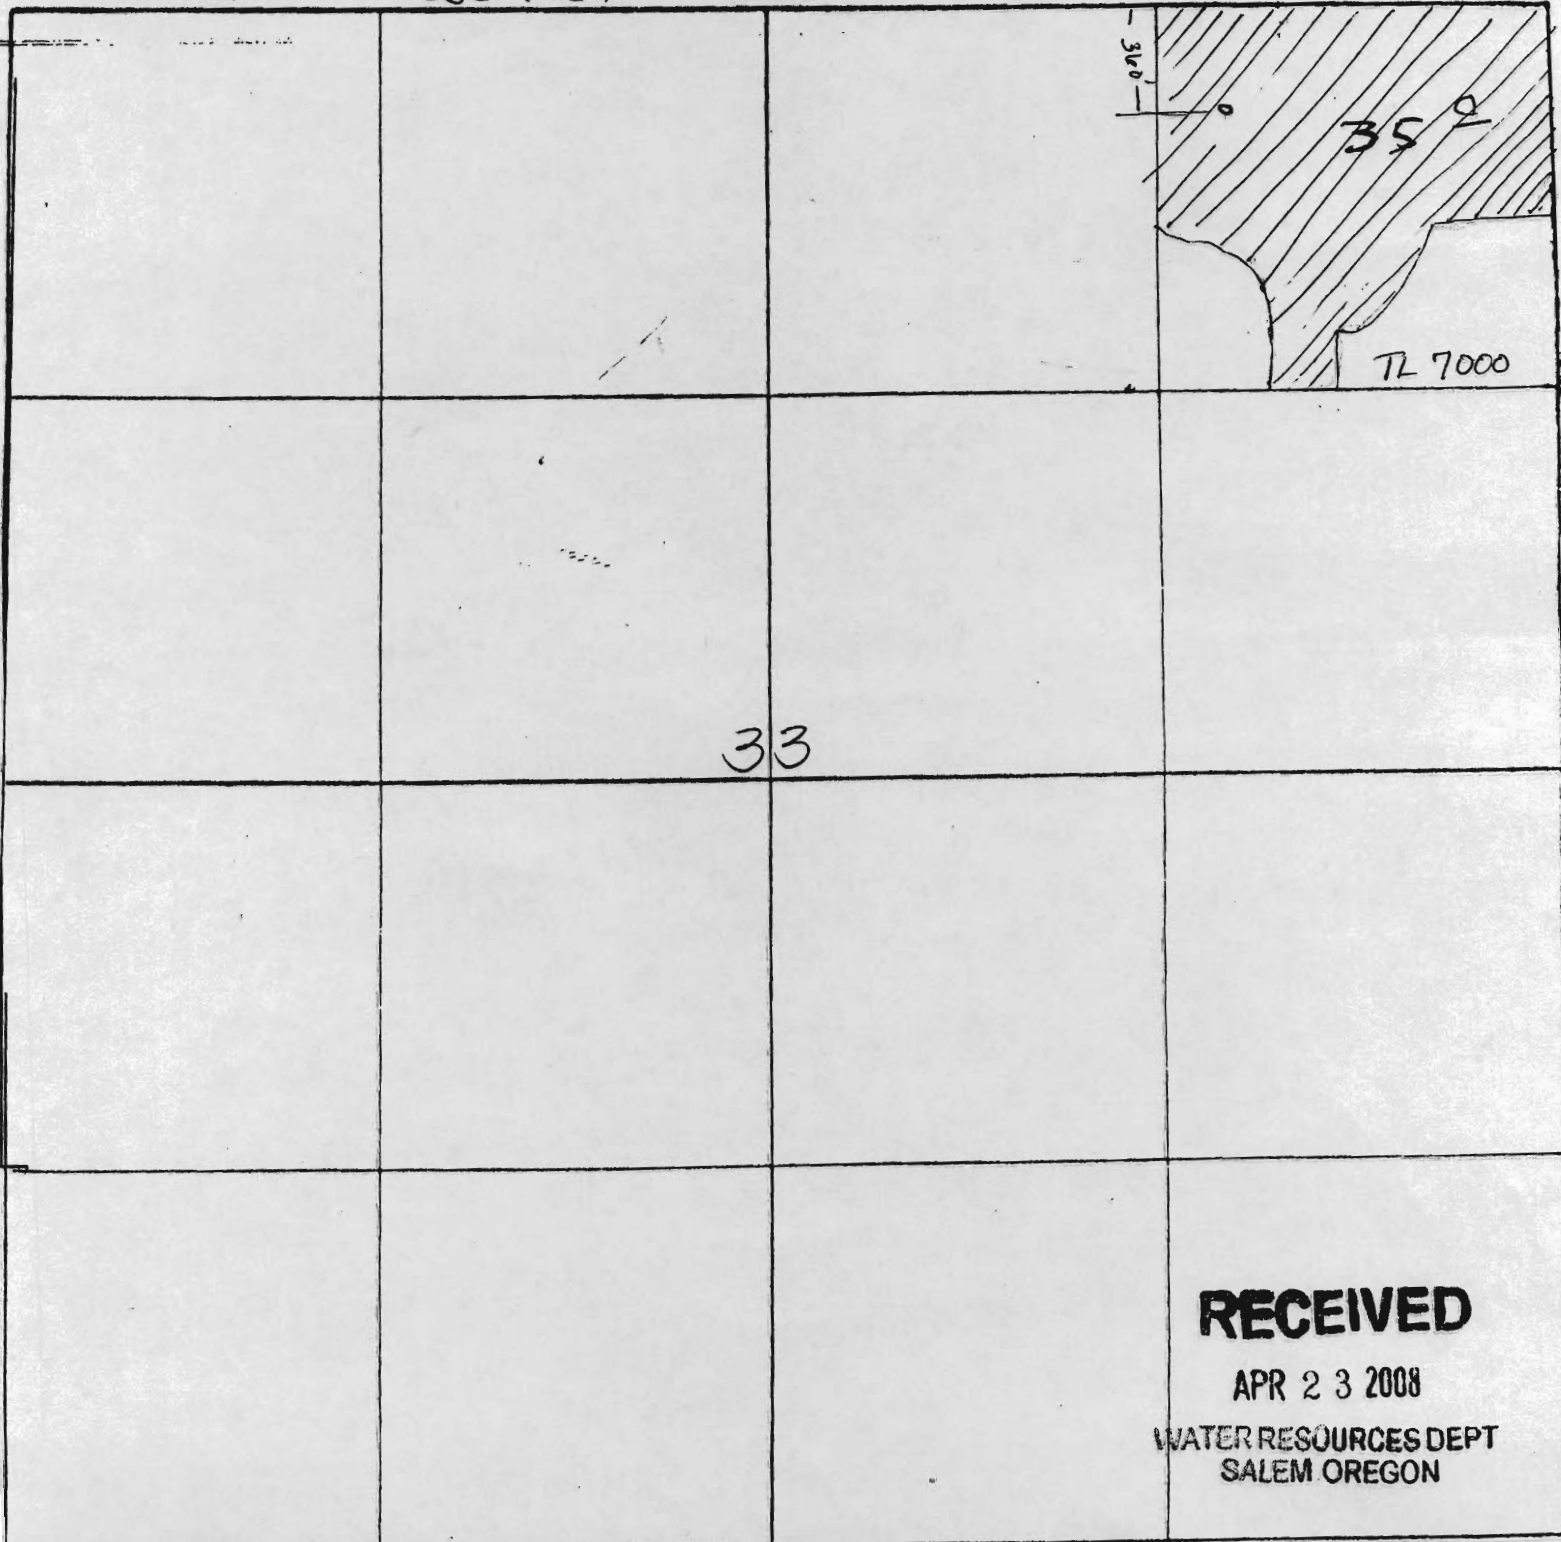

1" = ± 660 FEET NORTH



RECEIVED
APR 23 2008
WATER RESOURCES DEPT
SALEM OREGON

Well located 360' S + ~~758'~~ 1,162' W from ~~NE~~ NE corner of the NE 1/4 of NE 1/4 of Section 33.


SECTION PLAT

Section 33 Township 26S Range 33E

County of HARNEY State of OREGON



NORTH

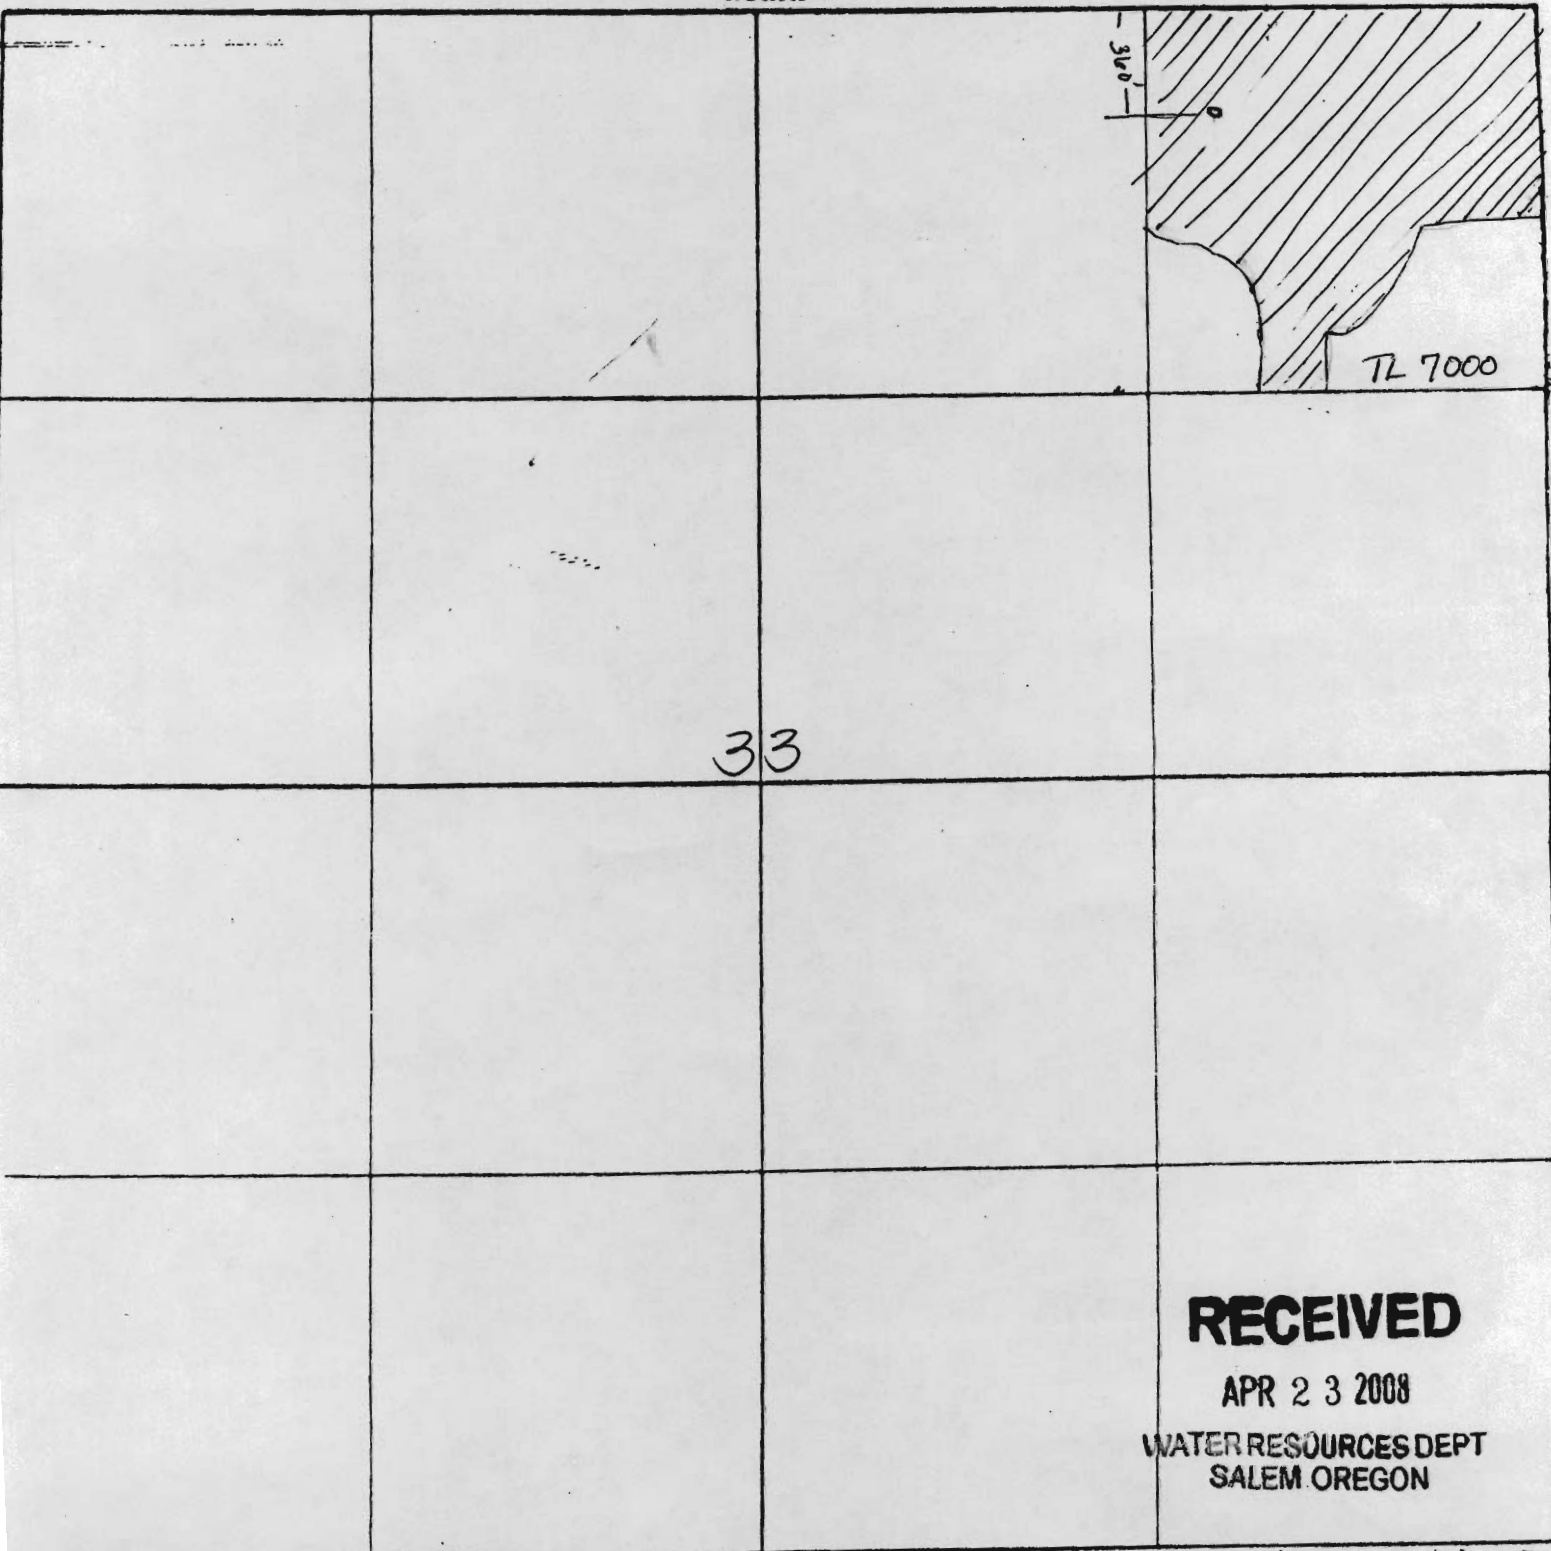

Well located 360' S + ~~758'~~ 1,162' W from ~~NE~~ NE corner of the NE 1/4 of NE 1/4 of Section 33.