




Application G-16980

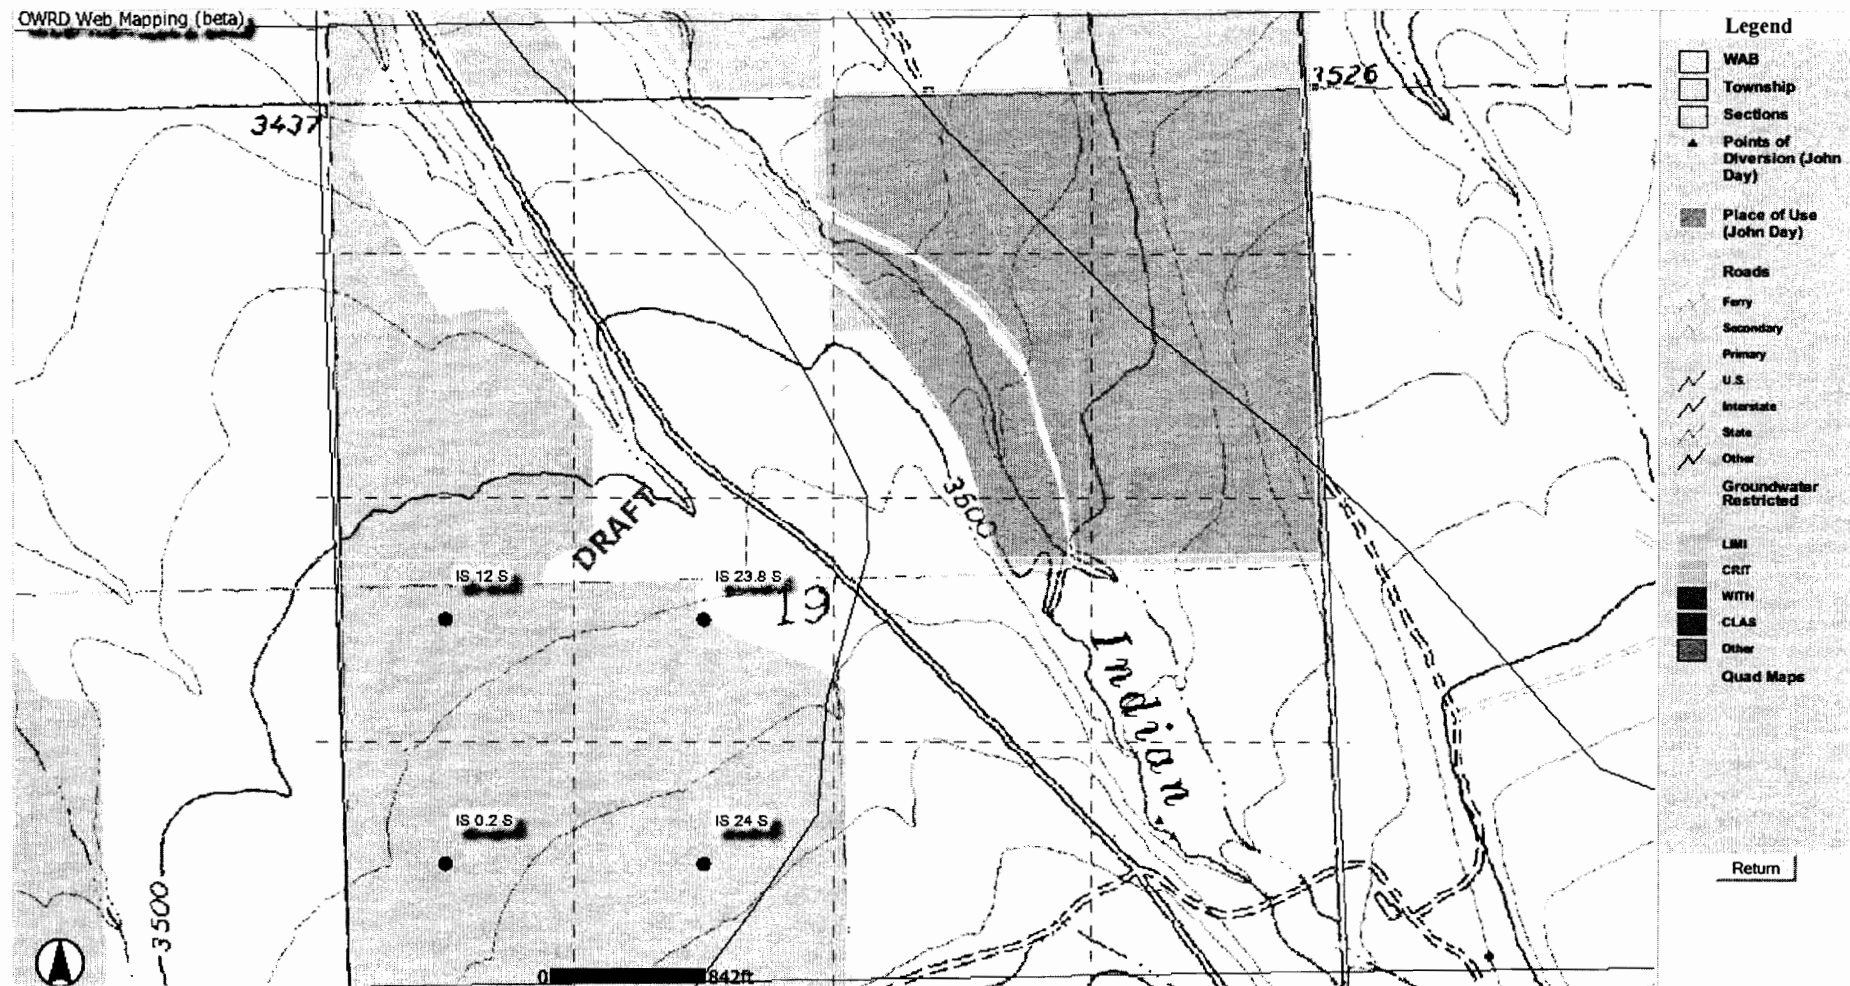

Application Map For Sam McDaniel T. 13S R. 33E W.M. Section 19

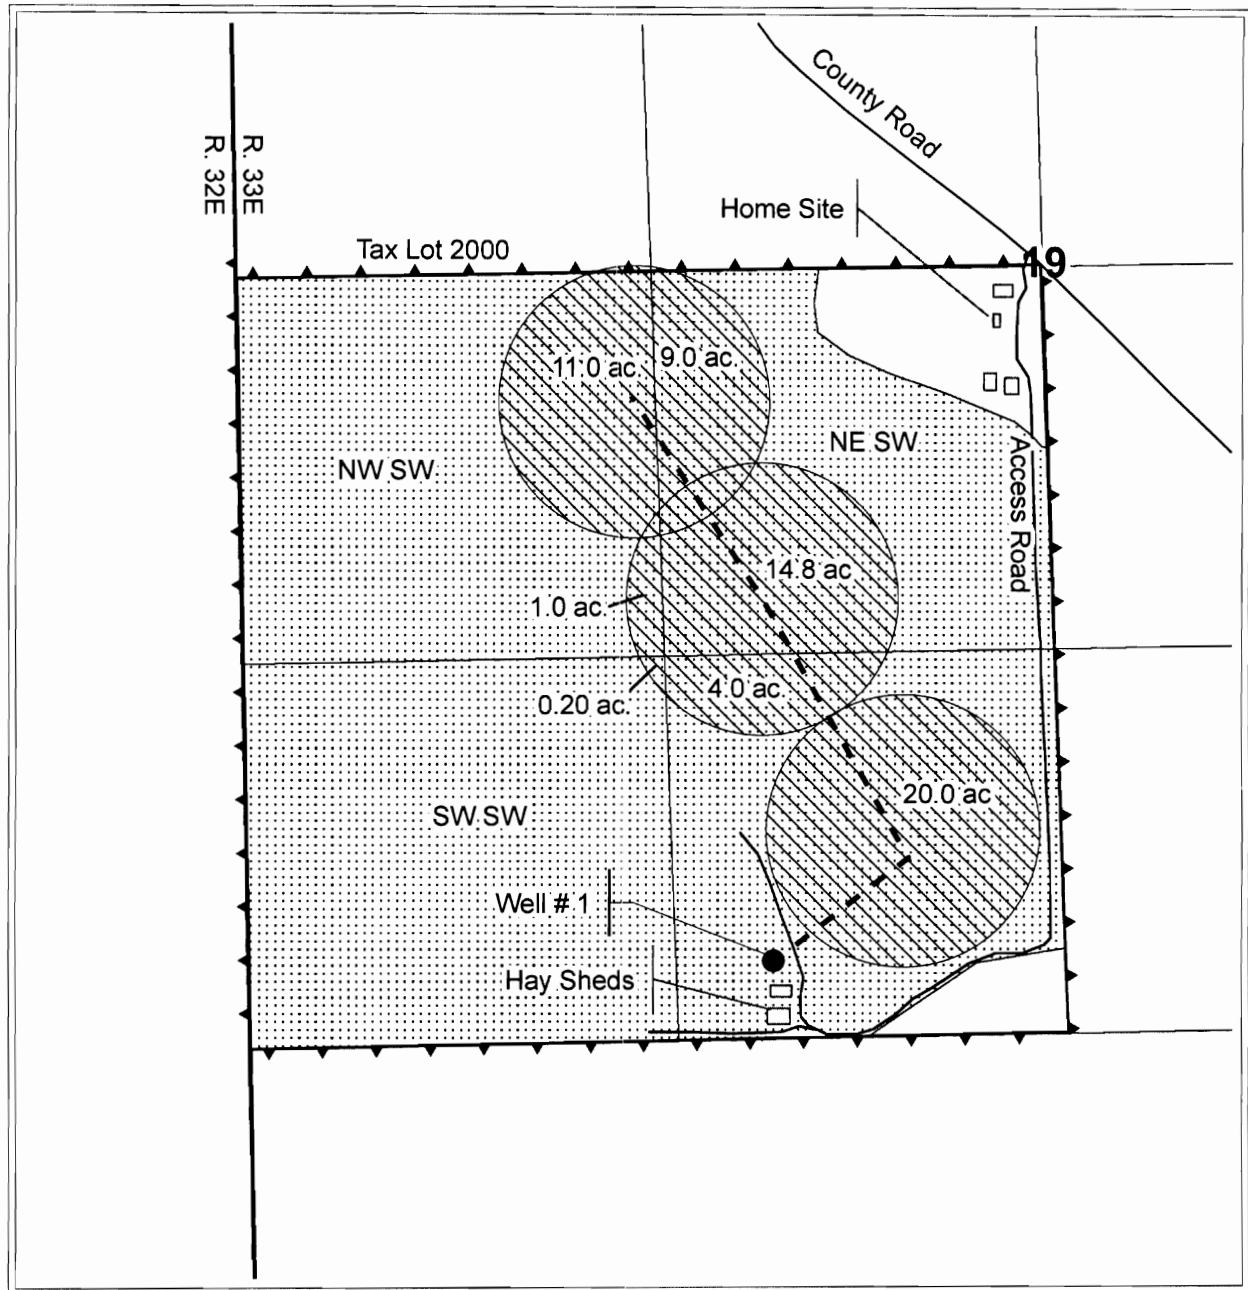


Approximate Well Location 118 deg 47' 29.763" W X 44 deg 25' 5.262" N

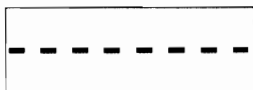


Mainline



Proposed Supplemental Irrigation totalling 60 acres +/-

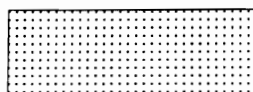

C-68489 Place of Use

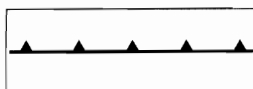


Tax Lot 2000 Boundary

RECEIVED

DEC 13 2007

WATER RESOURCES DEPT
SALEM, OREGON

App No G-16980

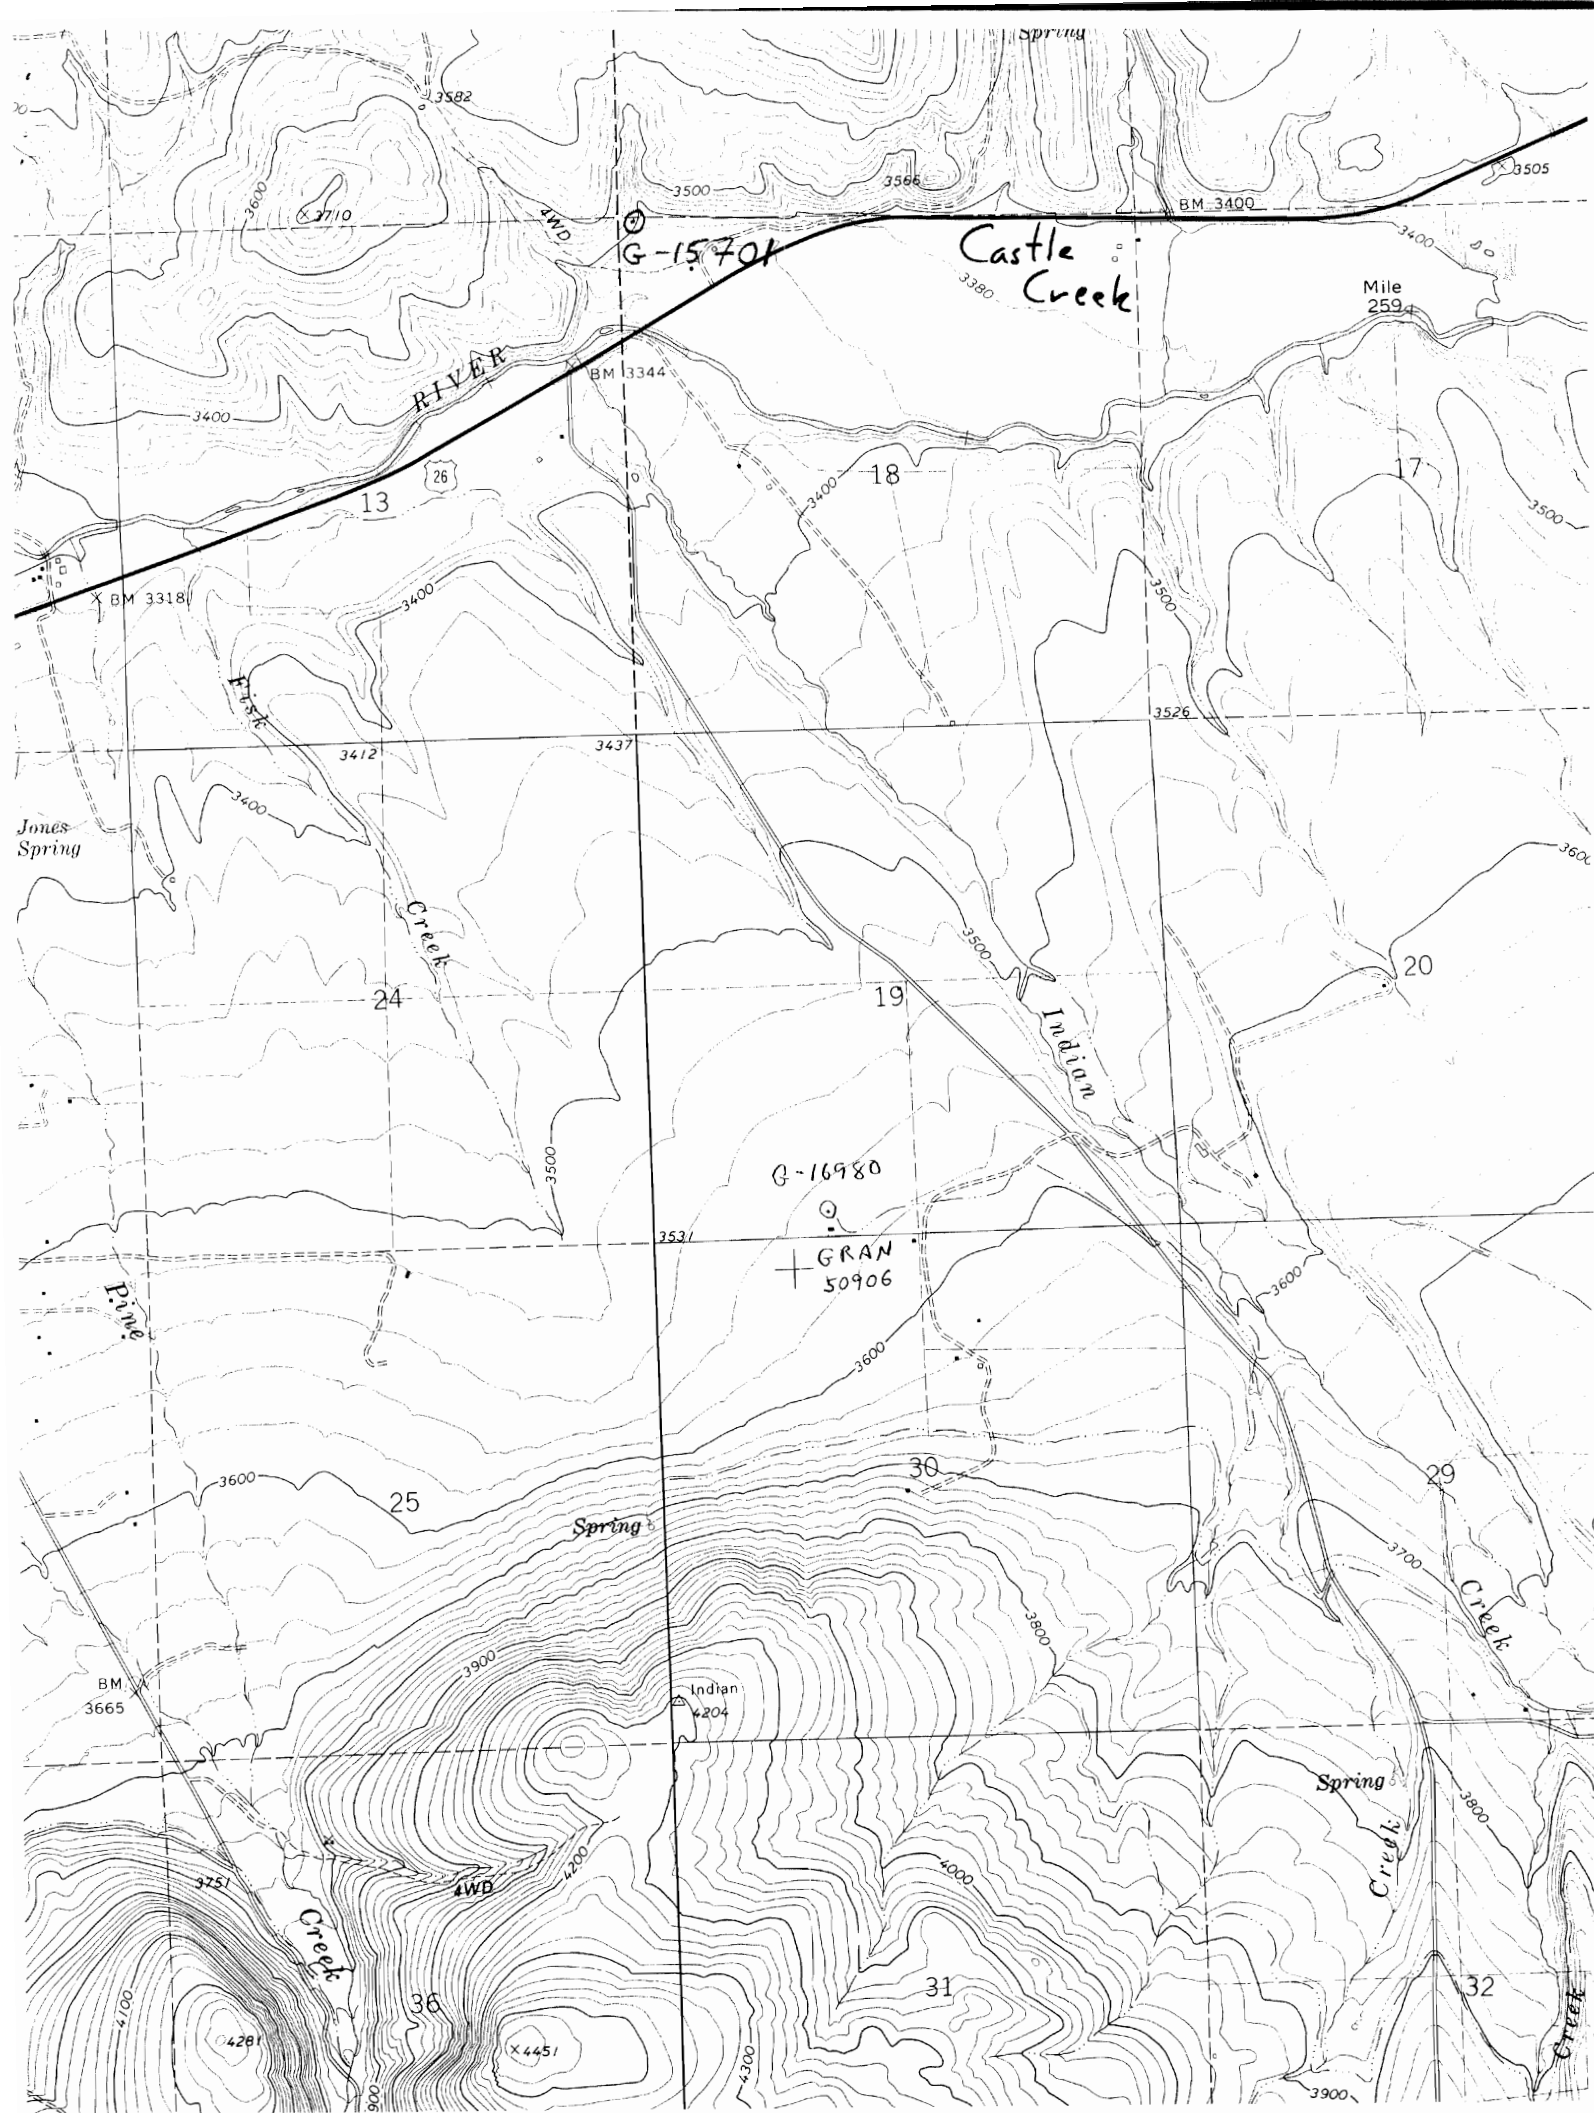

OREGON WATER RESOURCES
DEPARTMENT

WATERMASTER DISTRICT 4

FACSIMILE TRANSMITTAL SHEET

TO:

Herb Mosgar

FROM:

Eric Johnson

COMPANY:

OWRD

DATE:

12/11/2007

FAX NUMBER:

503-986-0901

TOTAL NO. OF PAGES INCLUDING COVER:

(2)

PHONE NUMBER:

SENDER'S REFERENCE NUMBER:

RE:

Sam McDaniel GW. Application

YOUR REFERENCE NUMBER:

☐ URGENT

FOR REVIEW

☐ PLEASE COMMENT☐ PLEASE REPLY☐ PLEASE RECYCLE

NOTES/COMMENTS:

Herb,

Here is a copy of the revisions I made to Mr. McDaniel's Map. I have a message left for him on his home phone to call me to "OK" the changes to the Map. Once I get his "OK" + have him sign the map I'll get a copy in to you ASAP. Until then here is a copy to use with the application once it arrives, please call if you have any questions.

Thanks
[Signature]


201 SOUTH HUMBOLT STREET, STE 180

CANYON CITY, OREGON 97820


PH# (541) 575-0119

FAX# (541) 575-0641

Application Map For Sam McDaniel T. 13S R. 33E W.M. Section 19

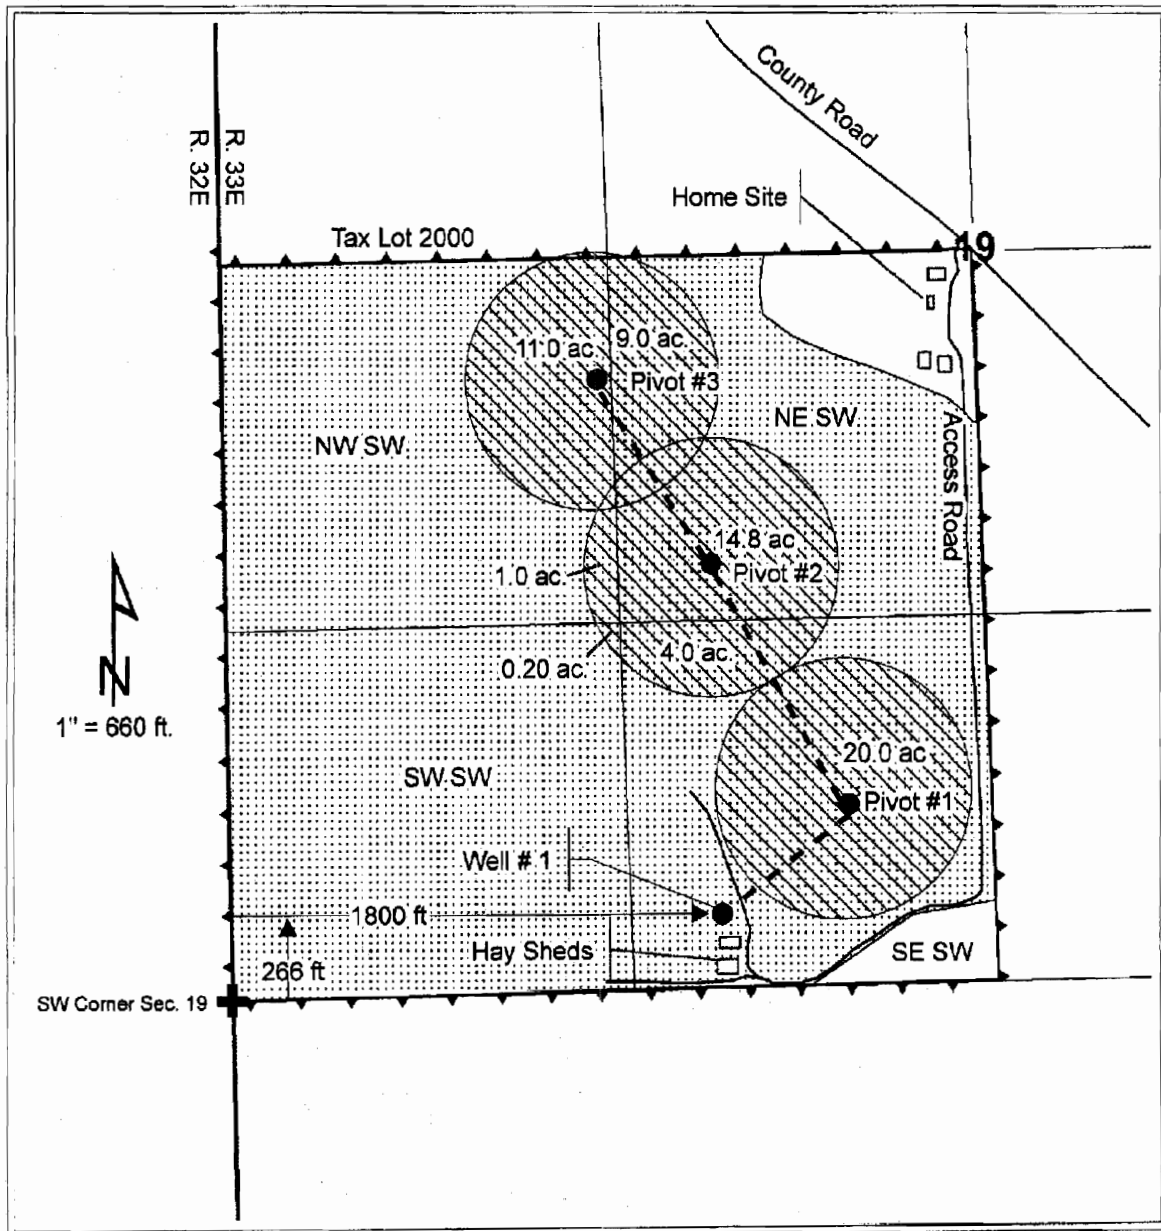


Well Location: 1800 ft E, 266 ft. N of the SW corner of Section 19 of T. 13S R. 33E W.M.
Approximate Latitude / Longitude Well Location is 118 deg 47' 29.763" W X 44 deg 25' 5.262" N

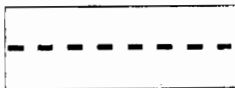

Mainline



Proposed Supplemental Irrigation totalling 60 acres +/-

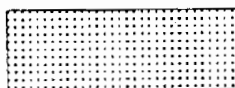

C-68489 Place of Use



Tax Lot 2000 Boundary