



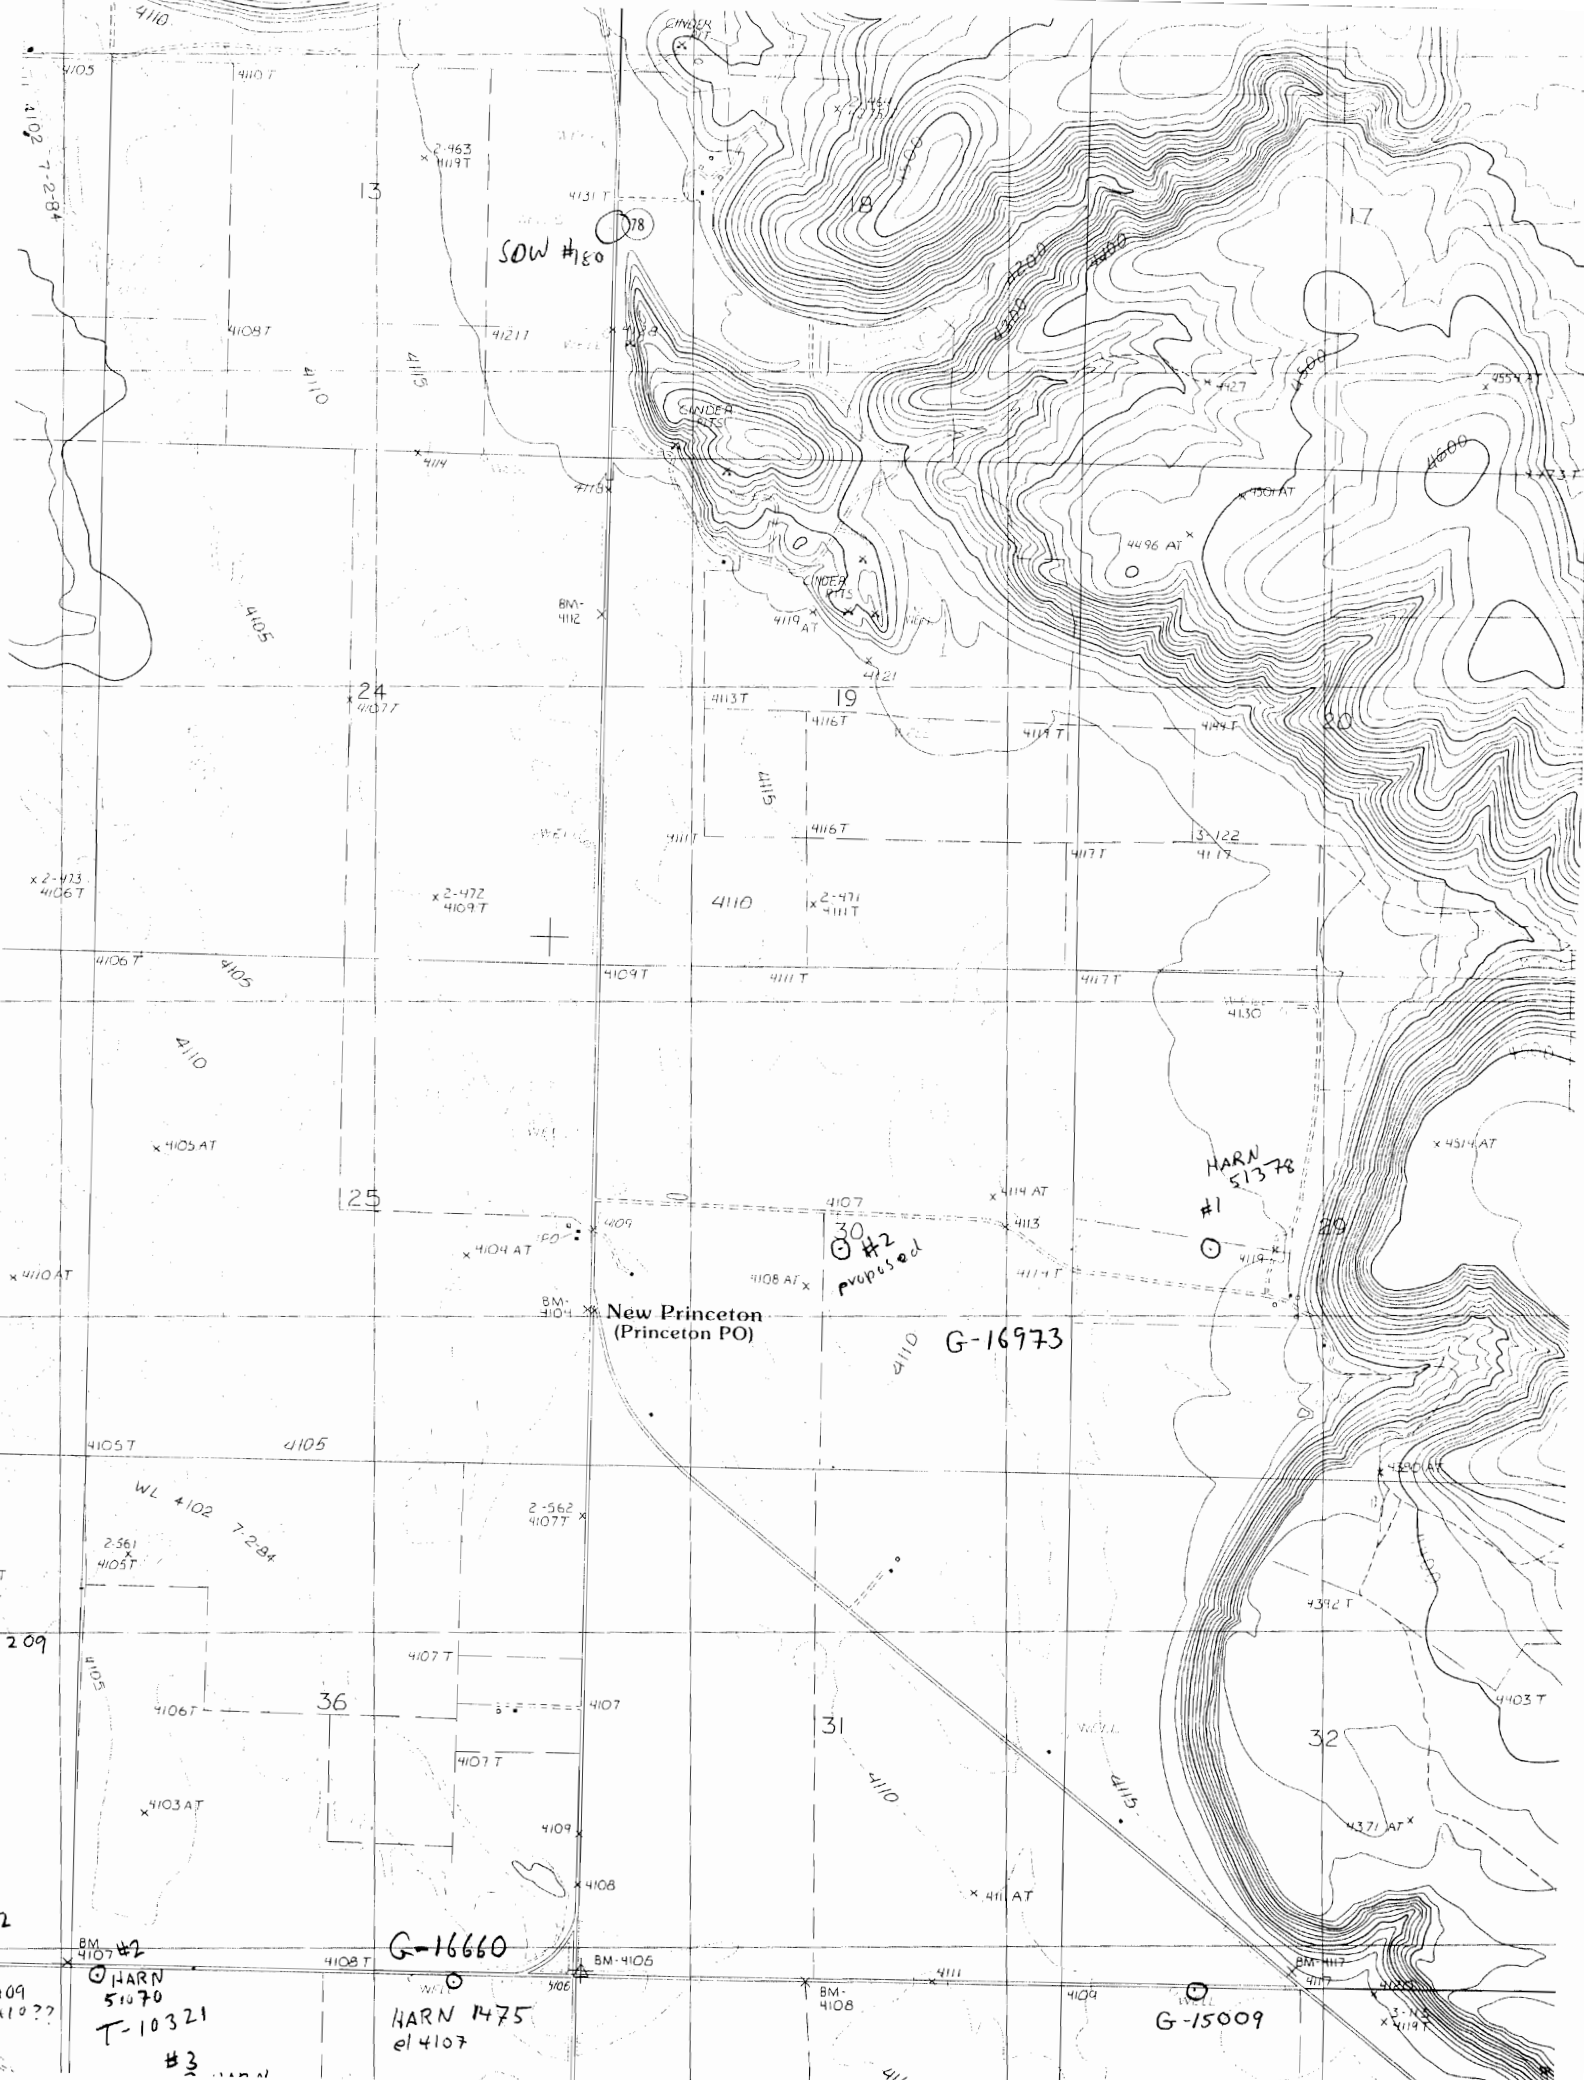

T 26 S, R 34 E, WM

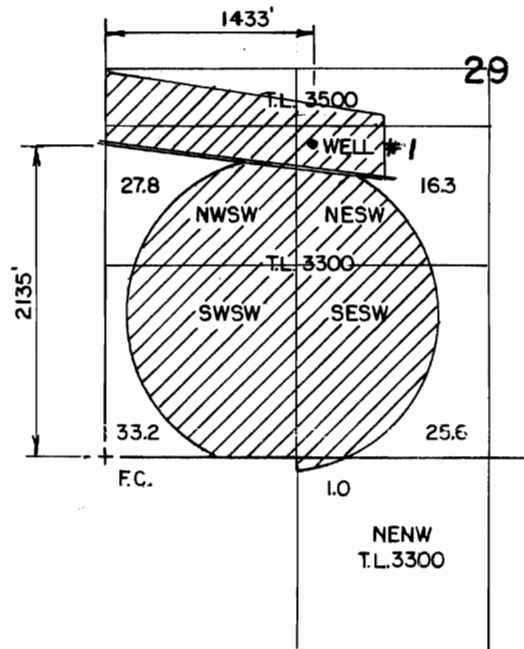

THE PURPOSE OF THIS MAP IS TO IDENTIFY THE LOCATION OF THE WATER RIGHT. IT IS NOT INTENDED TO PROVIDE INFORMATION RELATIVE TO THE LOCATION OF PROPERTY OWNERSHIP.

32

RECEIVED

NOV 30 2007

ZACH SWORD

WATER RESOURCES DEPT
SALEM, OREGON

WATER RIGHT APPLICATION MAP

Scale: 4" = 1 MILE

Date: JUNE 2007

Job: 2435

Dsn:

Drn: CHRIS


Ckd:

MAP's

M.A. PALMER & SONS, INC.
ENGINEERING & SURVEYING
711 Ponderosa Village • Box 61
Burns, Oregon 97720

Sht. No.

of 1

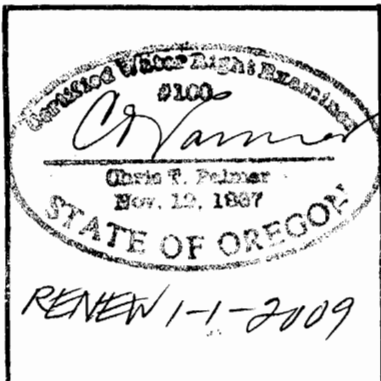

App No G-16973

SECTION PLAT

Section 30


Township 26

Range 34

County of Harney

State of OR

NORTH

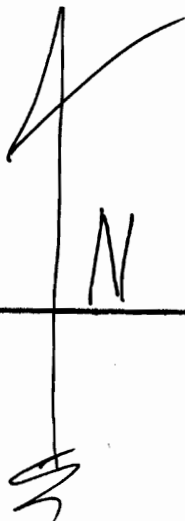

Well #2

TL 3600

40
NWSE

40
NESE

40
SWSE

40
SESE

RECEIVED

NOV 30 2007
WATER RESOURCES DEPT
SALEM, OREGON

2300'

150'

Scale: 8" = 1 mile

App No G-16973