



Oregon

Theodore R. Kulongoski, Governor

Water Resources Department

North Mall Office Building
725 Summer Street NE, Suite A
Salem, OR 97301-1271
503-986-0900
FAX 503-986-0904

ZACHARY SWORD
PO BOX 3002
PRINCETON, OR 97721

MAY 23, 2008

Reference: File G-16973

Dear Mr. Sword:

THIS IS NOT A PERMIT AND IS SUBJECT TO CHANGE AT THE NEXT PHASE OF PROCESSING.

This letter is to inform you of the preliminary analysis of your water use permit application and to describe your options. In determining whether a water use permit application may be approved, the Department must consider the factors listed below, all of which must be favorable to the proposed use if it is to be allowed. Based on the information you have supplied, the Water Resources Department has made the following preliminary determinations:

Initial Review Determinations:

1. The application proposed the use of 3.3 cubic feet per second (CFS) of water, being 1.3 CFS from well 1 (HARN 51378) and 2.0 CFS from well 2 for irrigation use on 263.9 acres from March 1 through October 31 of each year.
2. The proposed use is not prohibited by law or rule except where otherwise noted below.
3. The use of water from well 1 (HARN 51378) and well 2 in Malheur Lake Basin for irrigation use is allowable under the Malheur Lake Basin Program.
4. If properly conditioned, the proposed use of ground water will avoid injury to existing ground water rights and the resource.

The Department has determined, based upon OAR 690-09, that the proposed ground water use will not have the potential for substantial interference with any surface water source.

Summary of Initial Determinations

The use of 3.30 CFS of water, being 1.3 CFS from well 1 (HARN 51378) and 2.0 CFS from well 2 in Malheur Lake Basin for irrigation use on 263.9 acres is allowable during the full period requested, March 1 through October 31.

Because of these favorable determinations, the Department can now move your application to the next phase of the water rights application review process. This phase is where public interest factors will be evaluated.

Please reference the application number when sending any correspondence regarding the conclusions of this initial review. Comments received within the comment period will be evaluated at the next phase of the process.

To Proceed With Your Application:

If you choose to proceed with your application, you do not have to notify the Department. Your application will automatically be placed on the Department's Public Notice to allow others the opportunity to comment. After the comment period the Department will complete a public interest review and issue a proposed final order.

Withdrawal Refunds:

If you choose not to proceed, you may withdraw your application and receive a refund (minus a \$150 processing charge per application.) To accomplish this you must notify the Department in writing by **Friday, June 6, 2008**. For your convenience you may use the enclosed "STOP PROCESSING" form.

If A Permit Is Issued It Will Likely Include The Following Conditions:

1. Measurement, recording and reporting conditions:
 - A. Before water use may begin under this permit, the permittee shall install a totalizing flow meter or other suitable measuring device as approved by the Director at each point of appropriation. The permittee shall maintain the meter or measuring device in good working order, shall keep a complete record of the amount of water used each month, and shall submit a report which includes the recorded water use measurements to the Department annually or more frequently as may be required by the Director. Further, the Director may require the permittee to report general water-use information, including the place and nature of use of water under the permit.
 - B. The permittee shall allow the watermaster access to the meter or measuring device; provided however, where the meter or measuring device is located within a private structure, the watermaster shall request access upon reasonable notice.
2. The Department requires the water user to obtain, from a qualified individual (see below), and report annual static water levels for each well on the permit. The static water level

shall be measured in the month of March. Reports shall be submitted to the Department within 30 days of measurement.

The permittee shall report an initial March static water-level measurement once well construction is complete and annual measurements thereafter. Annual measurements are required whether or not the well is used. The first annual measurement will establish a reference level against which future measurements will be compared. However, the Director may establish the reference level based on an analysis of other water-level data. The Director may require the user to obtain and report additional water levels each year if more data are needed to evaluate the aquifer system.

All measurements shall be made by a certified water rights examiner, registered professional geologist, registered professional engineer, licensed well constructor or pump installer licensed by the Construction Contractors Board. Measurements shall be submitted on forms provided by, or specified by, the Department. Measurements shall be made with equipment that is accurate to at least the standards specified in OAR 690-217-0045. The Department requires the individual performing the measurement to:

- A. Associate each measurement with an owner's well name or number and a Department well log ID; and
- B. Report water levels to at least the nearest tenth of a foot as depth-to-water below ground surface; and
- C. Specify the method of measurement; and
- D. Certify the accuracy of all measurements and calculations reported to the Department.

The water user shall discontinue use of, or reduce the rate or volume of withdrawal from, the well(s) if any of the following events occur:

- A. Annual water-level measurements reveal an average water-level decline of three or more feet per year for five consecutive years; or
- B. Annual water-level measurements reveal a water-level decline of 15 or more feet in fewer than five consecutive years; or
- C. Annual water-level measurements reveal a water-level decline of 25 or more feet; or
- D. Hydraulic interference leads to a decline of 25 or more feet in any neighboring well with senior priority.

The period of restricted use shall continue until the water level rises above the decline level which triggered the action or the Department determines, based on the permittee's and/or the Department's data and analysis, that no action is necessary because the aquifer in question can sustain the observed declines without adversely impacting the resource or causing substantial interference with senior water rights. The water user shall not allow

excessive decline, as defined in Commission rules, to occur within the aquifer as a result of use under this permit. If more than one well is involved, the water user may submit an alternative measurement and reporting plan for review and approval by the Department.

The water source identified in your application may be affected by an Agricultural Water Quality Management Area Plan. These plans are developed by the Oregon Department of Agriculture (ODA) with the cooperation of local landowners and other interested stakeholders, and help to ensure that current and new appropriations of water are done in a way that does not adversely harm the environment. You are encouraged to explore ODA's Water Quality Program web site at http://www.oregon.gov/ODA/NRD/water_agplans.shtml to learn more about the plans and how they may affect your proposed water use.

If you have any questions:

Feel free to call me at 503-986-0808 if you have any questions regarding the contents of this letter or your application. Please have your application number available if you call. General questions about water rights and water use permits should be directed to our customer service staff at 503-986-0801. When corresponding by mail, please use this address: Brook Geffen, Oregon Water Resources Department, 725 Summer St NE Ste A, Salem OR 97301-1266. Our fax number is 503-986-0901.

Sincerely,



Brook Geffen
Water Right Application Caseworker

enclosures: Application Process Description and Stop Processing Request Form

G-16973
WAB 12-NA
POU 12-NA
GW

APPLICATION FACT SHEET

Application File Number: G-16973

Applicant: ZACHARY SWORD

County: HARNEY

Watermaster: 10

Priority Date: NOVEMBER 30, 2007

Source: WELL 1 (HARN 51378) AND WELL 2 IN MALHEUR LAKE BASIN

Use: IRRIGATION USE ON 263.9 ACRES

Quantity: 3.30 CUBIC FEET PER SECOND (CFS), BEING 1.3 CFS FROM WELL 1 AND 3.0 CFS FROM WELL 2

Basin Name & Number: Malheur Lake, #12

Stream Index Reference: Volume 2 MALHEUR L & MISC

Well Locations:

WELL 1 (HARN 51378): NESW, SECTION 29, T26S, R34E, W.M.; 2135 FEET NORTH
AND 1433 FEET EAST FROM SW CORNER, SECTION 29

WELL 2: NWSE, SECTION 30, T26S, R34E, W.M.; 2300 FEET NORTH
AND 150 FEET EAST FROM S1/4 CORNER, SECTION 30

Place of Use:

NE ¼ SW ¼ 16.3 ACRES
NW ¼ SW ¼ 27.8 ACRES
SW ¼ SW ¼ 33.2 ACRES
SE ¼ SW ¼ 25.6 ACRES
SECTION 29

NE ¼ SE ¼ 40.0 ACRES
NW ¼ SE ¼ 40.0 ACRES
SW ¼ SE ¼ 40.0 ACRES
SE ¼ SE ¼ 40.0 ACRES
SECTION 30



NE $\frac{1}{4}$ NW $\frac{1}{4}$ 1.0 ACRE
SECTION 32
TOWNSHIP 26 SOUTH, RANGE 34 EAST, W.M.

14 DAY STOP PROCESSING DEADLINE DATE: Friday, June 6, 2008

PUBLIC NOTICE DATE: Tuesday, May 27, 2008

30 DAY COMMENT DEADLINE DATE: Thursday, June 26, 2008

T 26 S, R 34 E, WM

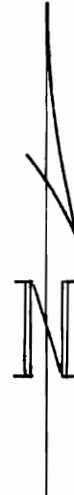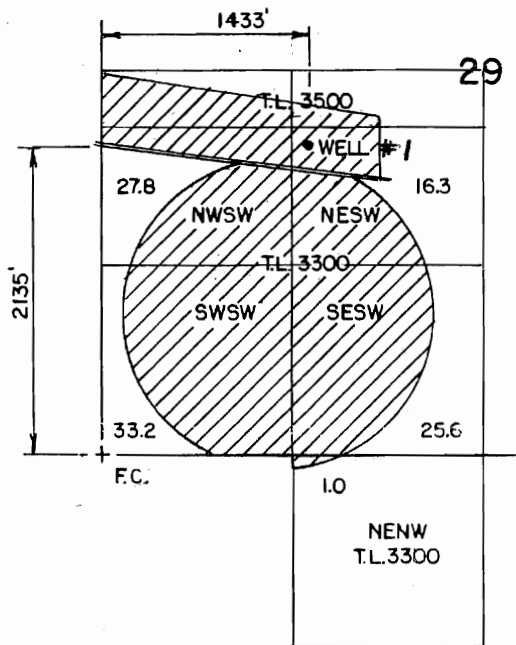

THE PURPOSE OF THIS MAP IS TO IDENTIFY THE LOCATION OF THE WATER RIGHT. IT IS NOT INTENDED TO PROVIDE INFORMATION RELATIVE TO THE LOCATION OF PROPERTY OWNERSHIP.

32


RECEIVED

NOV 30 2007

WATER RESOURCES DEPT
SALEM, OREGON

ZACH SWORD

WATER RIGHT APPLICATION MAP

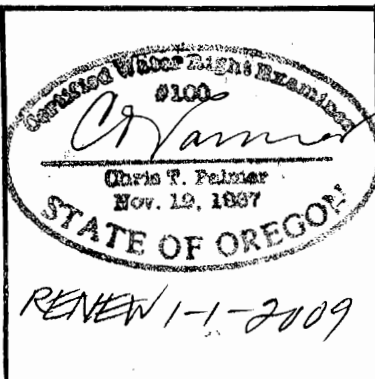

Scale: 4" = 1 MILE

Date: JUNE 2007

Job: 2435

Dsn:

Drn: CHRIS

Ckd:



M.A. PALMER & SONS, INC.
ENGINEERING & SURVEYING
711 Ponderosa Village • Box 61
Burns, Oregon 97720

Sht. No.

of 1

App No G-16973

SECTION PLAT

Section 30


Township 26

Range 34

County of Harney

State of OR

NORTH

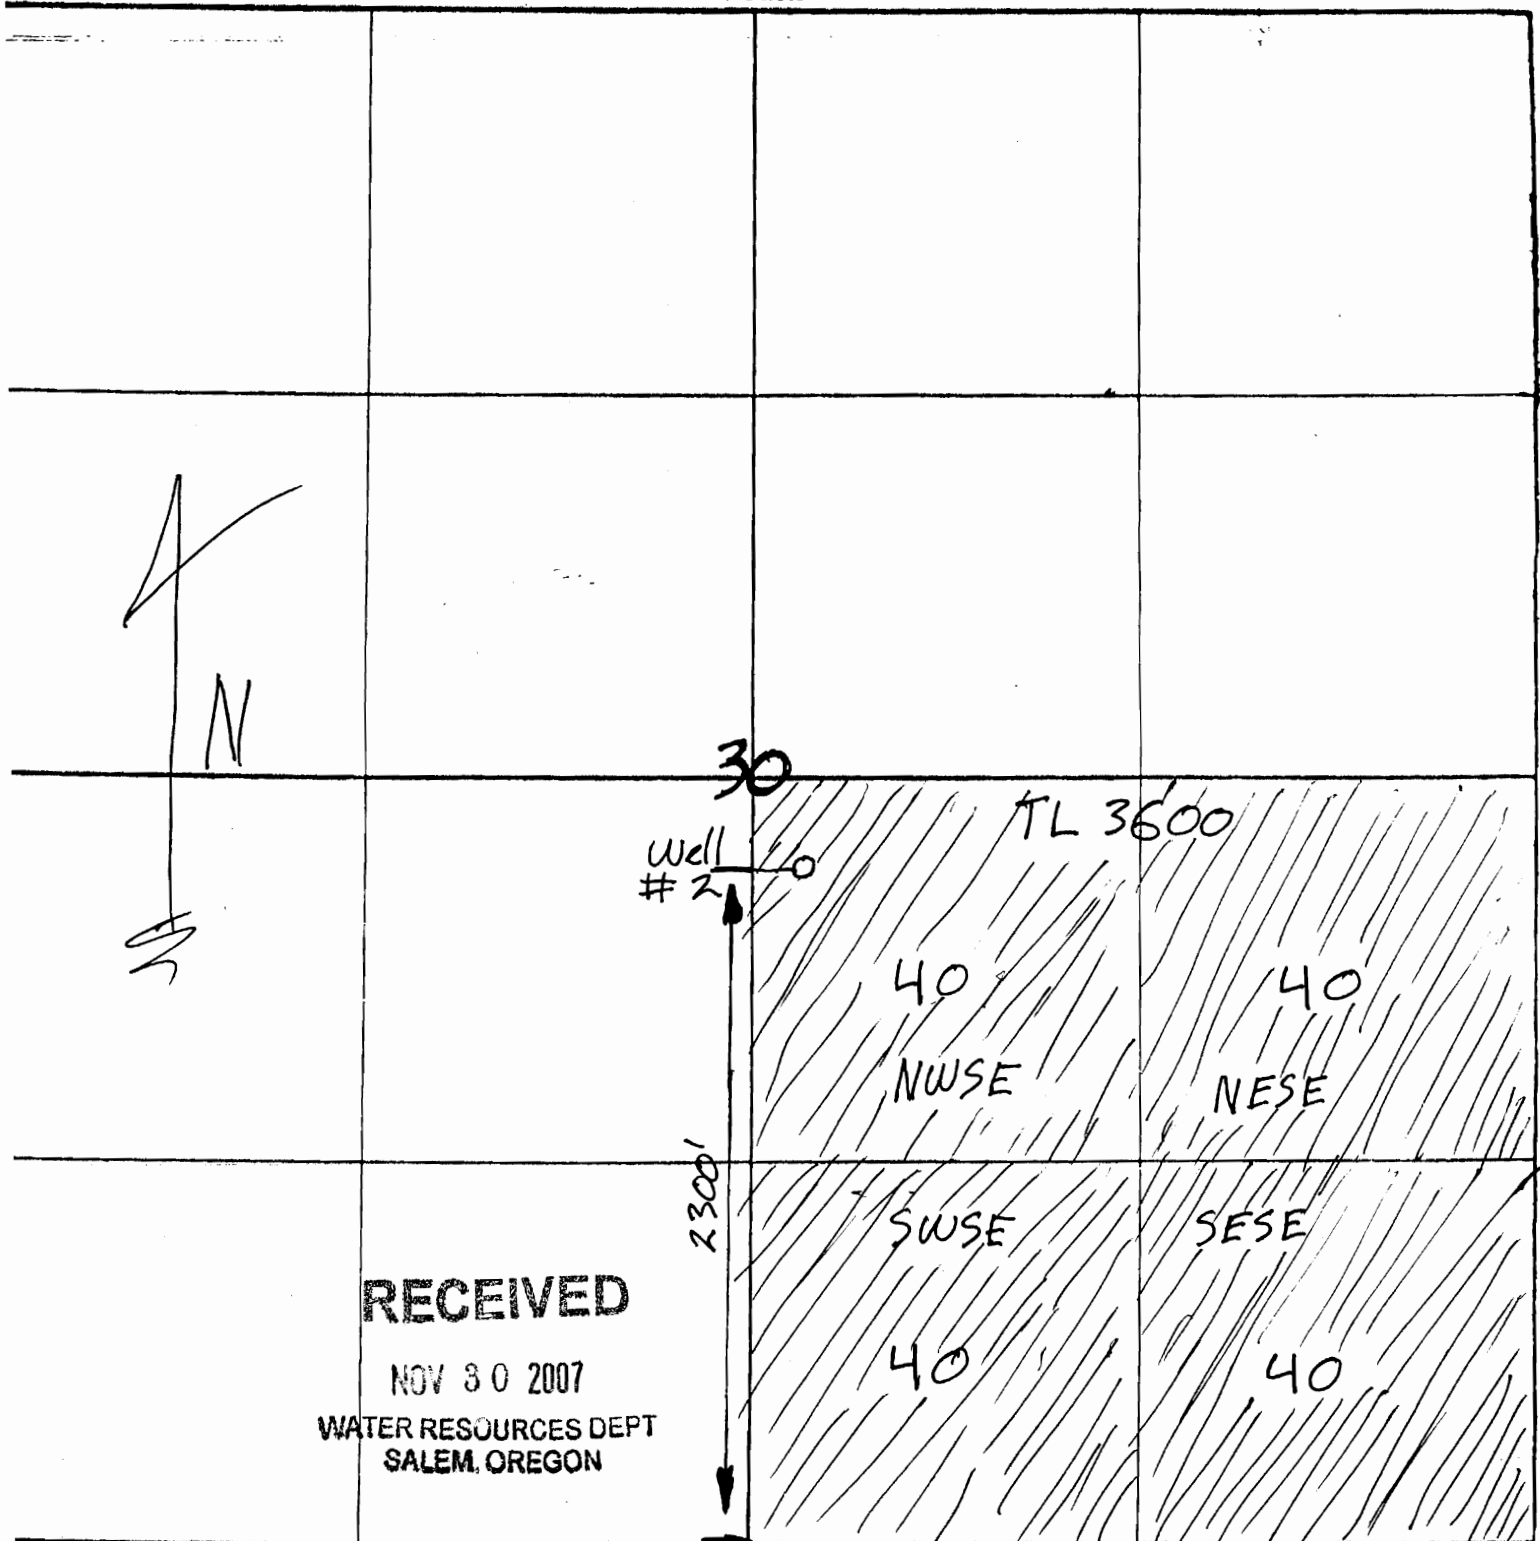

Scale: 8" = 1 mile

App No G-16973