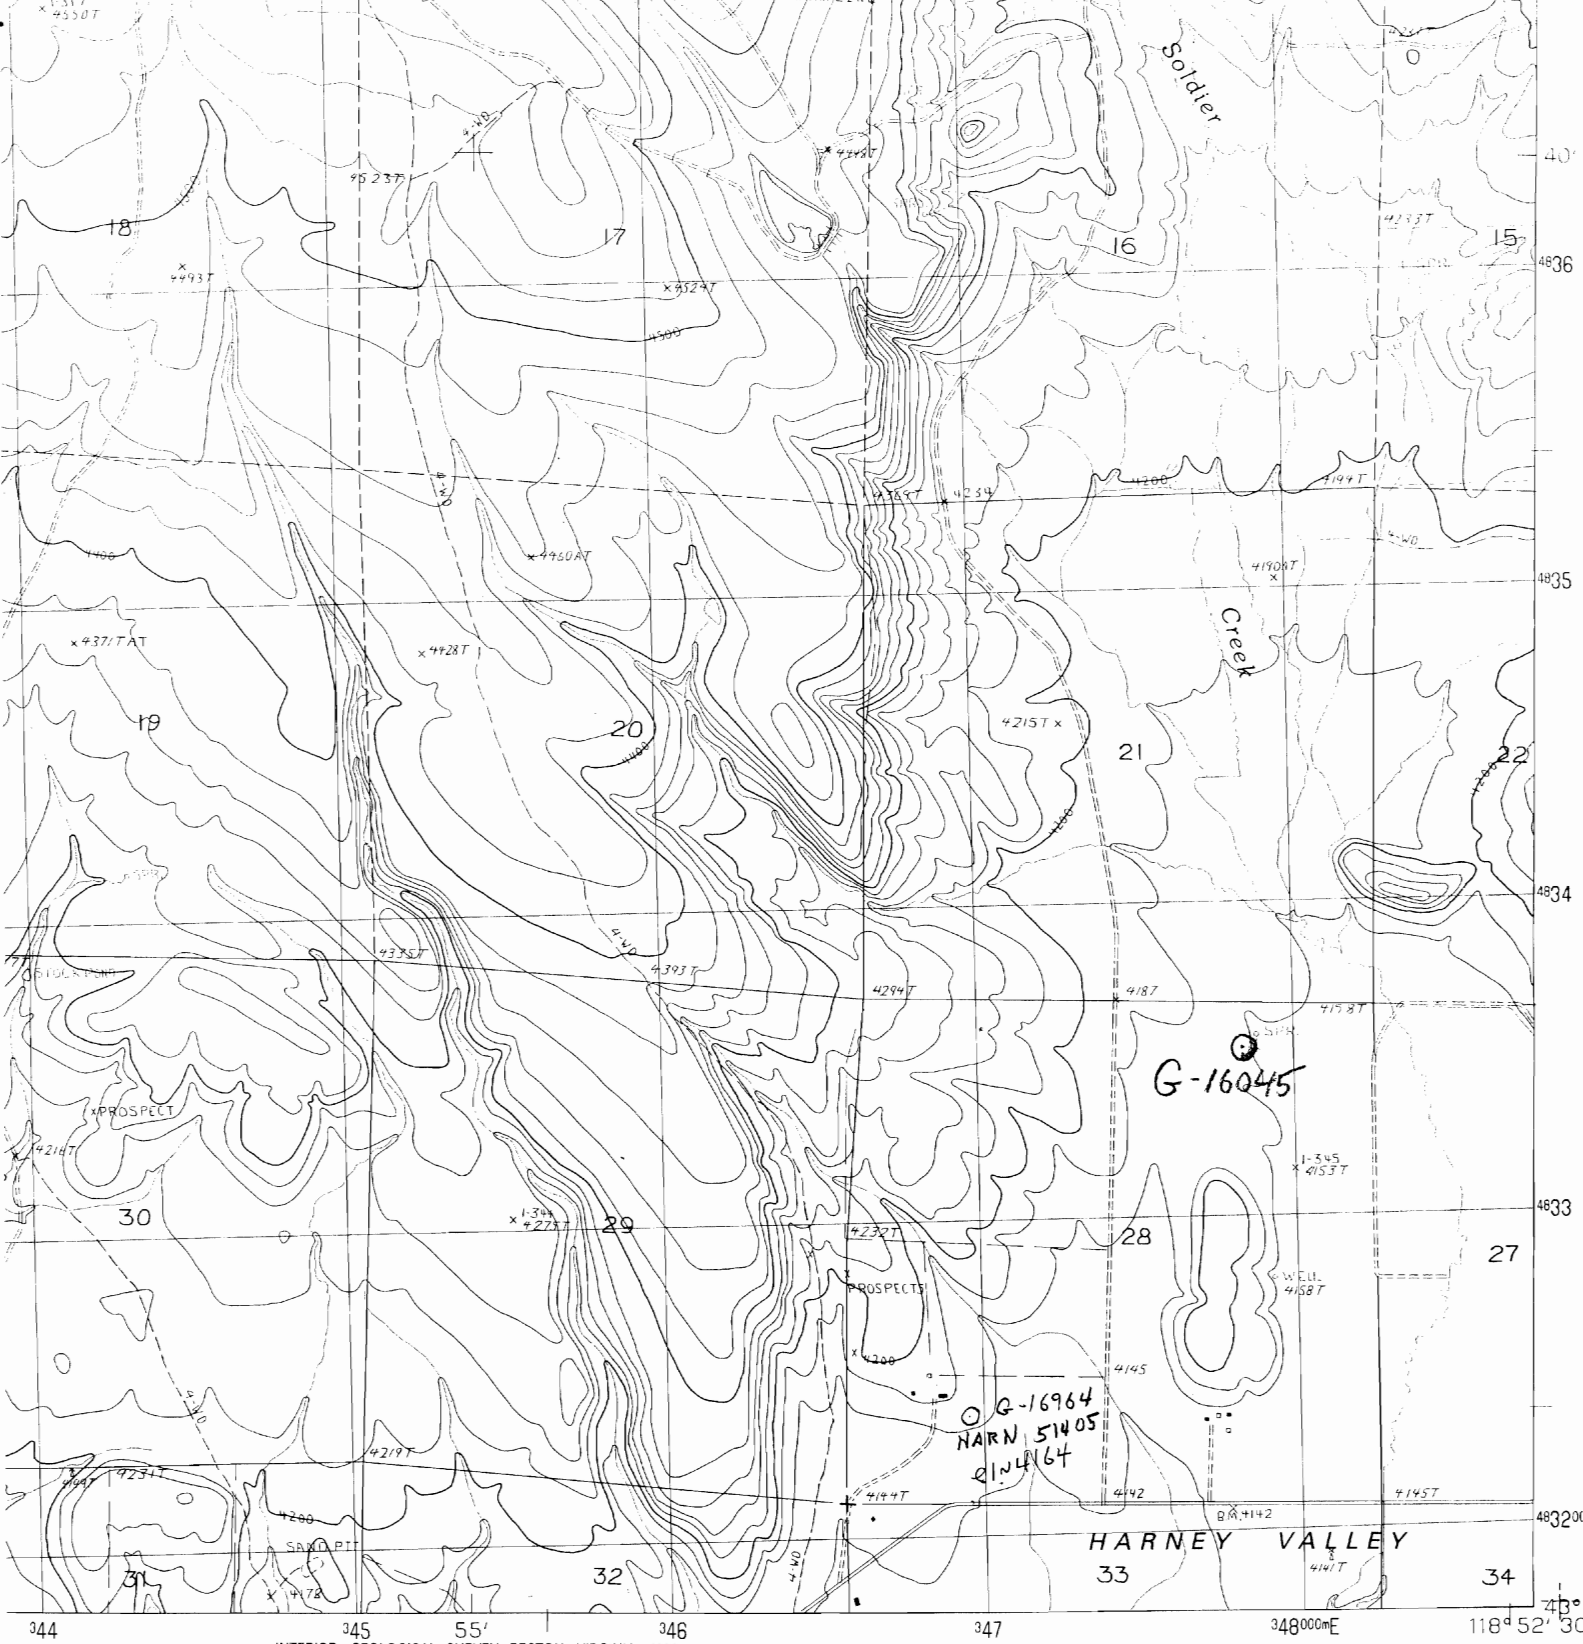


ROAD LEGEND

- Improved Road
- Unimproved Road
- Trail

- Interstate Route
- U.S. Route
- State Route

DEVINE RIDGE SOUTH, OREGON


PROVISIONAL EDITION 1990

1	2	3	1 Mosquito Flat
4		5	2 Devine Ridge North
			3 Telephone Butte
			4 Poison Creek
			5 Harney
			6 Burns
6	7	8	7 Poison Creek Slough
			8 Ninemile Slough

ACCURACY STANDARDS
SICAL SURVEY
STON VIRGINIA 22002

43118.F8 TE 024

T 22 S, R 32 E
WM

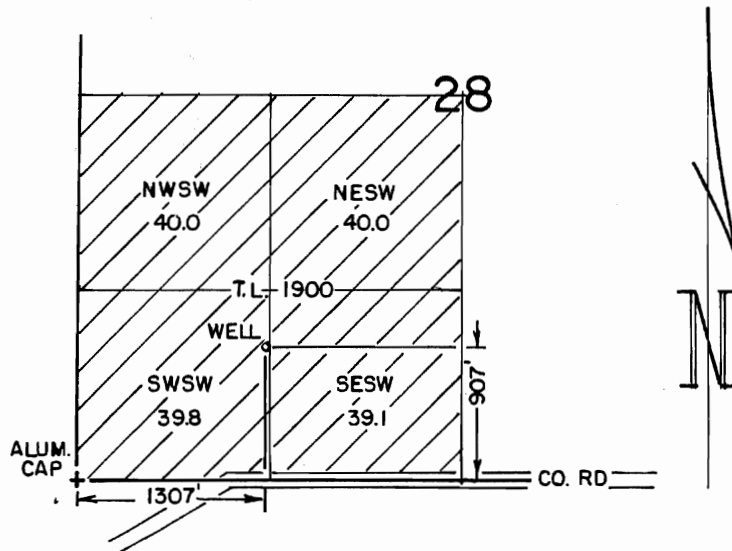

RECEIVED

NOV 19 2007

WATER RESOURCES DEPT
SALEM, OREGON

THE PURPOSE OF THIS MAP IS TO
IDENTIFY THE LOCATION OF THE
WATER RIGHT. IT IS NOT INTENDED
TO PROVIDE INFORMATION RELATIVE
TO THE LOCATION OF PROPERTY
OWNERSHIP.

App No G-16964

RENEW 1-1-2009	WILLIAM N & PATRICIA A WILBER WATER RIGHT APPLICATION MAP		
	Scale: 4" = 1 MILE	Date: OCT 2007	Job: 2457
	Dsn:	M.A. PALMER & SONS, INC. ENGINEERING & SURVEYING 711 Ponderosa Village • Box 61 Burns, Oregon 97720	Sht. No.
	Drn: CHRIS		of 1
Ckd:			