


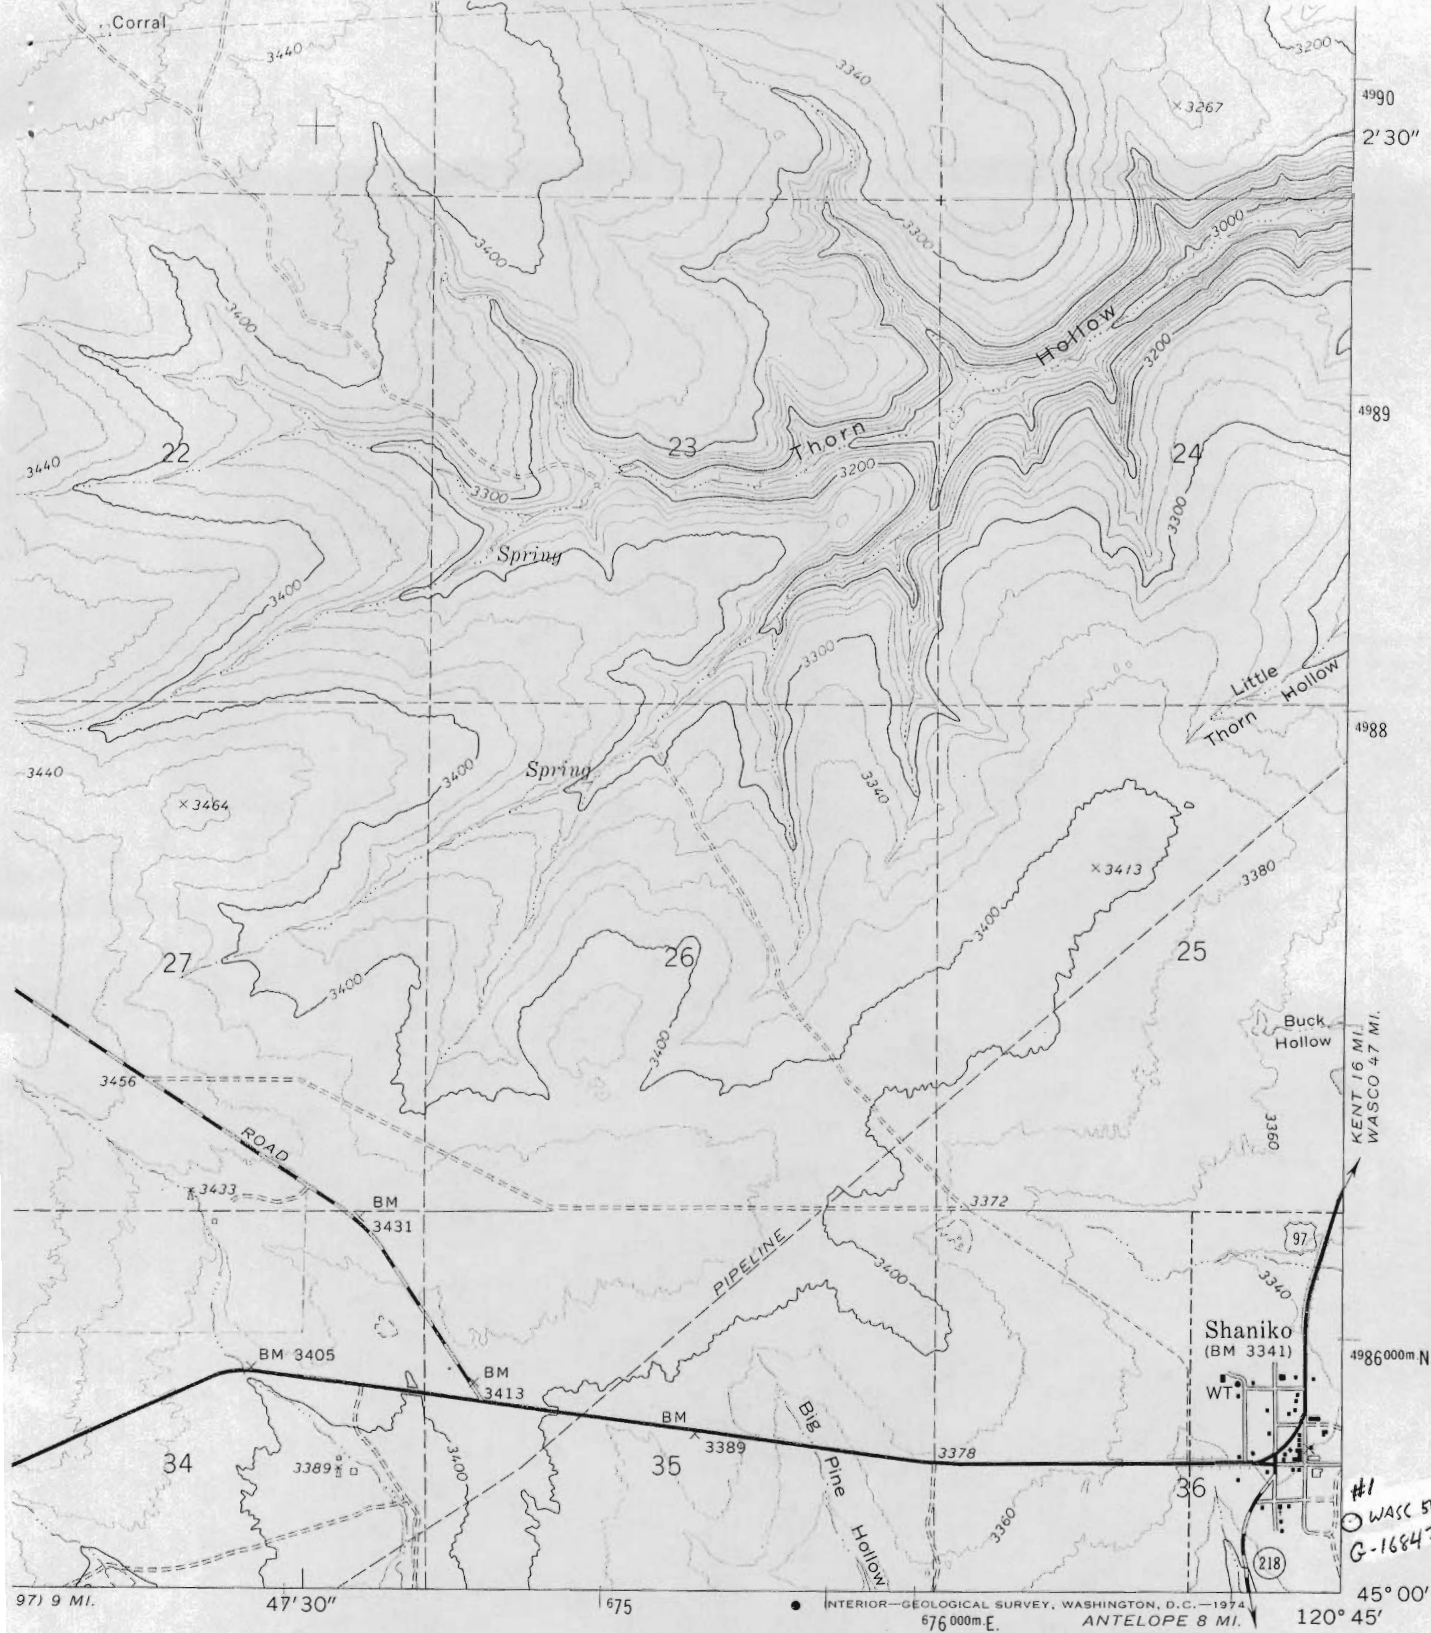

ROAD CLASSIFICATION

- | | |
|------------------------------------|--|
| Primary highway,
hard surface | Light-duty road, hard or
improved surface |
| Secondary highway,
hard surface | Unimproved road |
| ○ Interstate Route | ○ U. S. Route ○ State Route |



QUADRANGLE LOCATION

SHANIKO, OREG.
N4500-W12045/7.5

1971


AMS 1874 III SE-SERIES V892

STANDARDS
OR WASHINGTON, D. C. 20242
TABLE ON REQUEST


#1
WASCO 51536
G-16847

(ANTELOPE 1:62,500)

SHANIKO SUMMIT QUADRANGLE
OREGON—WASCO CO.
7.5 MINUTE SERIES (TOPOGRAPHIC)

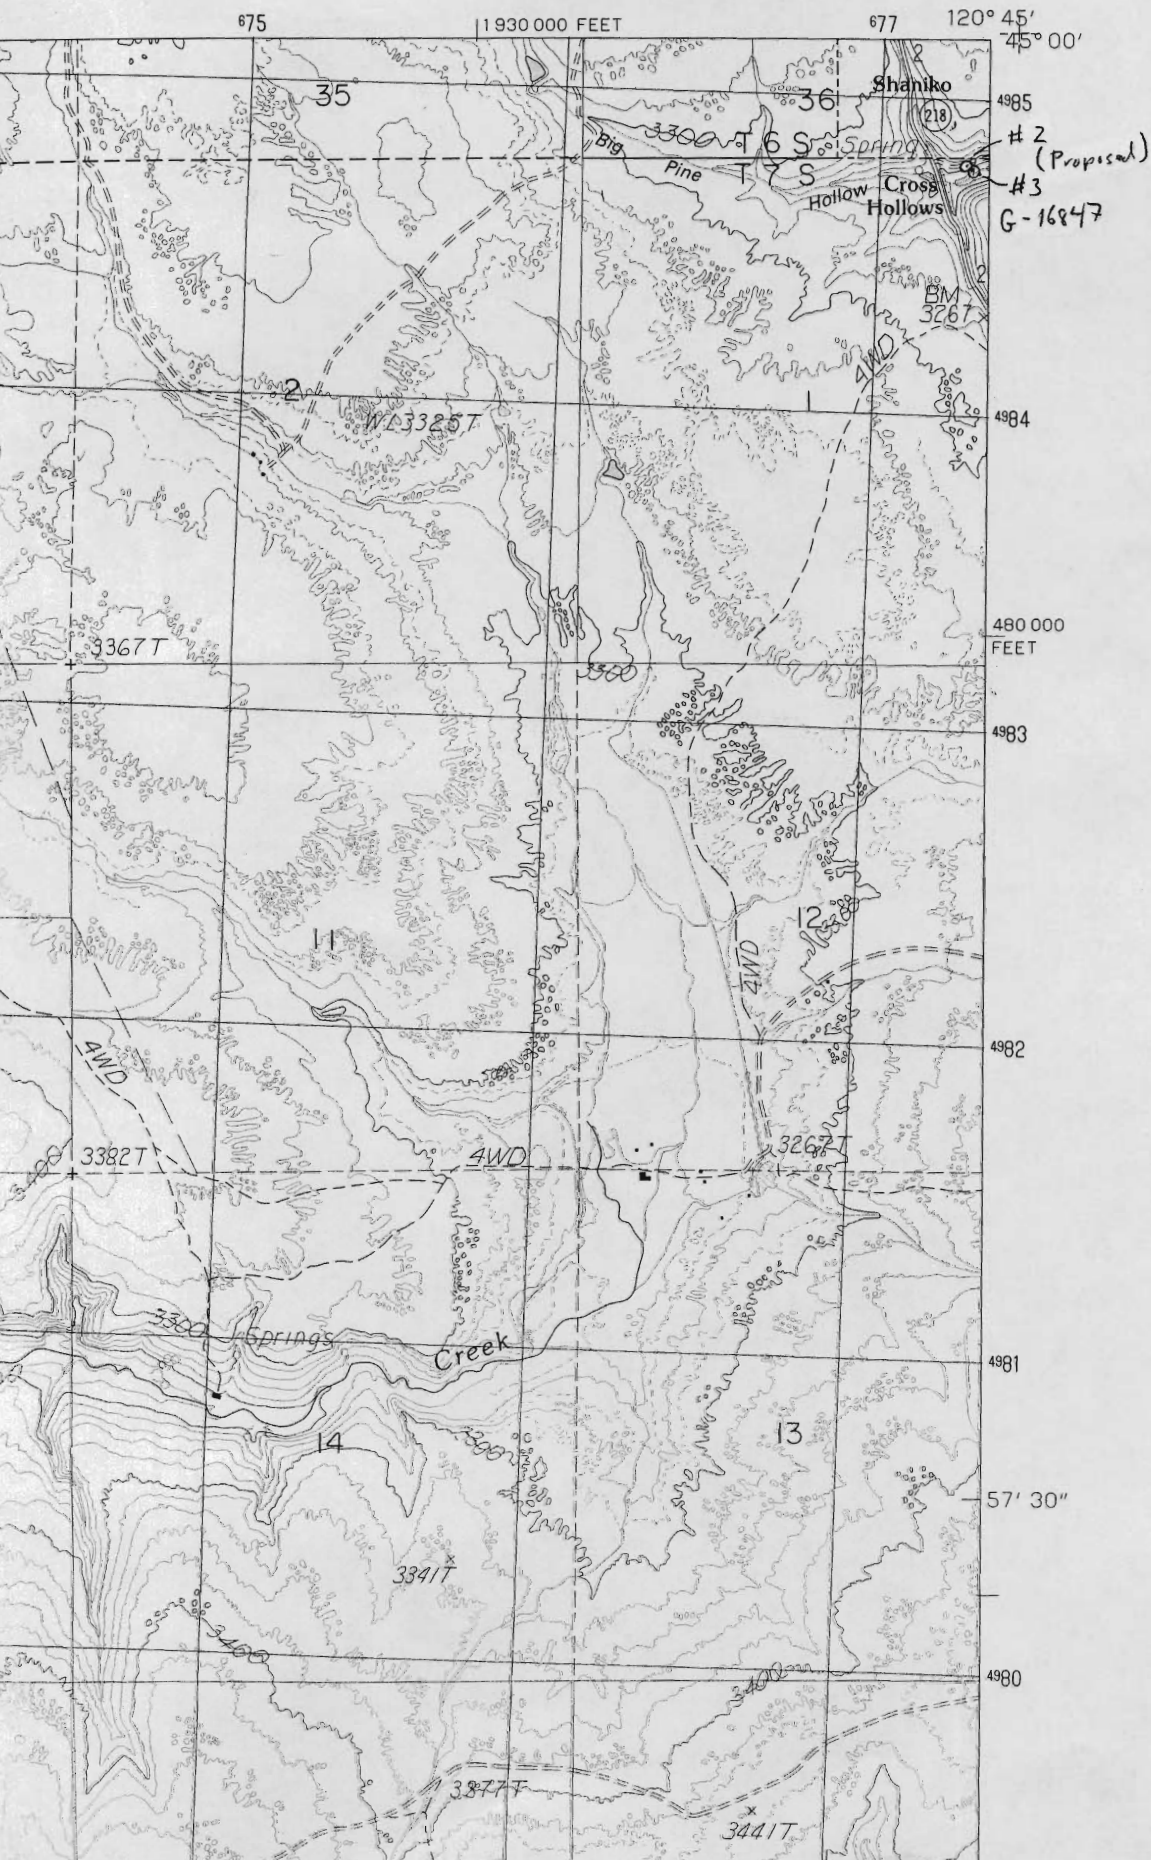

**T6S, R16E, WM, Section 36
T7S, R16E, WM, Section 1
Wasco County, Oregon**

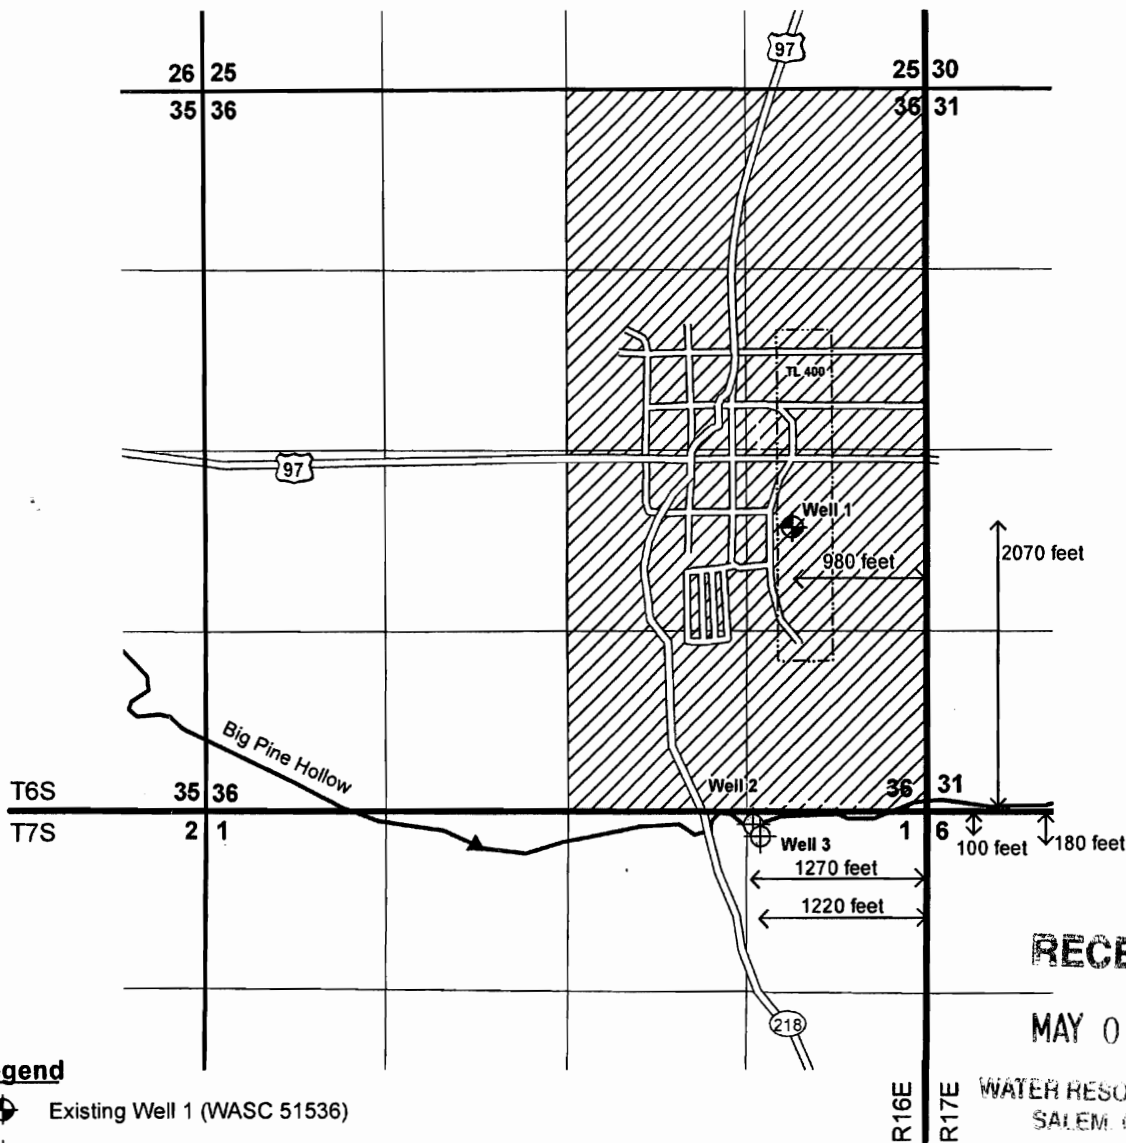

Legend

- Existing Well 1 (WASC 51536)
- Proposed Wells 2 & 3
- Tax Lot
- Proposed Place of Use
- Stream
- Road
- Township/Range
- Section
- Quarter Quarter


This map is not intended to provide legal dimensions or locations of property ownership lines.

RECEIVED

MAY 04 2007

**WATER RESOURCES DEPT
SALEM, OREGON**

1 inch = 1,320 feet

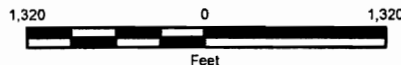

Permit Application Map

**City of Shaniko
Shaniko, Oregon**

GEOENGINEERS



Figure 1

App No G-16847