

SECTION PLAT

Section 16

Township 23 S


Range 4

County of Harney

State of Oregon

WORK COPY

NORTH

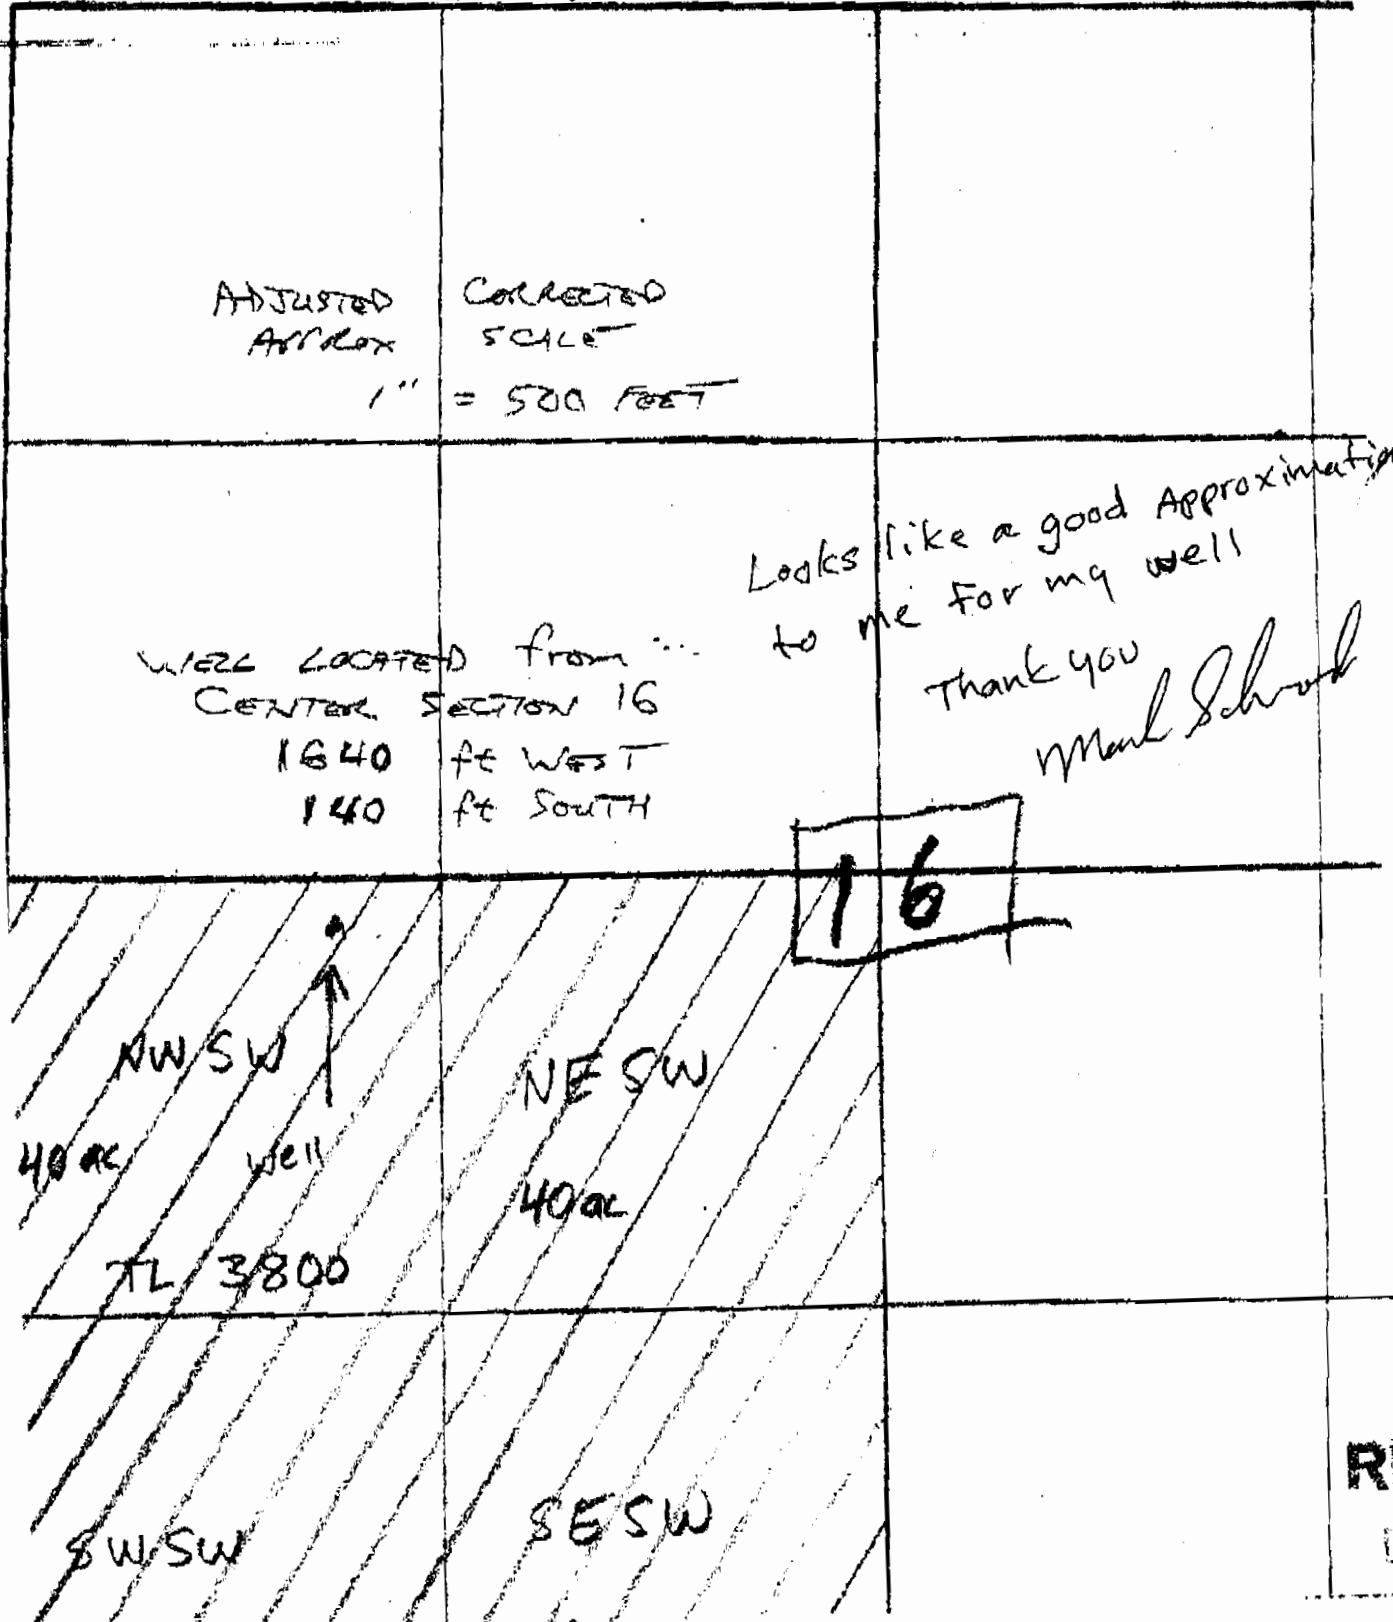

ADJUSTED APPROX

CORRECTED SCALE

1" = 500 FEET

WELL LOCATED from ...
CENTER SECTION 16
1640 ft WEST
140 ft SOUTH

Looks like a good Approximation
to me for my well
Thank you
Mark Schrod

16

NW SW
40 ac
Well
TL 3800

NE SW
40 ac

SW SW


SE SW

RI

FROM :CranecSuppy

FAX NO. :

Dec. 13 2007 04:04PM P4

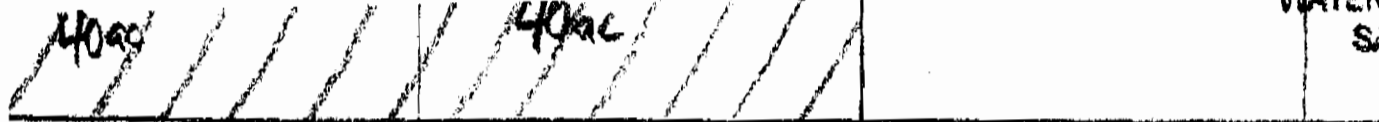

Mark Schrock
66402 Crane Buchanan Rd,
Burns OR 97720

8" = 16'

SECTION PLAT

Section 16

Township 23

Range 33

County of Harney State of Oregon

NORTH

16



NW SW
40 ac
well
TL 3800

NE SW
40 ac

SW SW
40 ac

SE SW
40 ac

RECEIVED

DEC 12 2007

WATER RESOURCES DEPT
SALEM OREGON

Mark Schrock
66402 Crane Buchanan Rd,
Burns OR 97720

8" = 1 mile

