




SECTION 12 T.24
HARNEY C

1"=400'

THIS MAP WAS PREPARED FOR
ASSESSMENT PURPOSE ONLY.

THIS SKETCH IS MADE SOLELY FOR THE PURPOSE OF ASSISTING IN LOCATING SAID PREMISE AND THE COMPANY ASSUMES NO LIABILITY FOR VARIATIONS, IF ANY, IN DIMENSIONS AND LOCATIONS ASCERTAINED BY ACTUAL SURVEY.

SEE MAP 24 33
S.L.O. N89°30'E 80.64 CH.

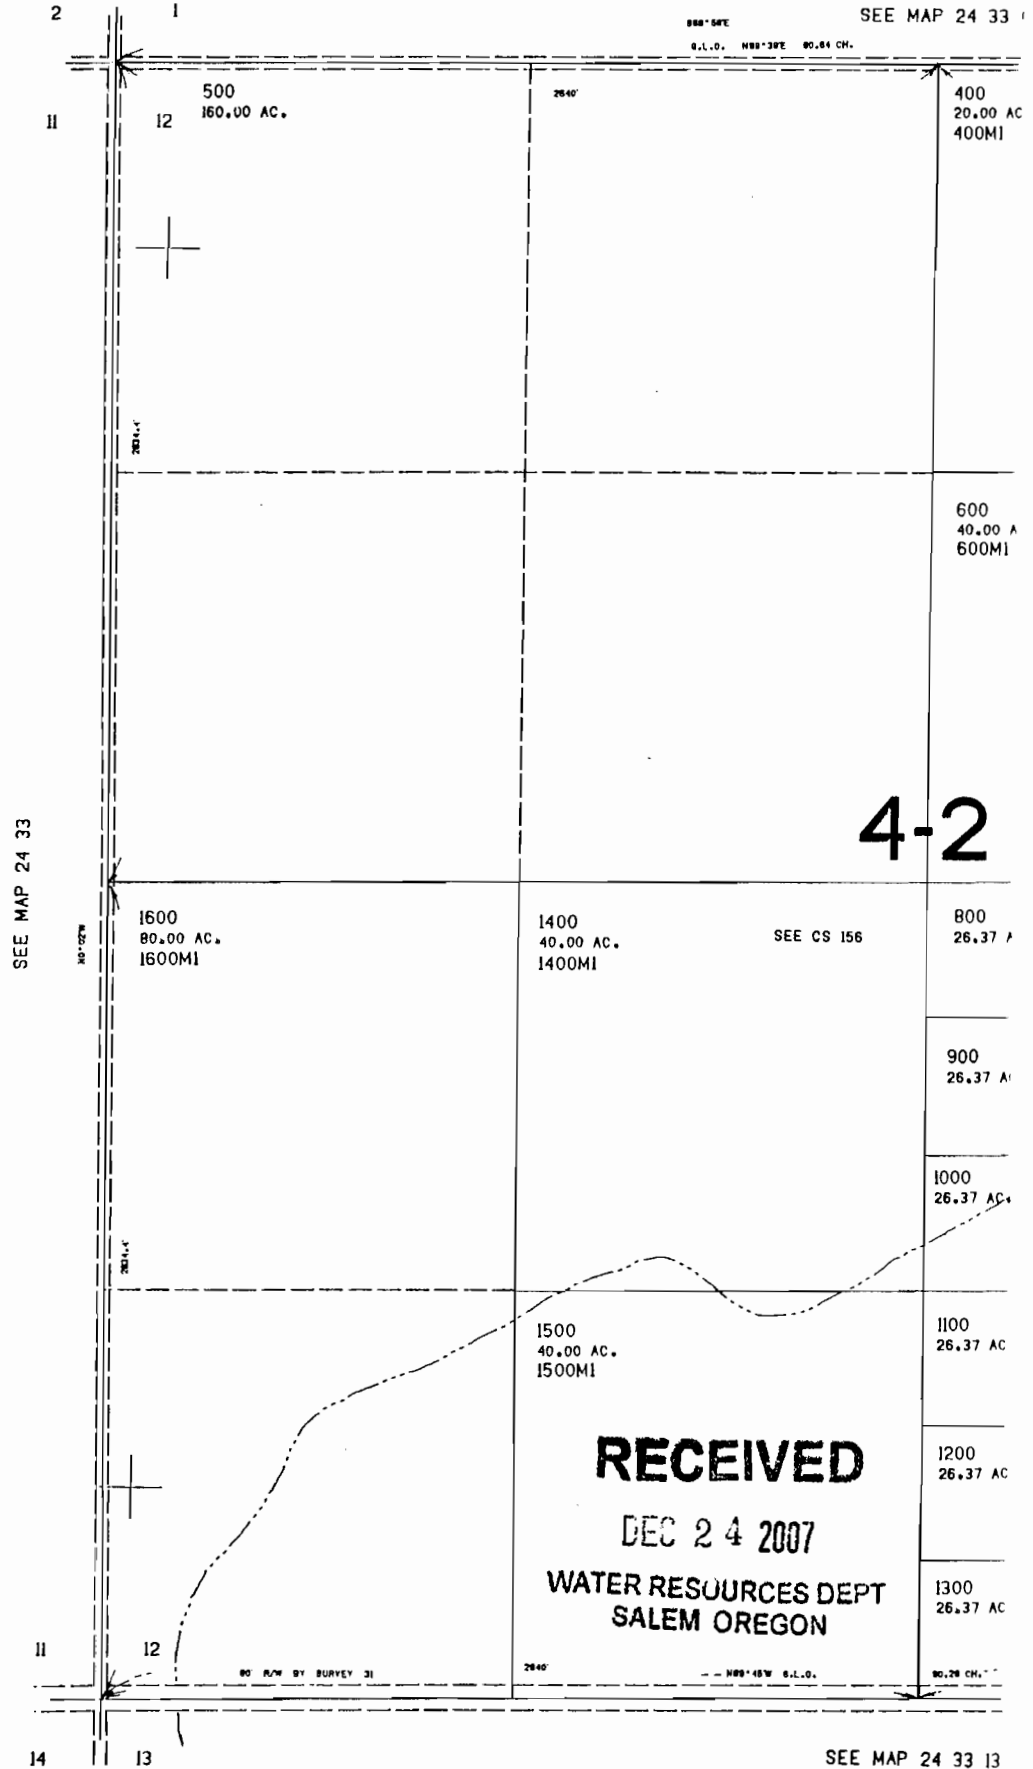

RECEIVED
DEC 24 2007
WATER RESOURCES DEPT
SALEM OREGON

SECTION PLAT

REVISED APPROX ADJUSTED SCALE

Section 12

Township 24 S


Range 33 E

1" = 600 FT.


State of OR

NORTH

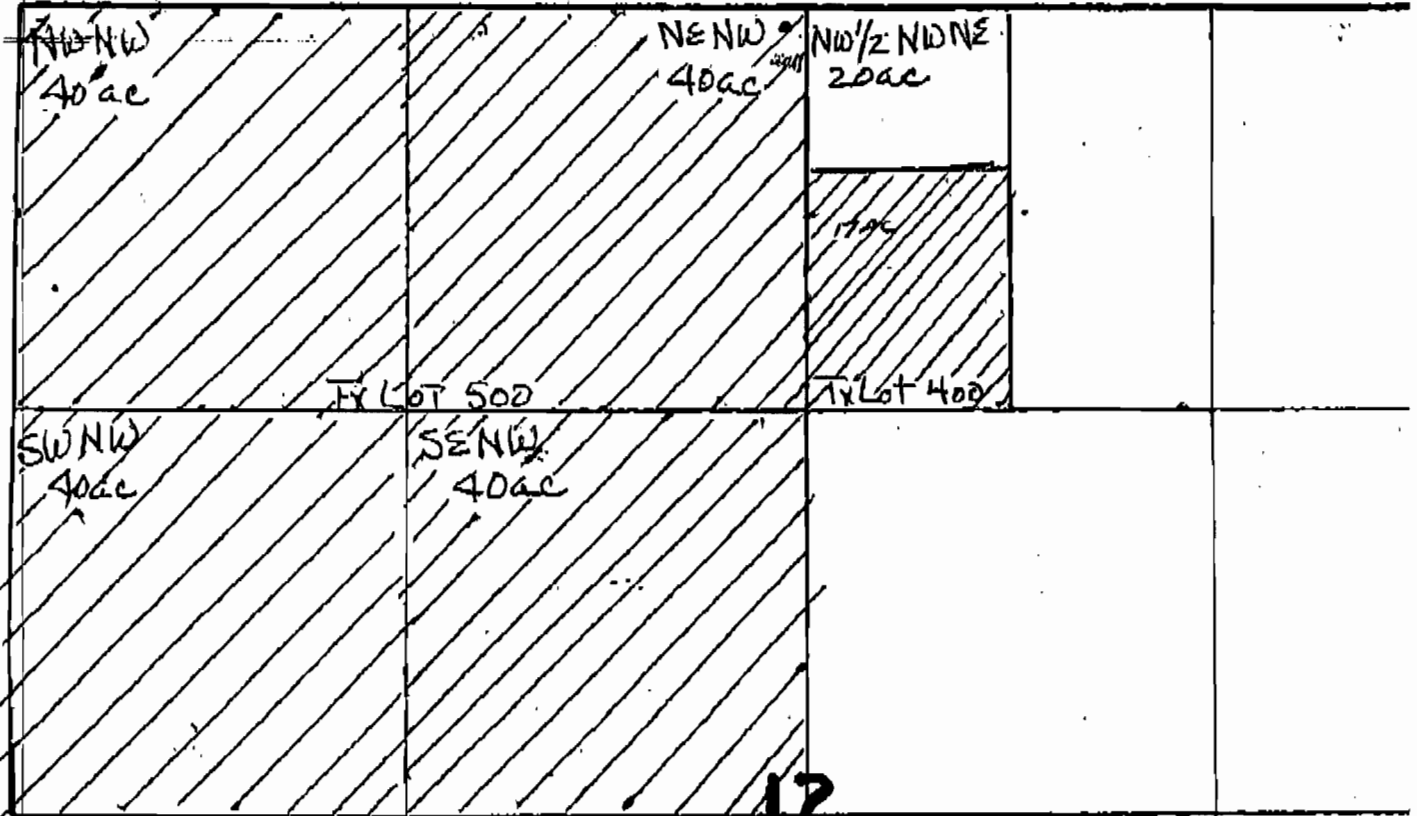

12

WELL LOCATED FROM
 CENTER SECTION 12
 2570 FE NORTH
 75 FE WEST
 12-28-07
 LWR

12-28-07
MAR

SECTION PLAT

Section 12


Township 24 S

Range 33 E


County of Harney

State of OR

NORTH

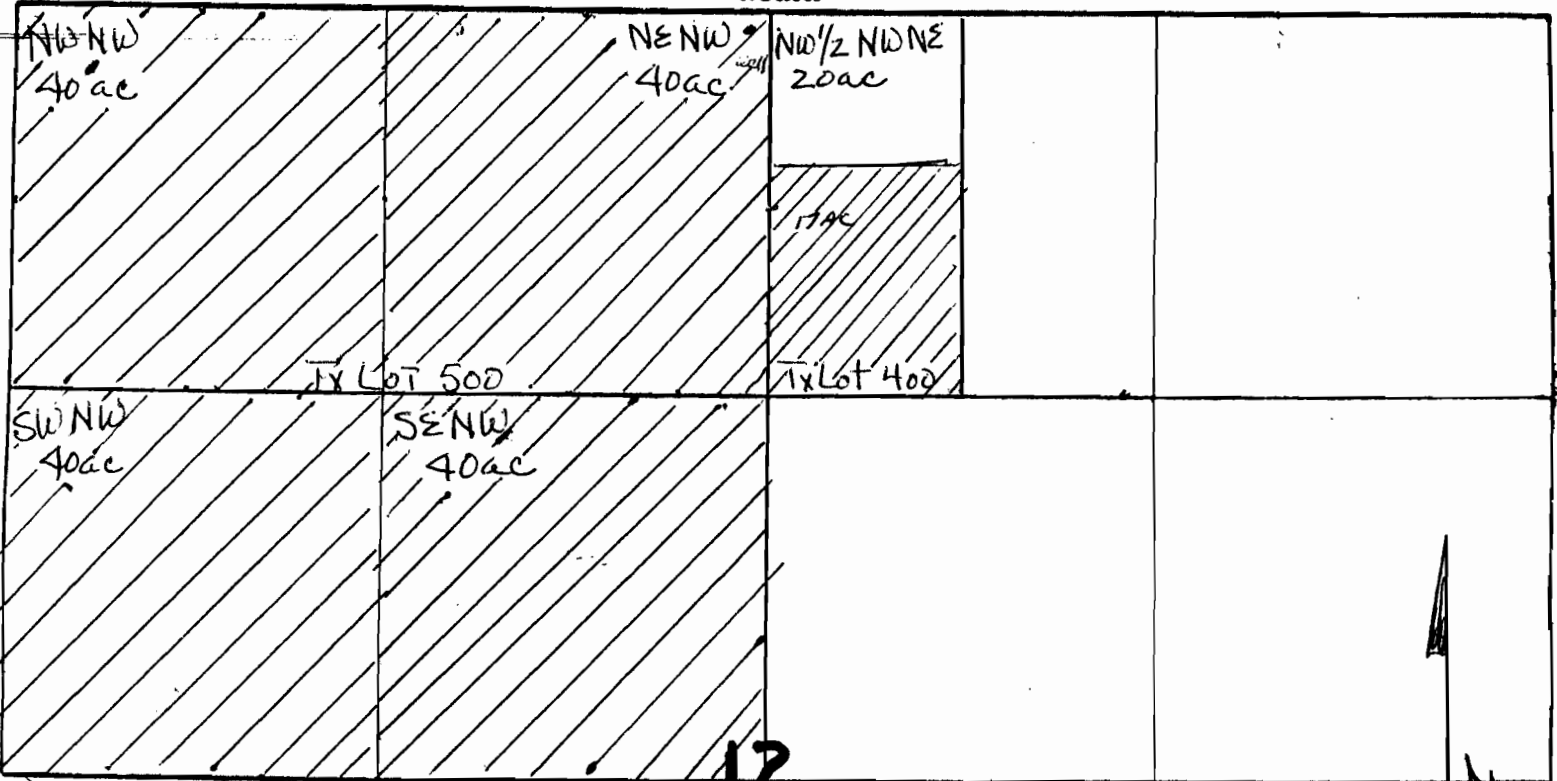

12

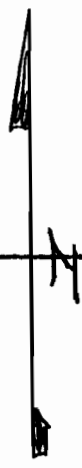

RECEIVED


DEC 24 2007

WATER RESOURCES DEPT
SALEM, OREGON

LAURANCE W Rowley
MARILEE A Rowley
67724 CRANE BUCHANAN RD
BURNS OR 97720


App No G-16987

Scale 8" = 1 mi

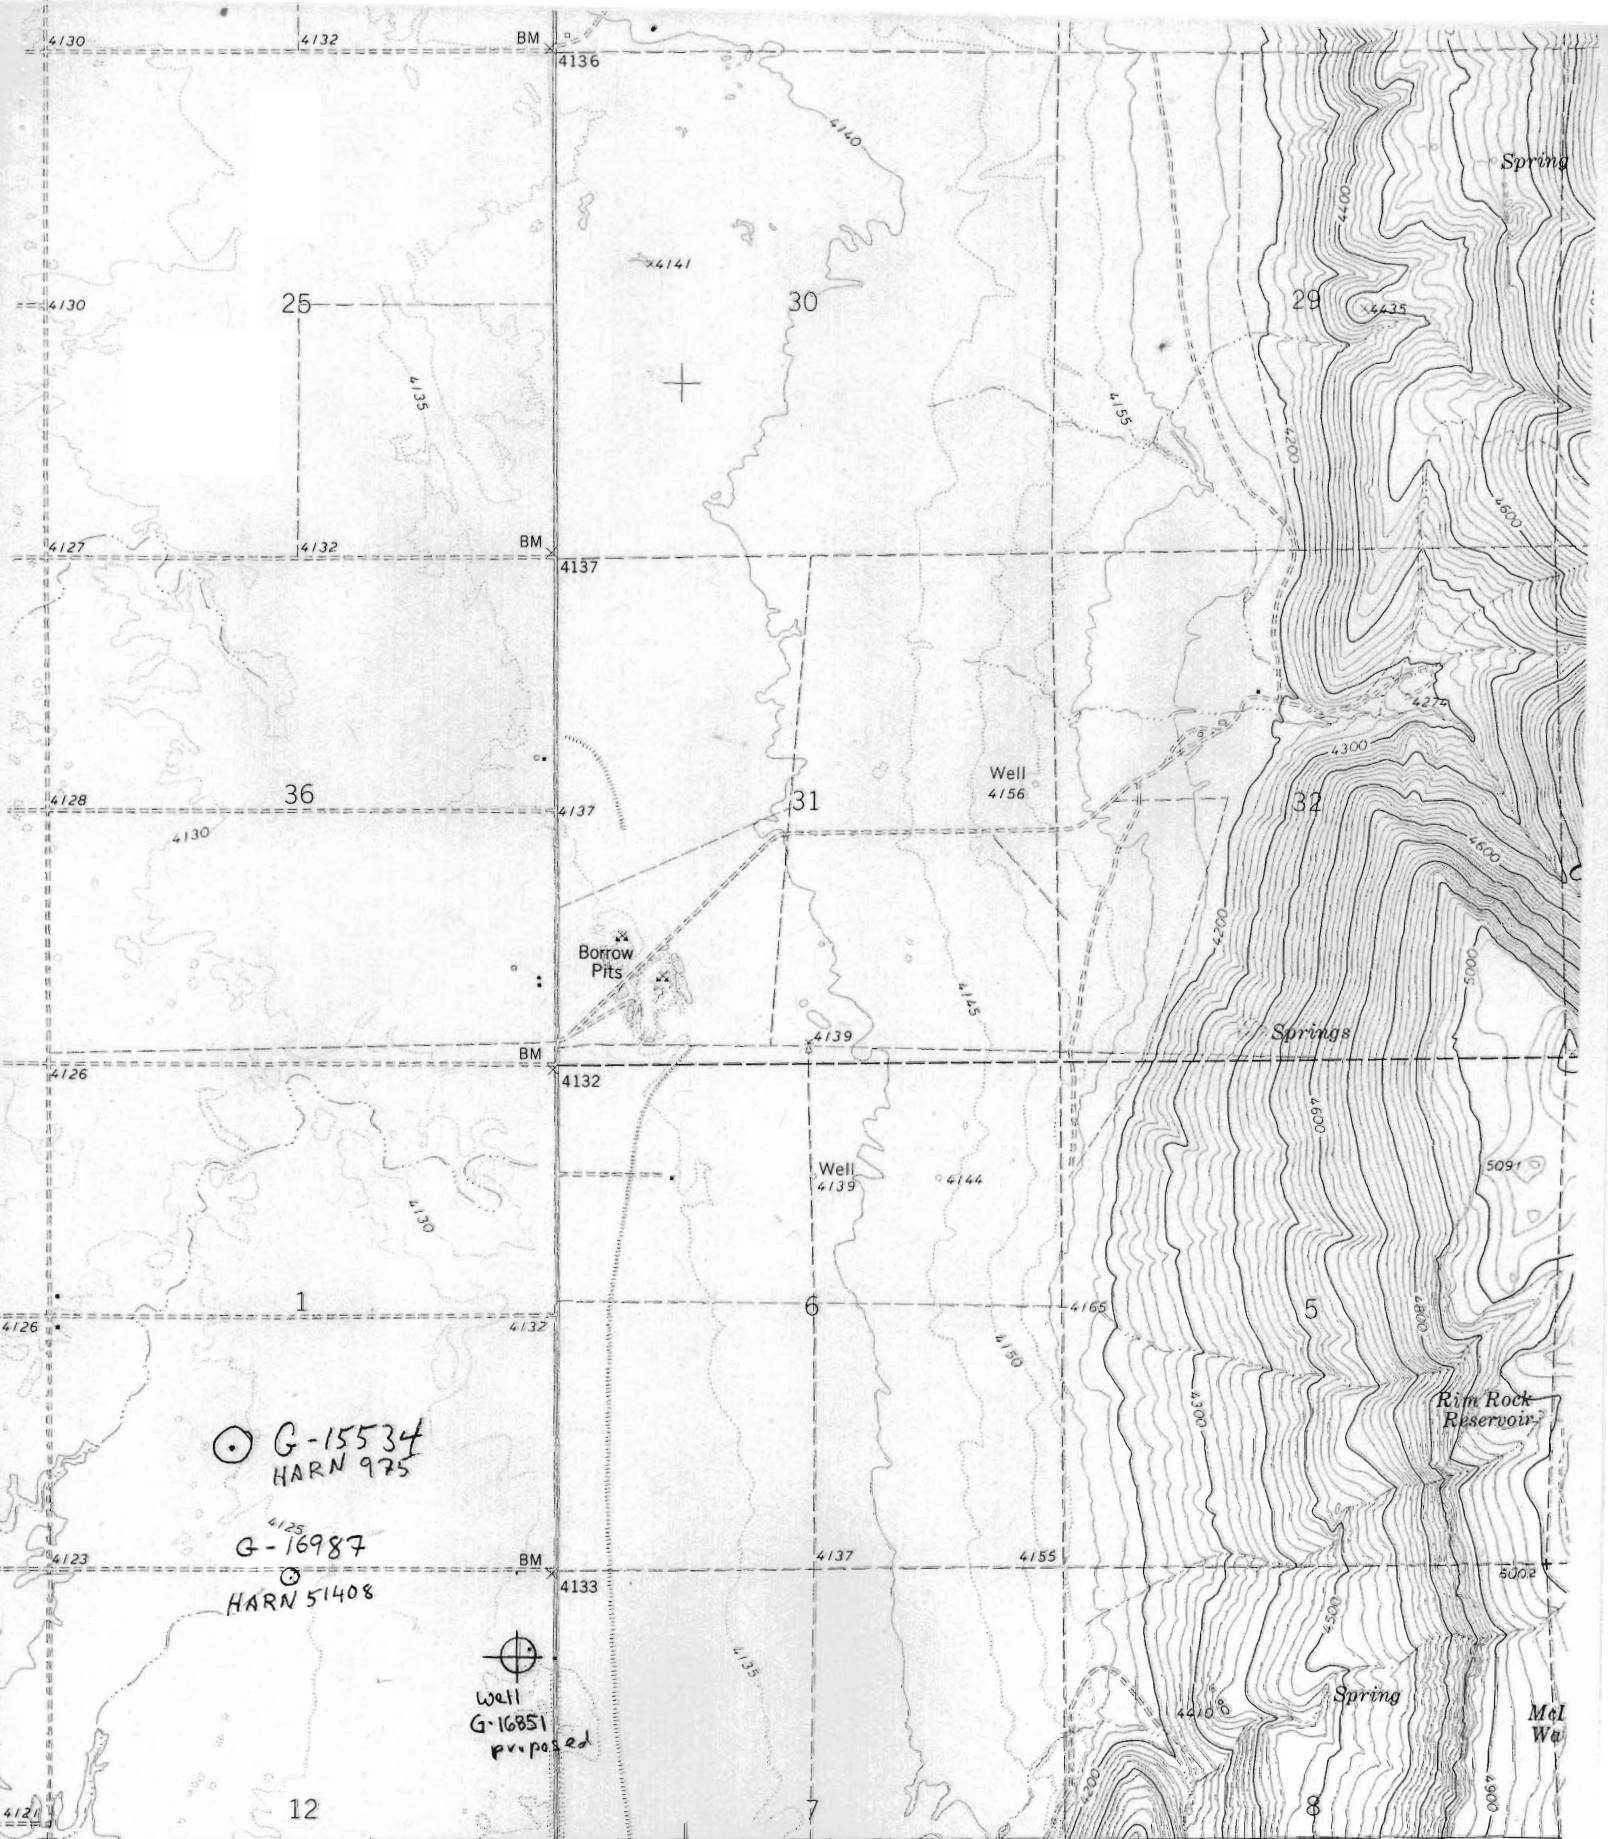


by the Geological Survey

s from aerial
d 1973
region coordinate
conic)

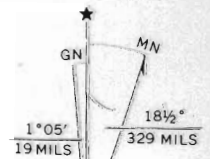

Mahon Creek

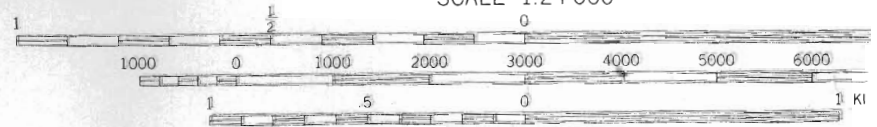

(CRANE 1:62 500) ±2270 I
SCALE 1:24 000

CONTOUR INTERVAL 20 FEET
DOTTED LINES REPRESENT 5-FOOT CONTOURS