


SEC. 22 T.28S. R.5 W W.M.
DOUGLAS COUNTY
Scale: 1" = 1000'

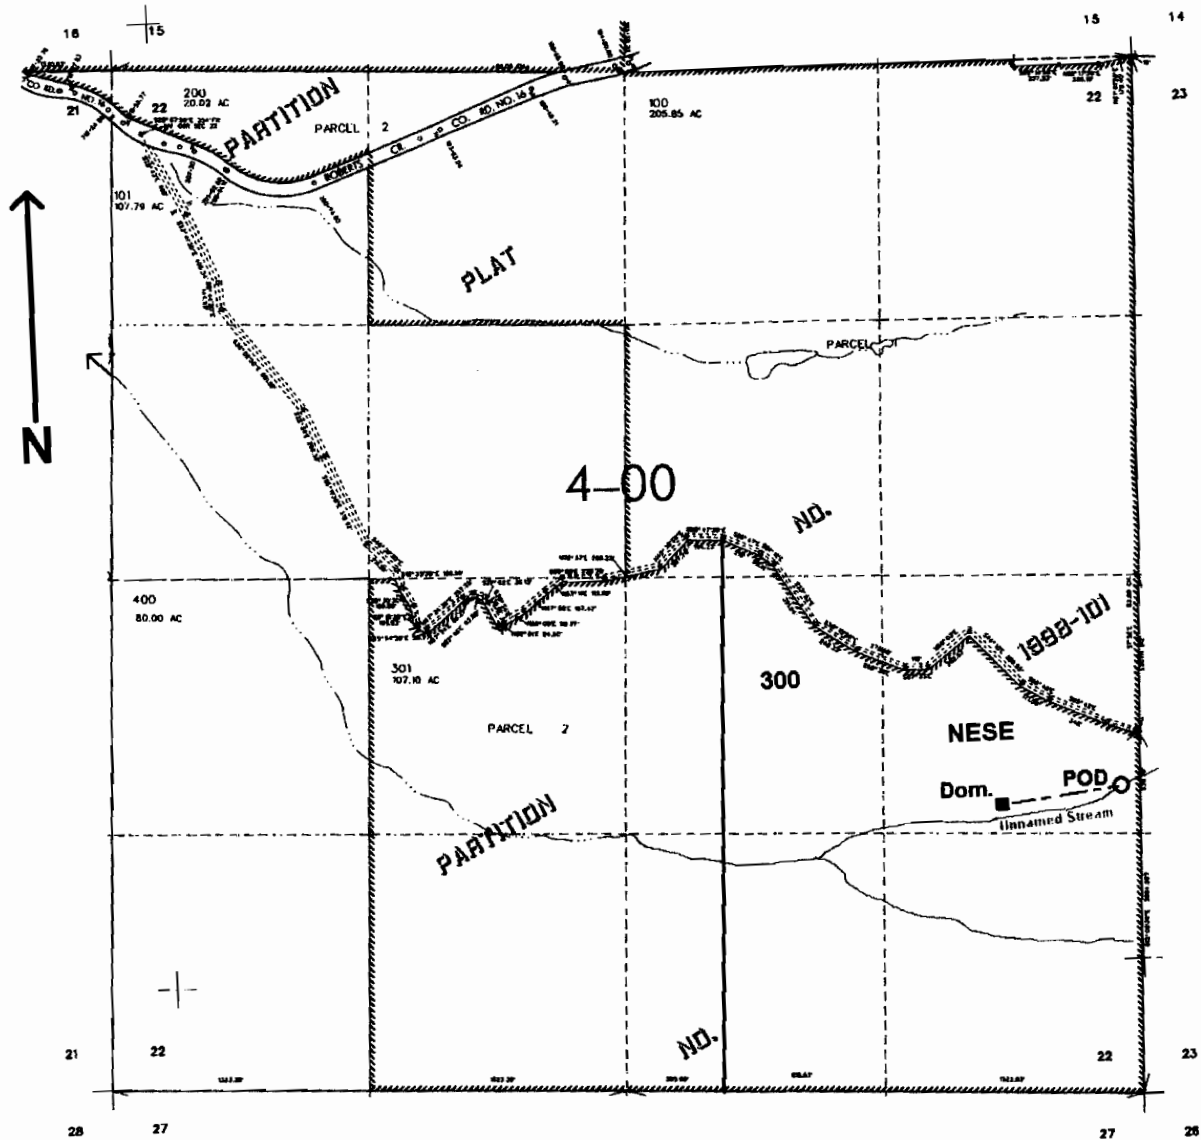

POD is located 1600 ft. N. and 100 ft. W. from the SE corner of Sec. 22

RECEIVED
MAY 23 2008
WATER RESOURCES DEPT.
SALEM, OREGON