


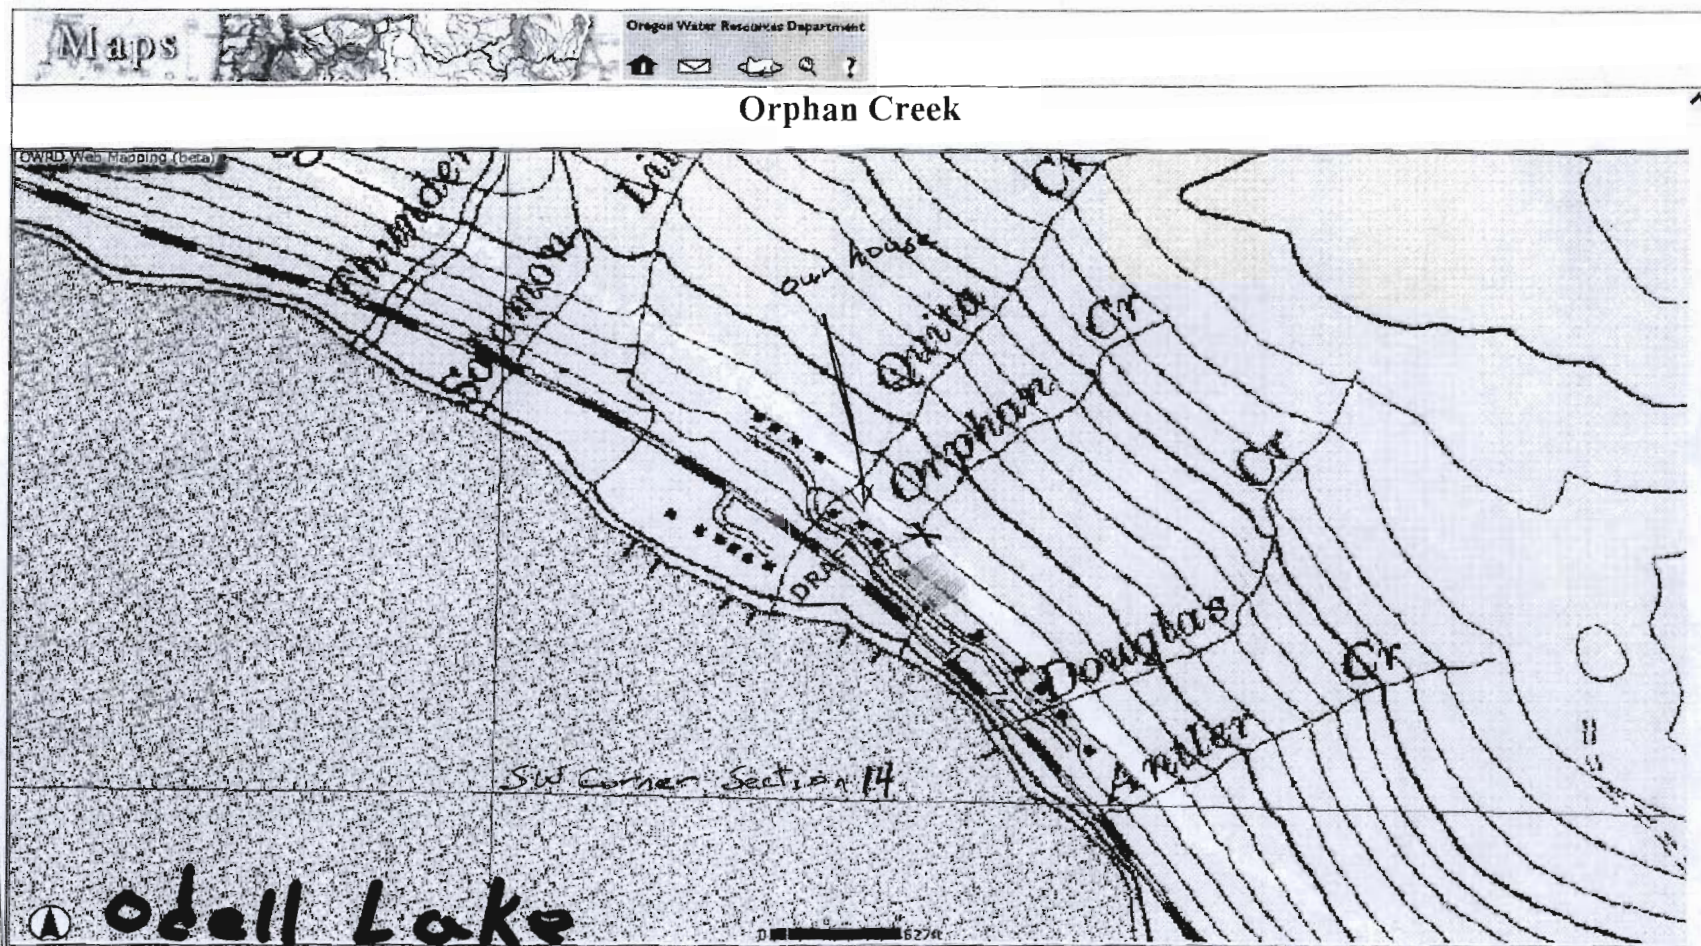

Map & Tax Lot - 2306 100 G5
 Forest Service Cabin No. 11
 Address - 22749 Highway 58
 Crescent Lake, OR 97425

POD = X 1700' East SW Corner Section 14
 1100' North

PCU = 1125' N + 145' East of
 SW corner Sec. 14

23.005 6.00E

ASR Cox 5000G
 1" = 500 Feet

RECEIVED

MAY 20 2008

WATER RESOURCES DEPT
 SALEM, OR

