

RECEIVED

MAY 30 2008

SW 1/4 SEC. 26 T.10S. R.4W. W.M.  
BENTON COUNTY


THIS MAP WAS PREPARED FOR  
ASSESSMENT PURPOSES ONLY

10 4 26C

REV: 09-12-2007

CANCELLED:

- 603
- 601
- 301
- 400
- 605
- 805
- 801
- 1102
- 1001 26
- 1500

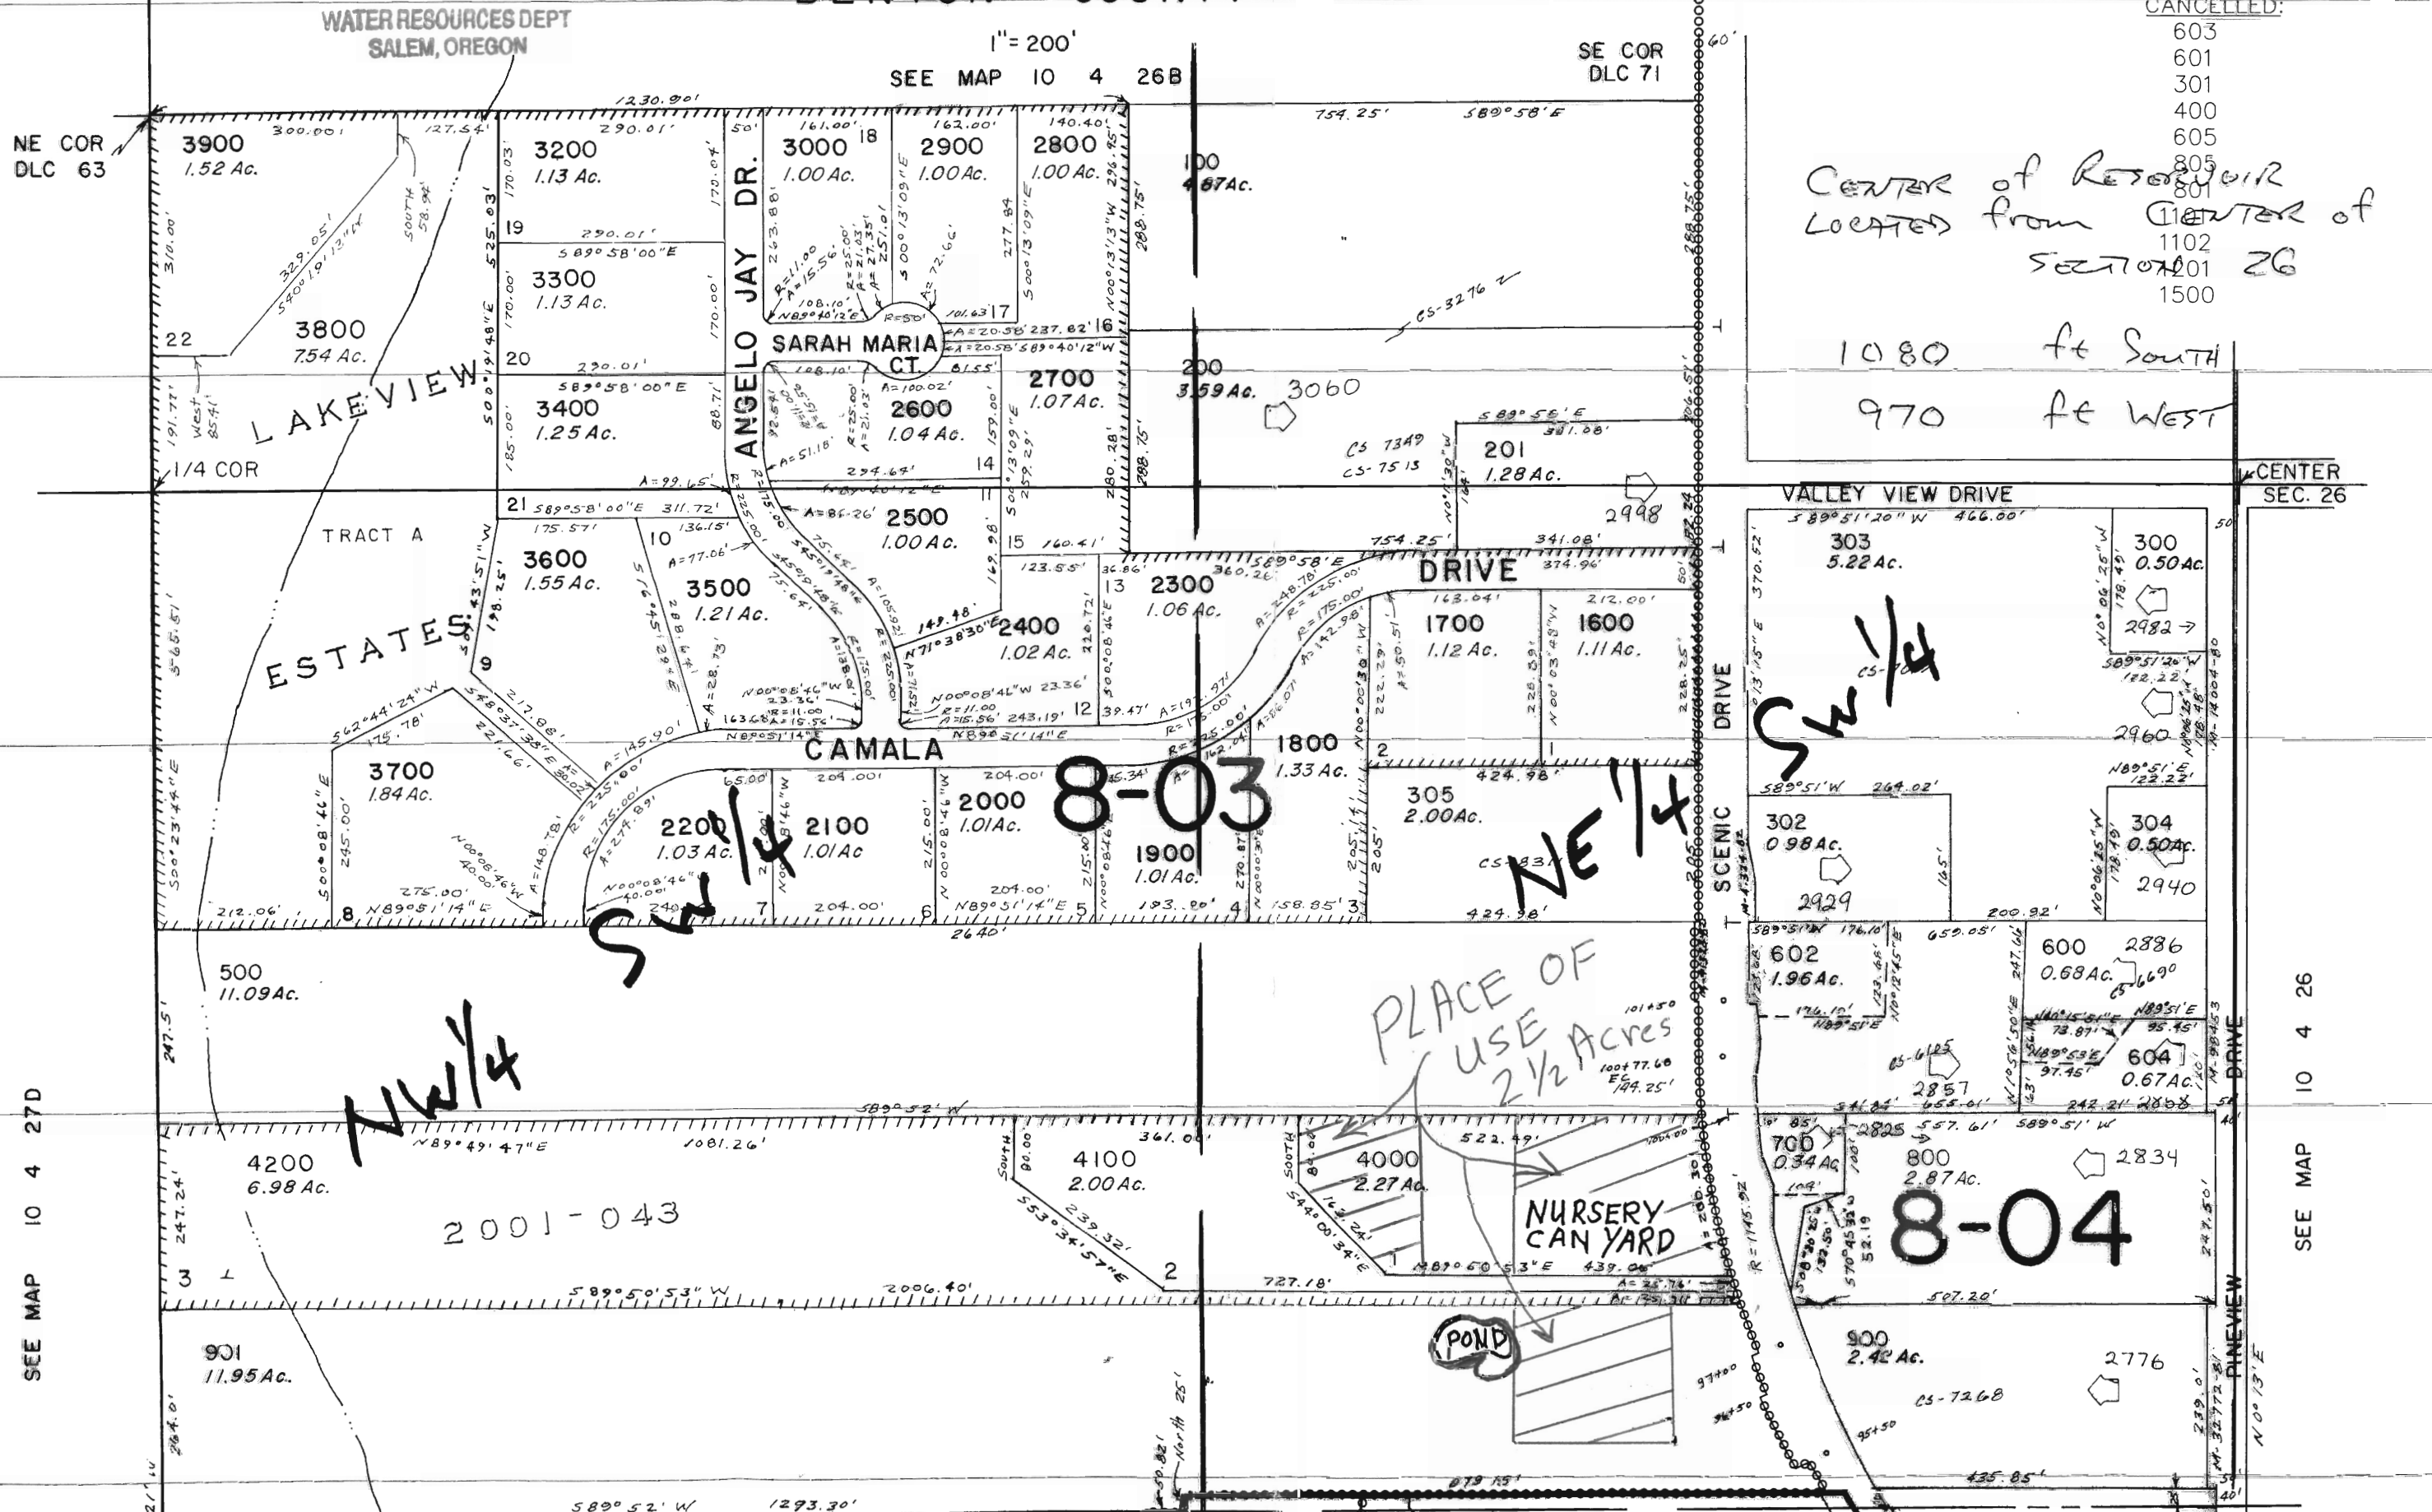

CENTER of Reservoir  
LOCATED from CENTER of  
SECTION 26  
1080 ft SOUTH  
970 ft WEST

CENTER  
SEC. 26

SEE MAP 10 4 26

SEE MAP 10 4 27D