

SEE MA

12 south 3 west, Section 3,

W.M.

(SW 1/4)

20.75 CR.

23.48 CR.

500
95.58AWell 1: 2070 feet North & 135 feet
East from SW corner, Section 3Well 2: 1870 feet North & 500 feet
East from SW corner, Sec. 3**8-8**

1" = 400'

12 south
3 west
Section 3,
W.M.PDU & wells
located in
NWSW,
Section 3

15.0 acres

400
53.31A401
59.09 AC.

SWSW

NESCW

SESW

3

(30.16 CR.)

25 CR.

1/4 COR.

RECEIVED


SEP 07 2007

WATER RESOURCES DEPT.
SALEM, OREGON

App No G-16924

SEE MAP 12 SW 1/4

added to file by a. madden
9/7/2007

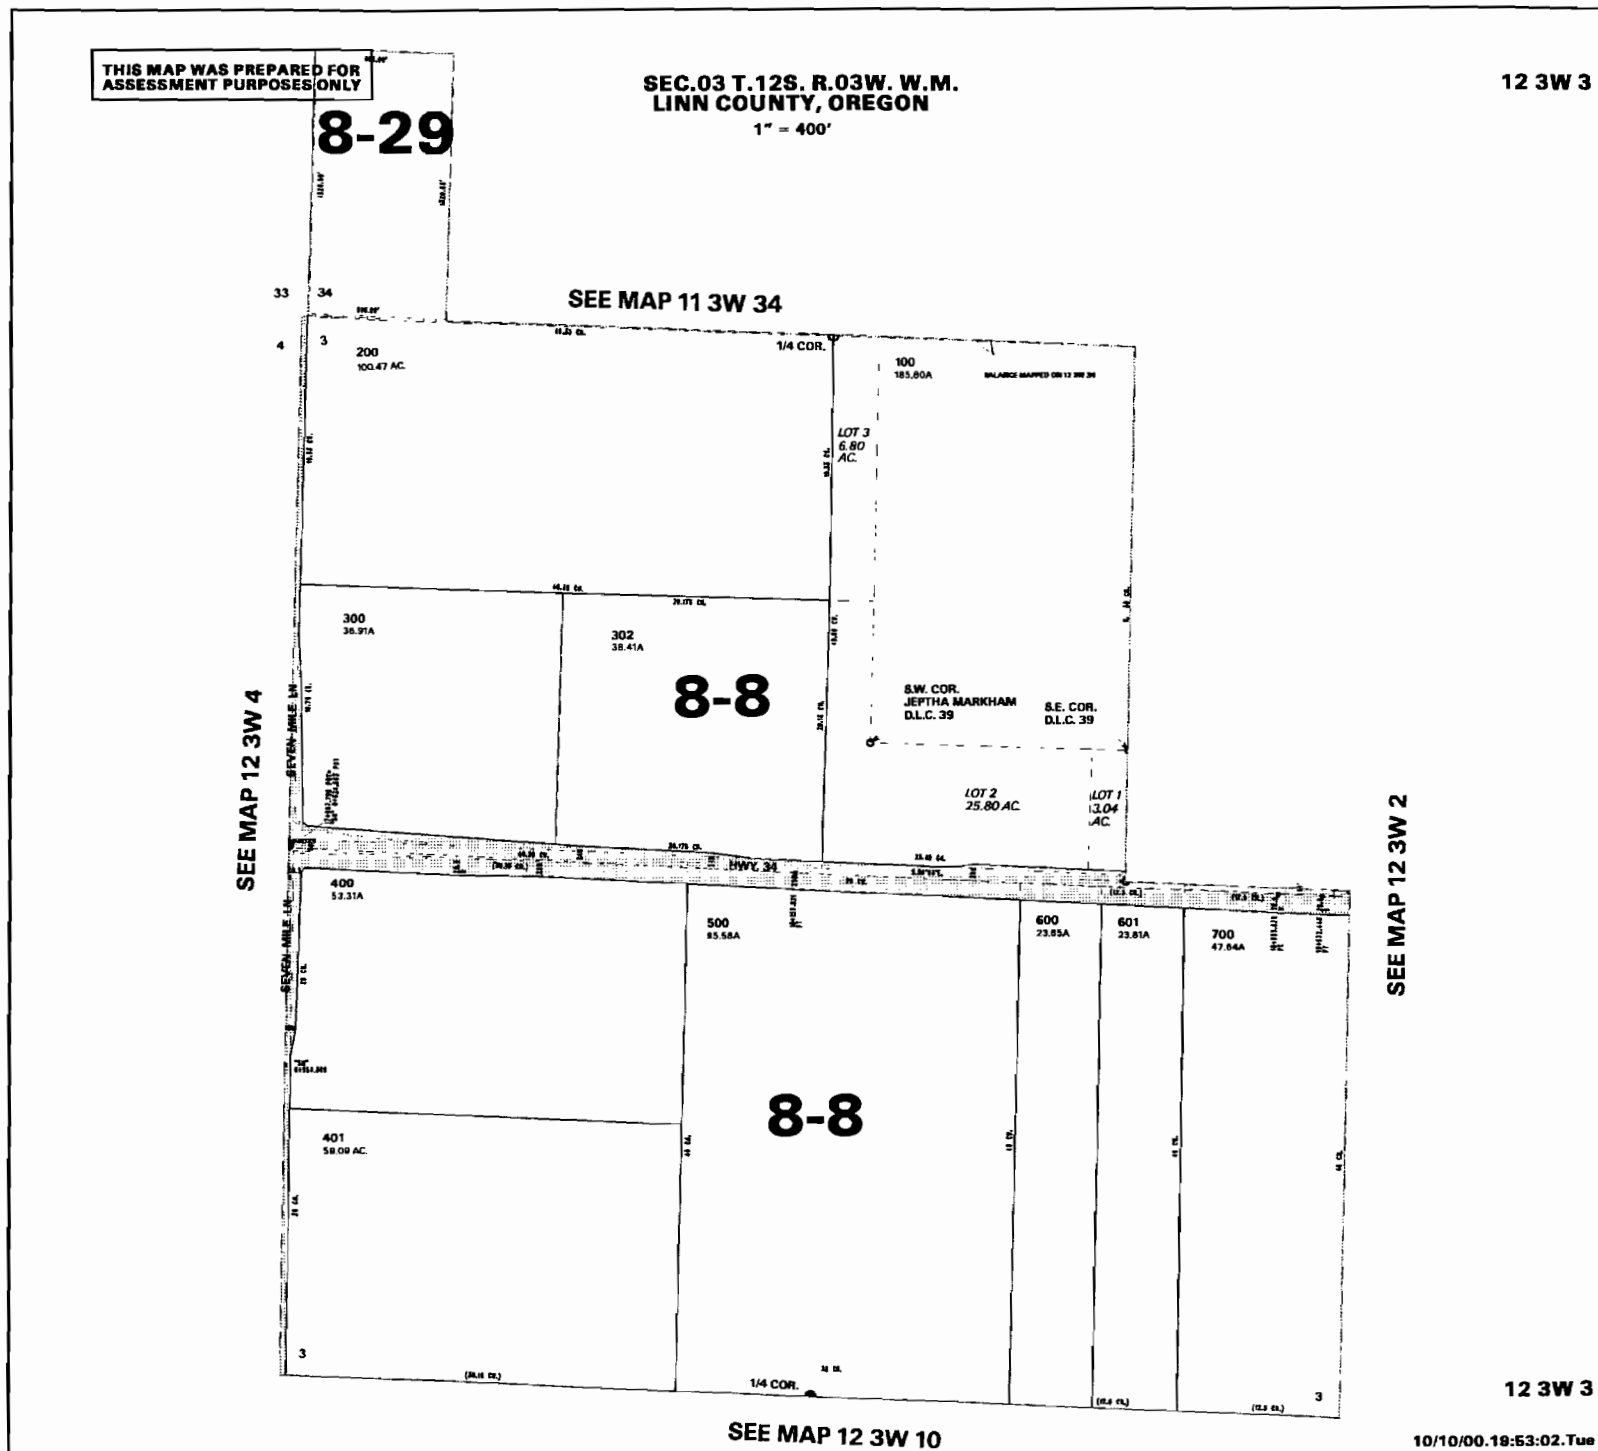

App No G-16924