


T 39 S, R 19 E, WM

LAKE COUNTY, OREGON

TAX LOT 39-19-7800

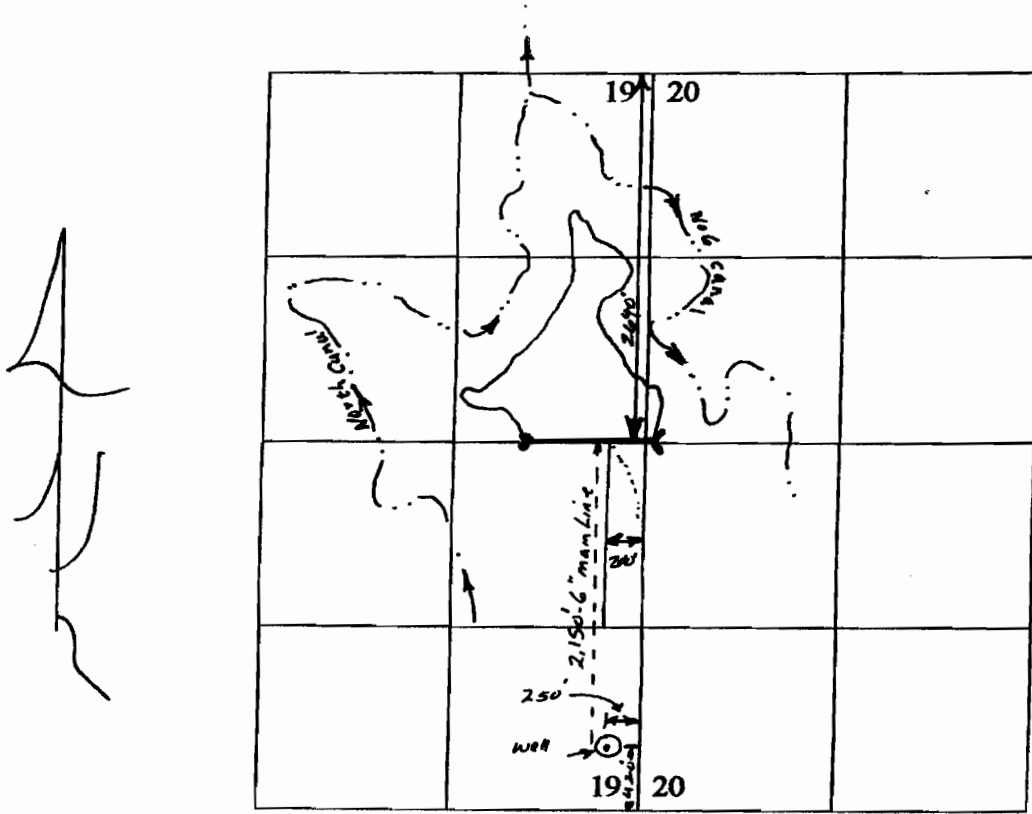

Dam 2640' S ; 200' W from the NE Corner
Sec 19

SCALE - 1" = 1320'

Well Located 420' N ; 250' W from the
SE CORNER SEC 19, being in the SE 1/4 SE 1/4
SEC 19, T 39 S, R 19 E. W.M.

RECEIVED

MAR 10 2008
WATER RESOURCES DEPT
SALEM OREGON

App No G-17020

SCALE IN FEET
0 2000 4000

THIS MAP WAS PREPARED FOR
ASSESSMENT PURPOSE ONLY

LAKE COUNTY

1" = 2000'

33 13
& INDEX


CANCELLED NO.
101 5101
119U 5200
105 5300
700 5400
1801 5501
1000 5600
3500 5701
3500 5800
4000 5900
119U 6000
4006 6100
4006 6202
4200 6300
4200 6400
4400 6501
4500 6602
4800 6704
4801 6805
4700 6906
4800 7009
4801 7100
4900 7202
4900 7312
7516

PARCEL 1800
1. 1/2 AC. ROAD
2. 1/2 AC. ROAD
PARCELS
5400 & 5401
1. 1/2 AC. ROAD
2. 1/2 AC. ROAD
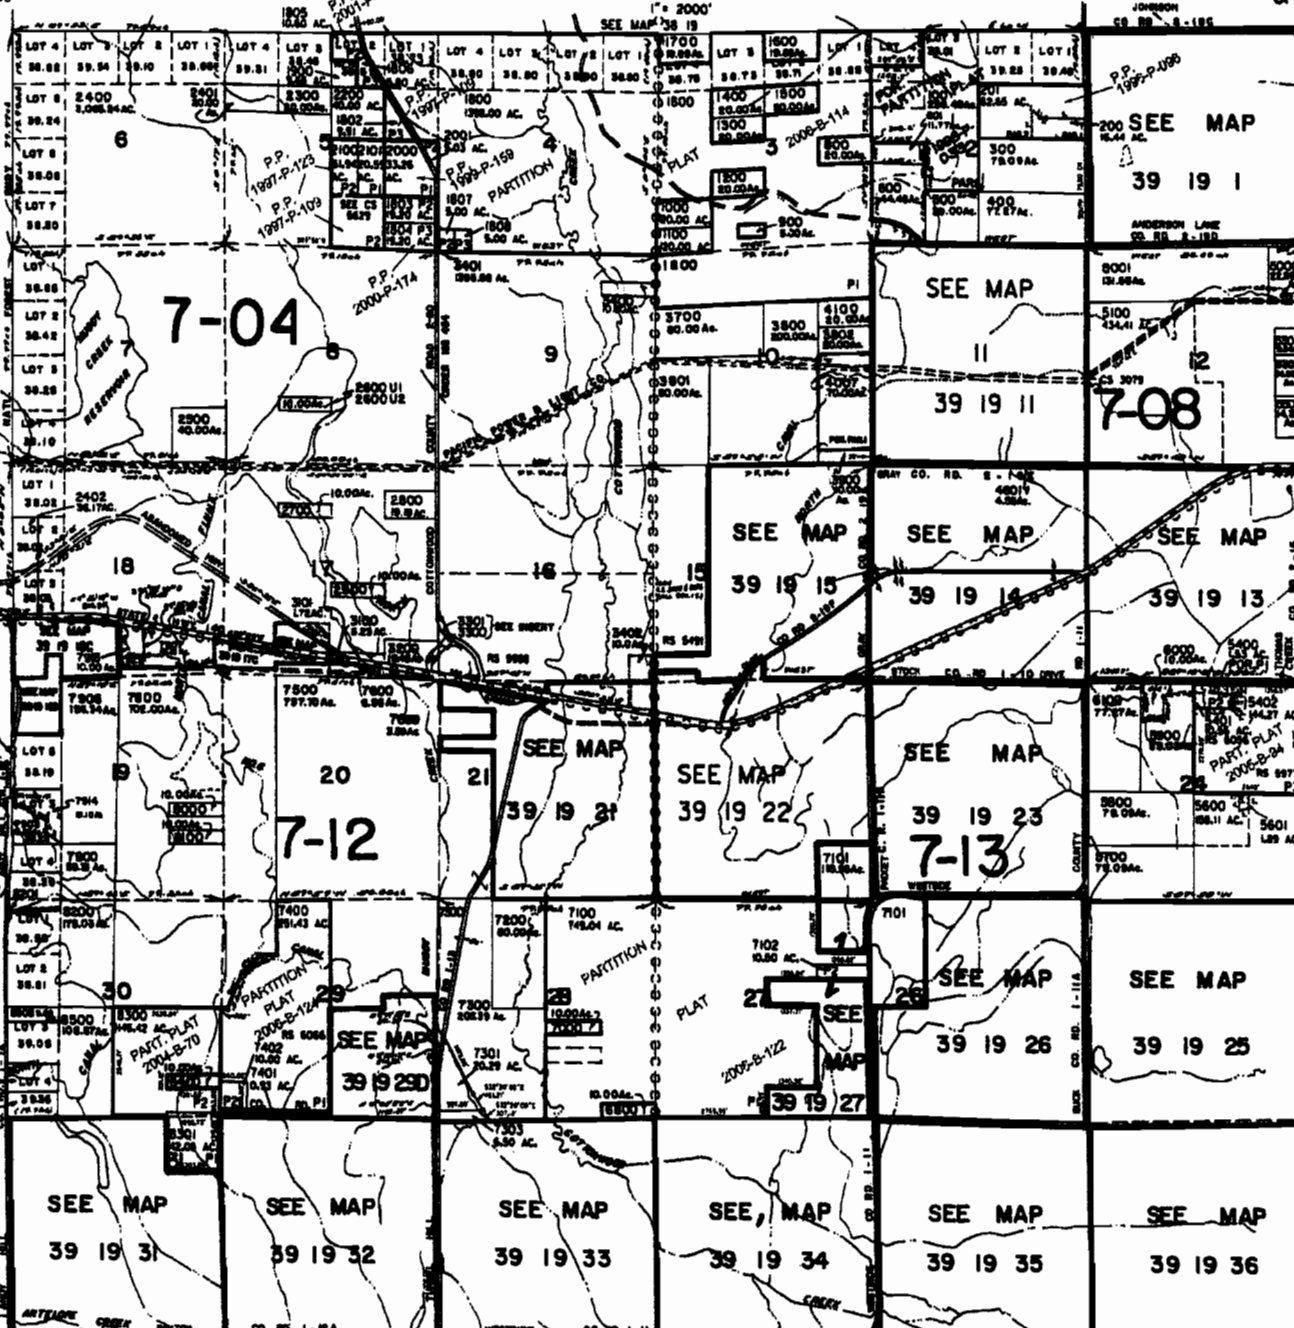

INSERT SEC. 17
SCALE 1" = 400'

PARCEL 7014
1. 1/2 AC. ROAD
2. 1/2 AC. ROAD
INSERT SEC. 30
SCALE 1" = 800'

8TH STANDARD PARALLEL SOUTH
SEE MAP 40 19

Revised
6/8/2006, DLH

39 19
& INDEX

RECEIVED

MAR 10 2008

WATER RESOURCES DEPT
SALEM, OREGON