


SECTION PLAT

Section 22, 23, 24, 26 Township 26-5 Range 29-E

County of HARNEY State of OR

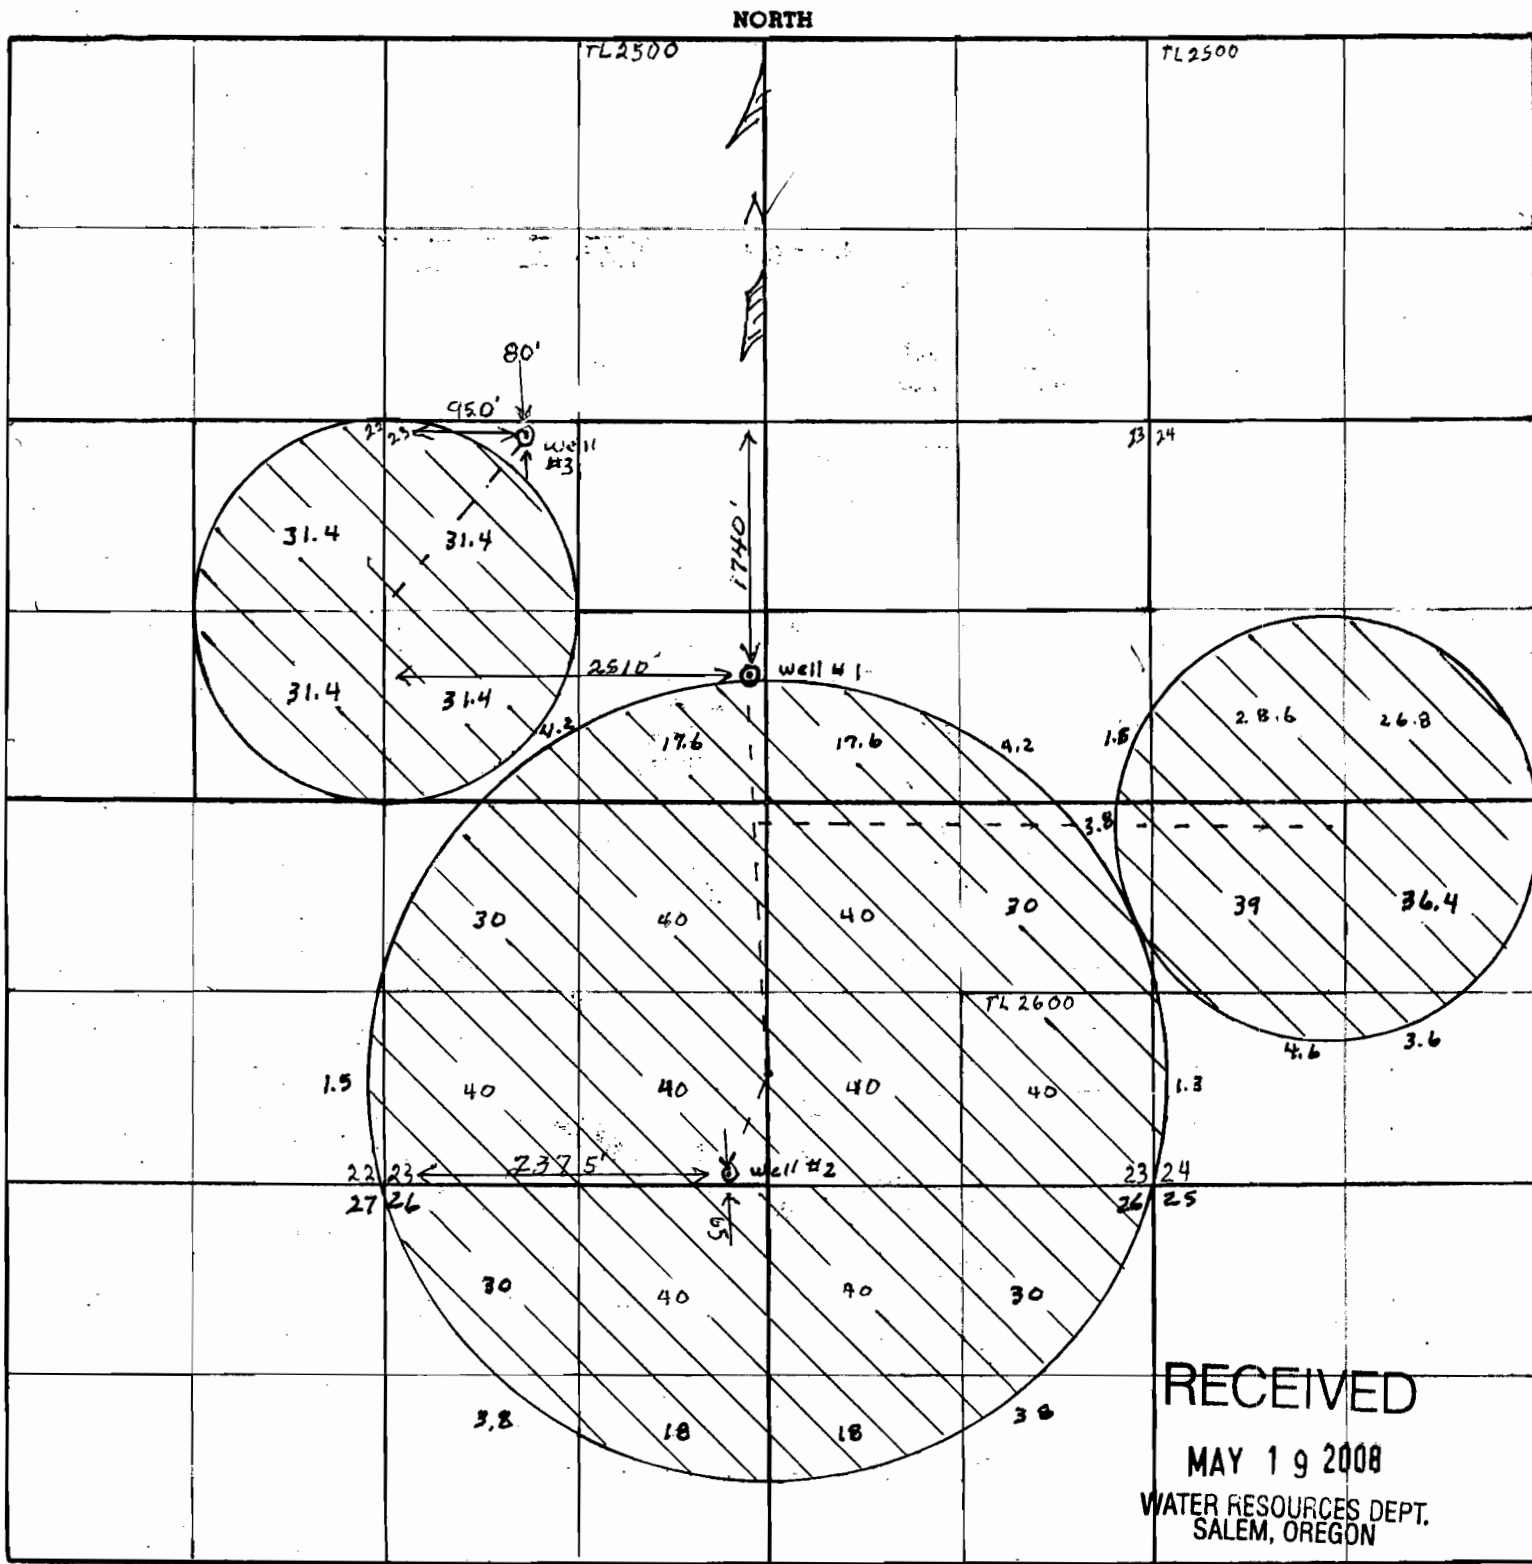

RECEIVED

MAY 19 2008

WATER RESOURCES DEPT.
SALEM, OREGON

Remarks scale - 1" = 1 mile - 660' -

RECEIVED

JUN 05 2008

WATER RESOURCES DEPT.
SALEM, OREGON