


Reservoir Application Map for Bill Seibert

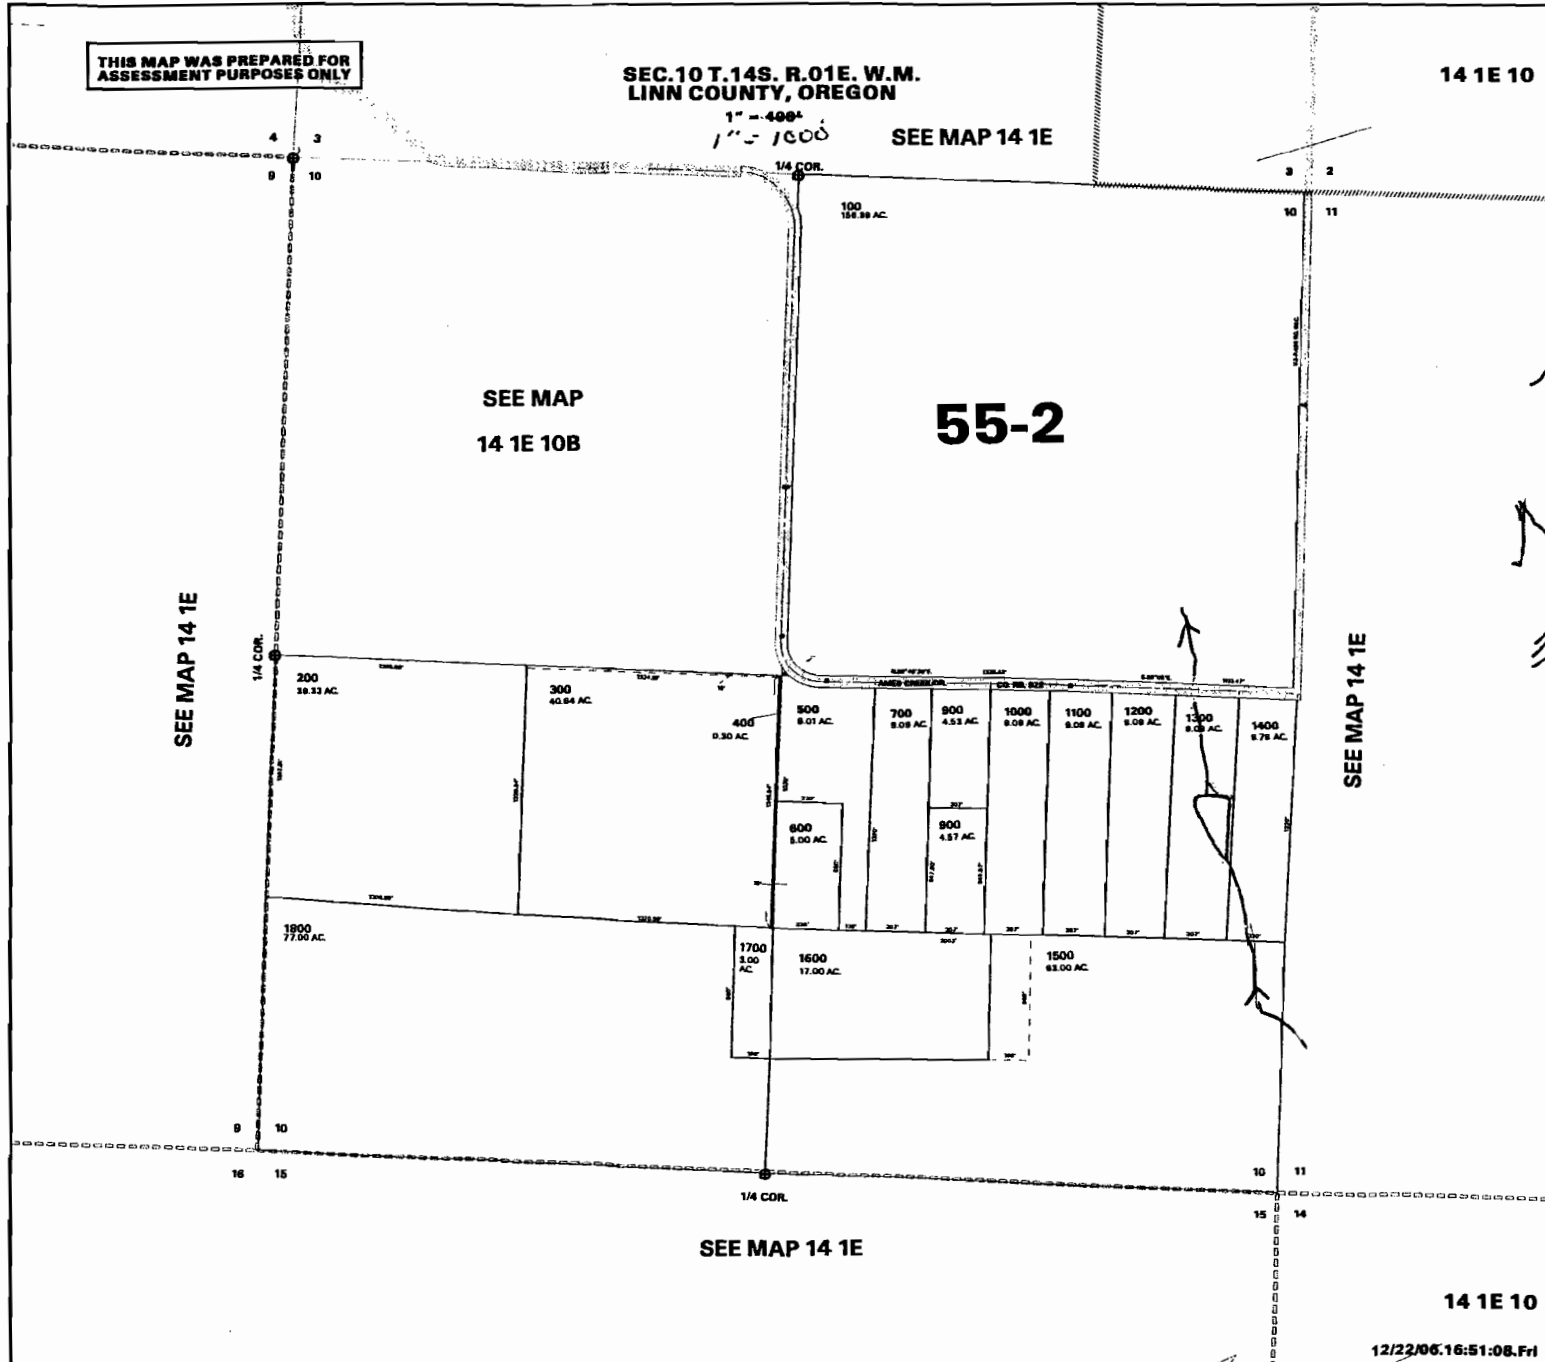

Pond in NE SE
Sec 10, TL 1300
Dam 2065 ft N
and 400 ft W
of SE corner
Sec 10

1" = 1000'

RECEIVED

JUN 12 2008

WATER RESOURCES DEPT
SALEM, OREGON