


G:\1000\1073\101\Cad\Water\W1073101_F2_WtrRight 13:08 05/27/2008 SS

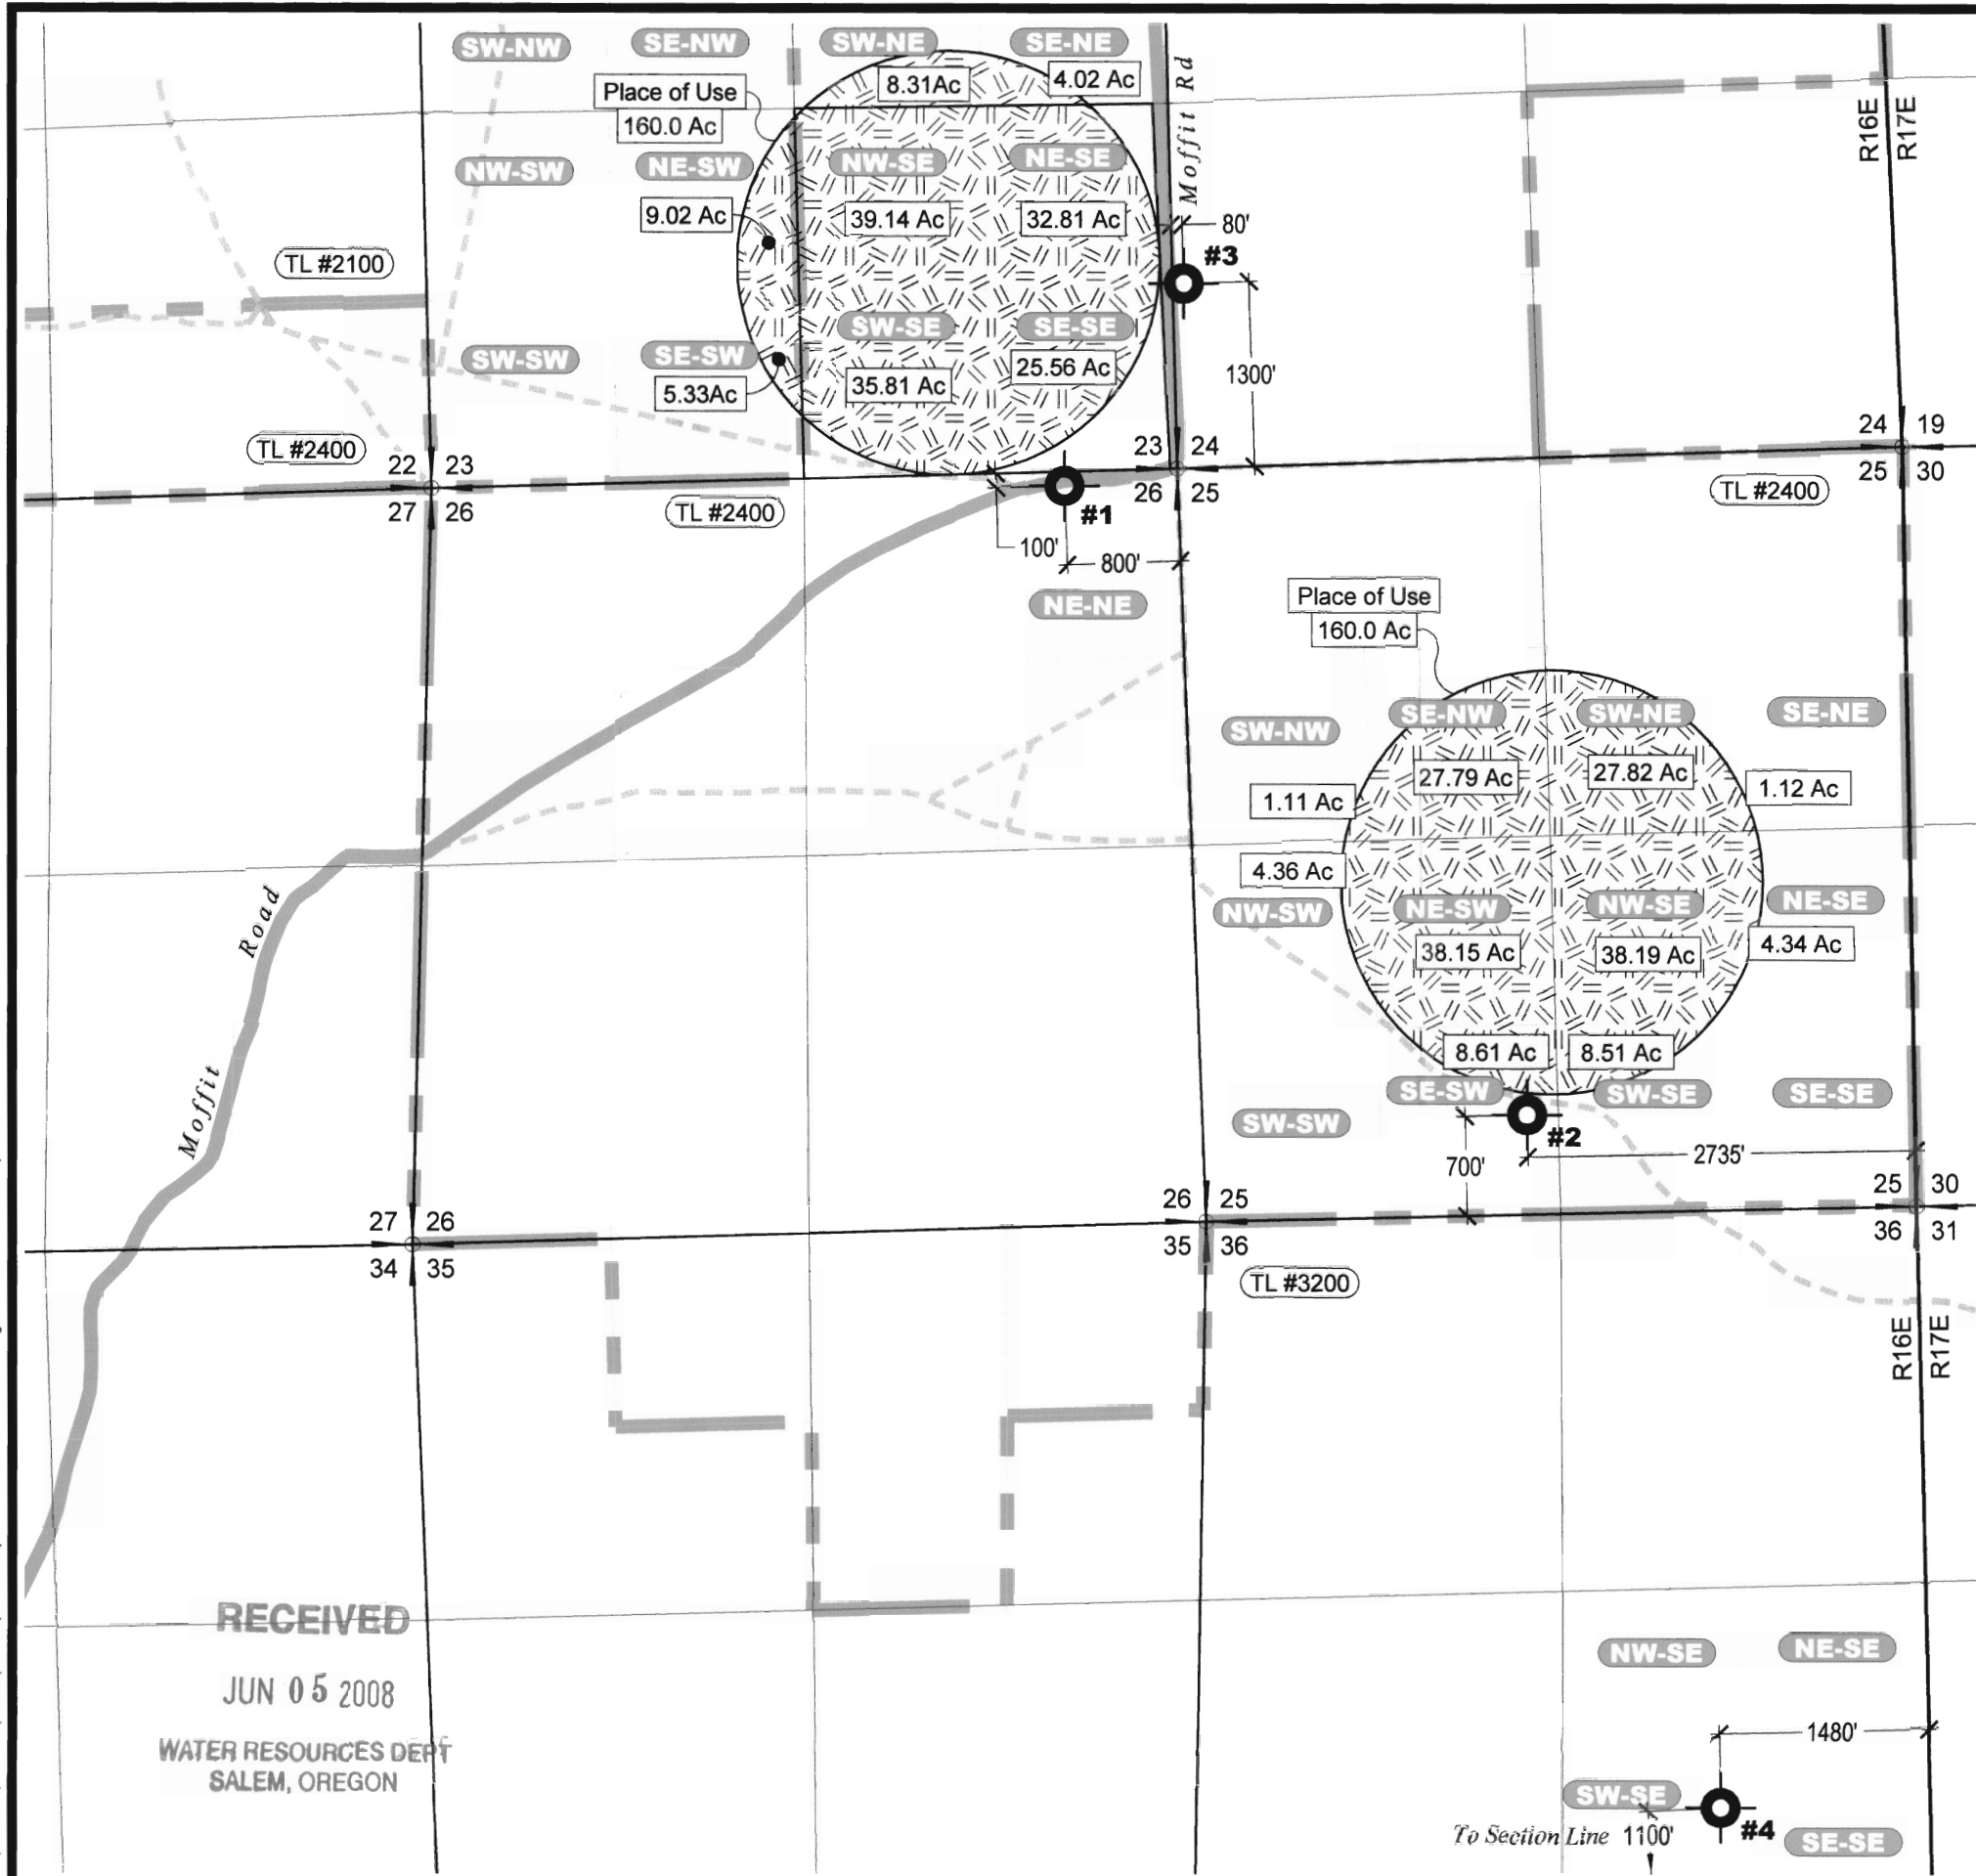

WATER RIGHTS APPLICATION MAP

PART TAX LOTS 2100 & 2400

In Tax Lot 2100, Located in
NE $\frac{1}{4}$ - SW $\frac{1}{4}$ & SE $\frac{1}{4}$ - SW $\frac{1}{4}$
of Section 23, T.20S., R.16E., W.M.

In Tax Lot 2400, Located in
SE $\frac{1}{4}$ - NE $\frac{1}{4}$ & SW $\frac{1}{4}$ - NE $\frac{1}{4}$ & NE $\frac{1}{4}$ - SE $\frac{1}{4}$
SE $\frac{1}{4}$ - SE $\frac{1}{4}$ & SW $\frac{1}{4}$ - SE $\frac{1}{4}$ & NW $\frac{1}{4}$ - SE $\frac{1}{4}$
of Section 23, T.20S., R.16E., W.M.

In Tax Lot 2400, Located in
SE $\frac{1}{4}$ - NE $\frac{1}{4}$ & SW $\frac{1}{4}$ - NE $\frac{1}{4}$ & NE $\frac{1}{4}$ - SE $\frac{1}{4}$
SW $\frac{1}{4}$ - SE $\frac{1}{4}$ & NW $\frac{1}{4}$ - SE $\frac{1}{4}$ & NE $\frac{1}{4}$ - SW $\frac{1}{4}$
SE $\frac{1}{4}$ - SW $\frac{1}{4}$ & NW $\frac{1}{4}$ - SW $\frac{1}{4}$ & SE $\frac{1}{4}$ - NW $\frac{1}{4}$
& SW $\frac{1}{4}$ - NW $\frac{1}{4}$ of Section 25
& SW $\frac{1}{4}$ - SW $\frac{1}{4}$ of Section 24
& NE $\frac{1}{4}$ - NE $\frac{1}{4}$ of Section 26, T.20S., R.16E., W.M.


In Tax Lot 3200, Located in
SE $\frac{1}{4}$ - NE $\frac{1}{4}$ of Section 36, T.20S., R.16E., W.M.
Deschutes County, Oregon

NOTES


1. This map was prepared for the purpose of identifying the location of water rights only and is not intended to provide legal dimensions or locations of property ownership lines.

LEGEND

- Gravel Road
- Paved Road
- Tax Lot Boundary Line
- TL #2400 Tax Lot ID Number
- #1 Approximate Location of Well
- Place of Use

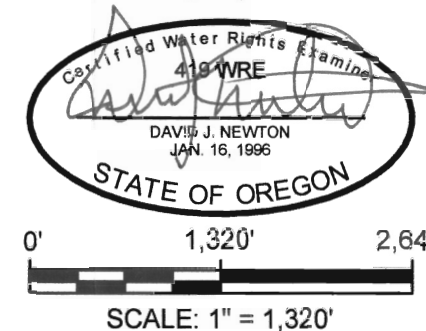

Water Rights Application Map
Kenneth Burbank & Fred Cramer
Water Rights Permit Application
Deschutes County, Oregon

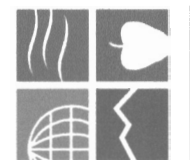

NEWTON
CONSULTANTS INC.
Earth, Water and Rock Specialists
Ph: 541 504-9950
Fax: 541 504-9951

DESIGNED BY

K. Turner

DRAWN BY

S. Schenck

DATE:


May 2008

PROJECT NO.

1073-101

FIGURE

2

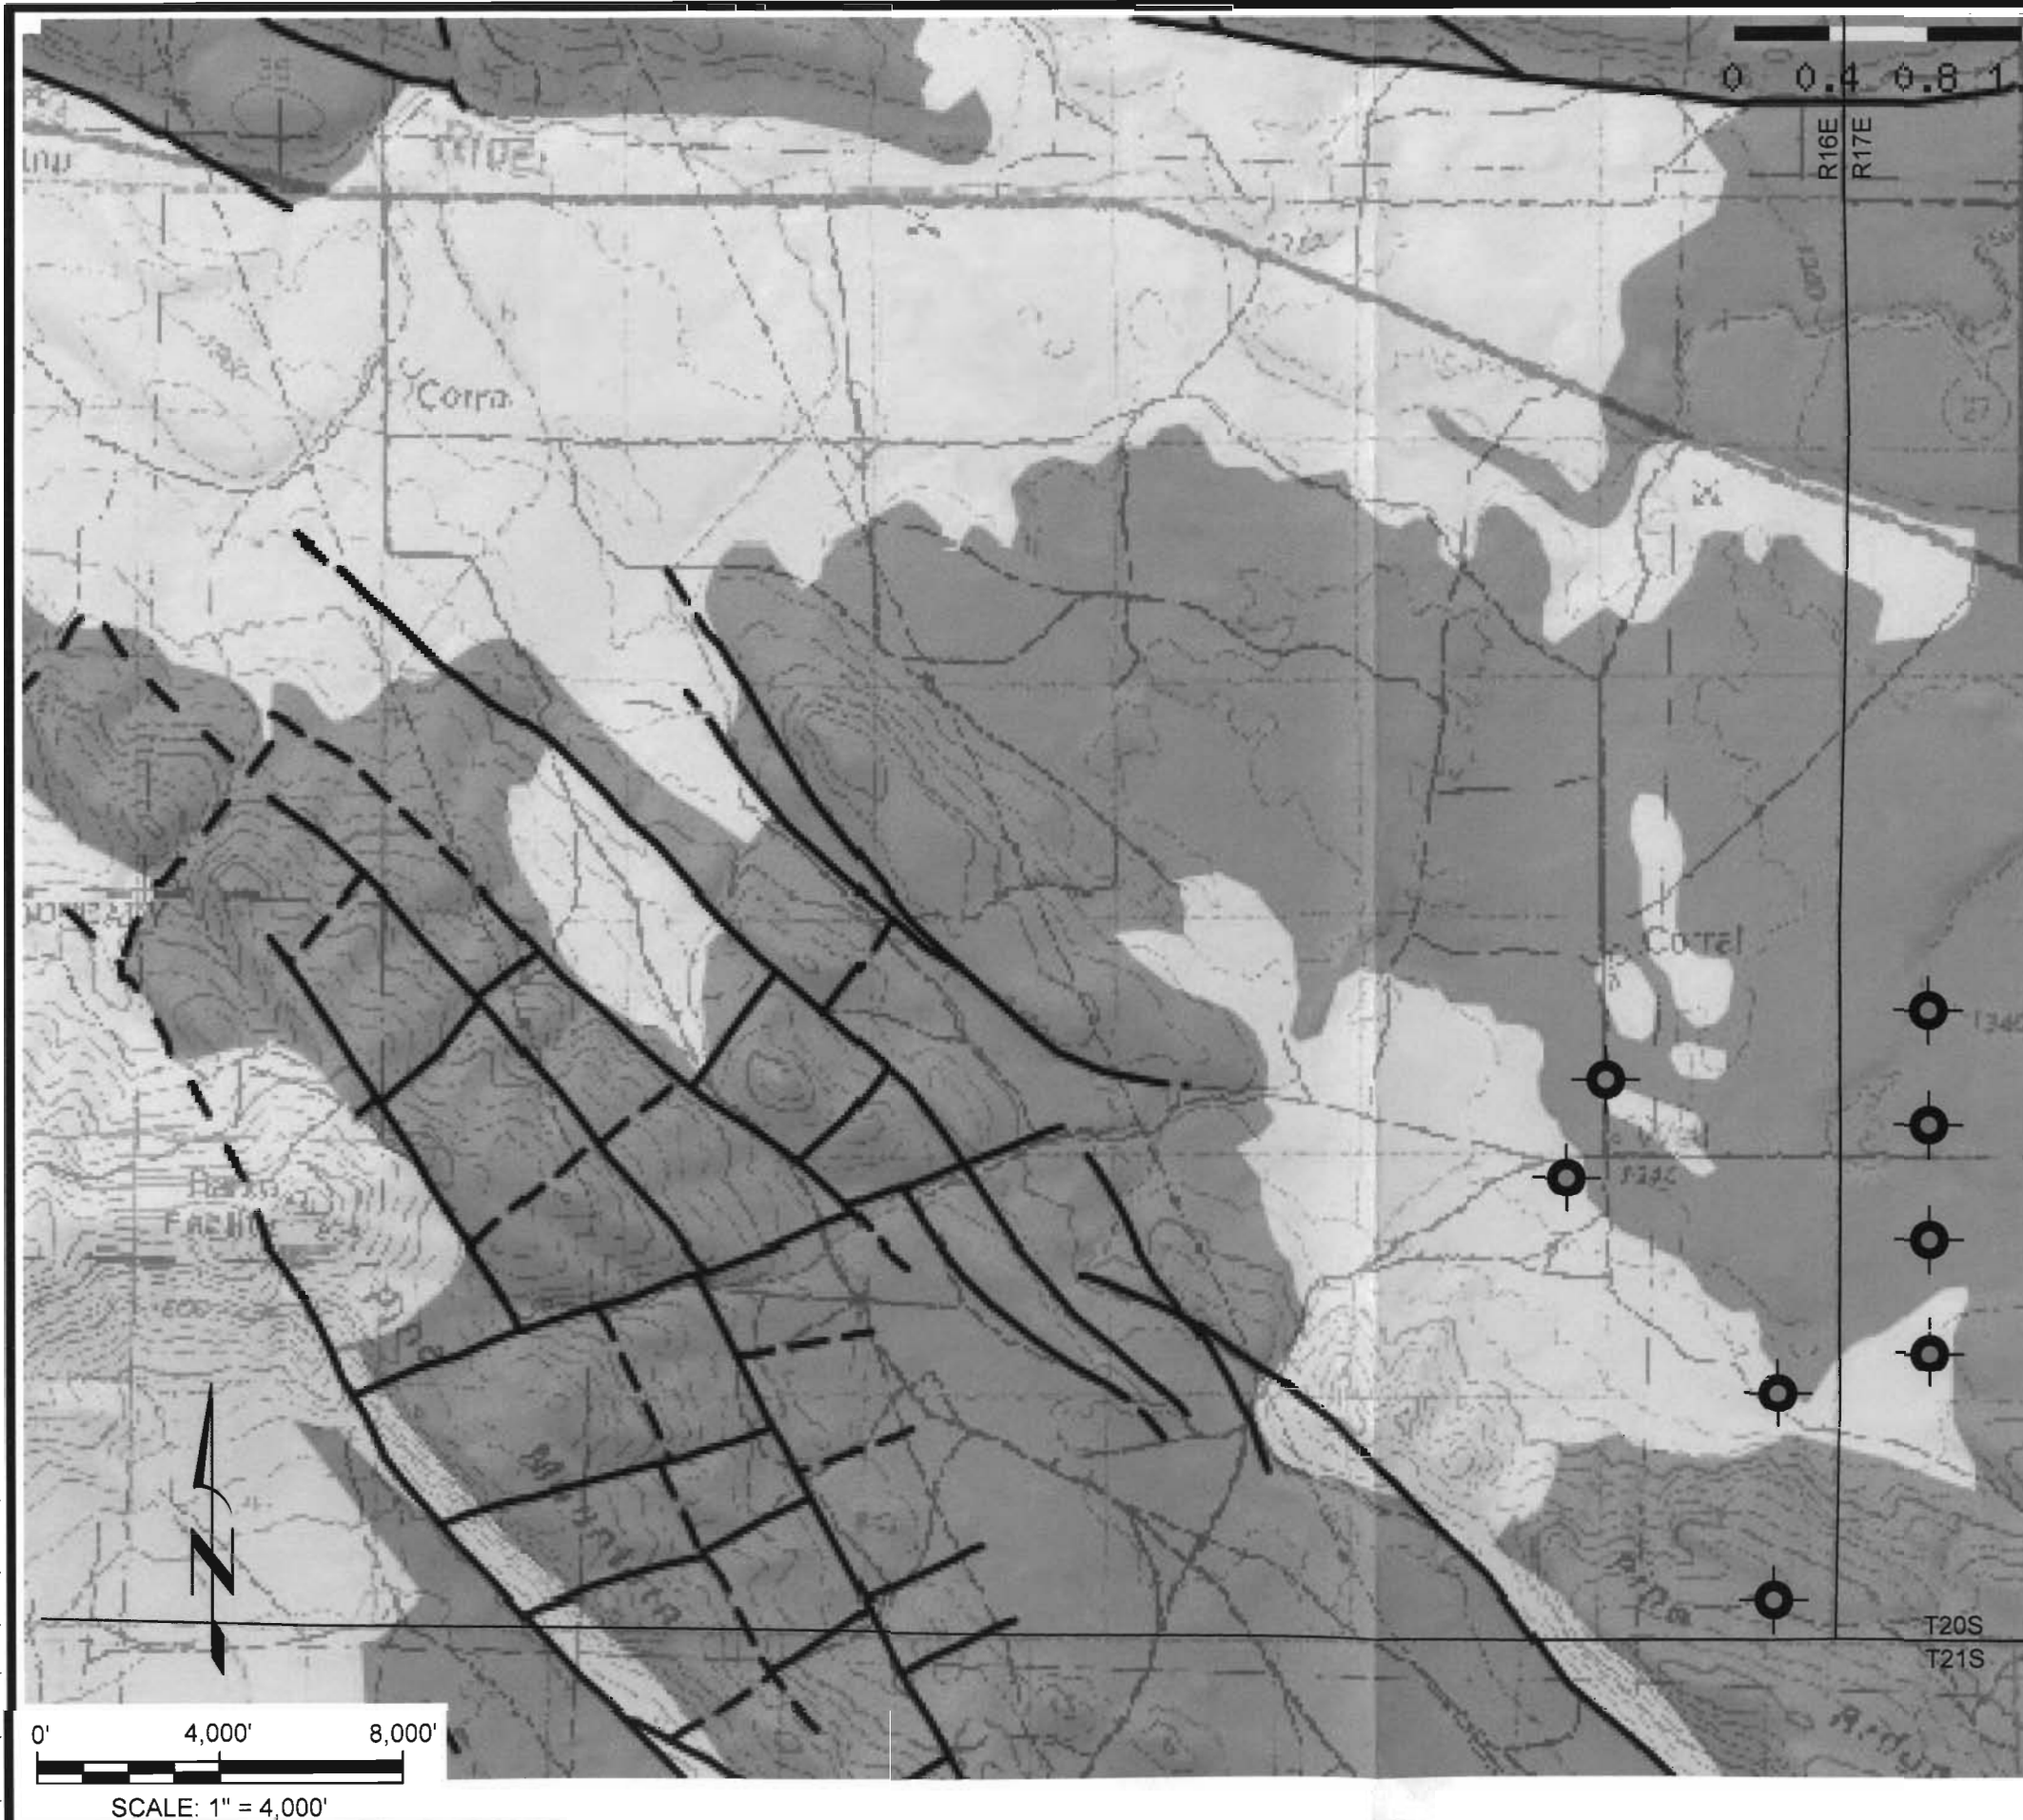


EXPLANATION

- Initially Proposed Well Locations (June 2008)
- Revised Proposed Well Locations (Feb 2009)


OGDC (v3) STRATIGRAPHY THEME KEY

- Quaternary surficial deposits
- Neogene sedimentary rocks
- Dalles Group
- Idaho Group
- Paleogene sedimentary rocks
- Late High Cascades Volcanics
- Quaternary volcanic rocks
- Kivett Volcanics
- Early High Cascade Volcanics
- Neogene volcanic rocks
- Harney Basin Volcanic Field
- High Lava Plains Volcanic Province
- Powder River Volcanic Field
- Strawberry Volcanics
- Columbia River Basalt Group
- Lake Owyhee Volcanic Field
- Oregon-Idaho Graben
- McDermitt Volcanic Field
- Northern Nevada volcanics
- John Day-Clarno Group
- Western Cascades Volcanics
- Paleogene volcanic rocks
- Umpqua Group
- Nevadan Intrusives
- Pueblo Mountain Metamorphic Complex
- Mountain Home Metamorphic Complex
- Mitchell Group
- Wallowa Terrane
- Baker Terrane
- Olds Ferry Terrane
- Grindstone Terrane

Source:
Oregon Department of Geology and
Mineral Industries (DOGAMI)
Oregon Geologic Data Compilation
(OGDC)
(<http://ogdc.geos.pdx.edu>)

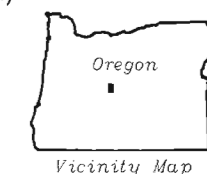

Site Geology
Kenneth Burbank & Fred Cramer
Water Rights Permit Application
Deschutes County, Oregon

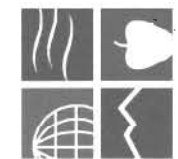

NEWTON
CONSULTANTS INC.
Earth, Water, and Rock Specialists
Ph: 504-504-9980
Fax: 504-504-9981

DESIGNED BY:
K. Turner

DRAWN BY:
S. Schenck

DATE:
OCT 2009

PROJECT NO.
1073-101

FIGURE
3