


Fisher Reservoir

T. 8S., R. 21E., W.M. Sec. 10 tax lot 500

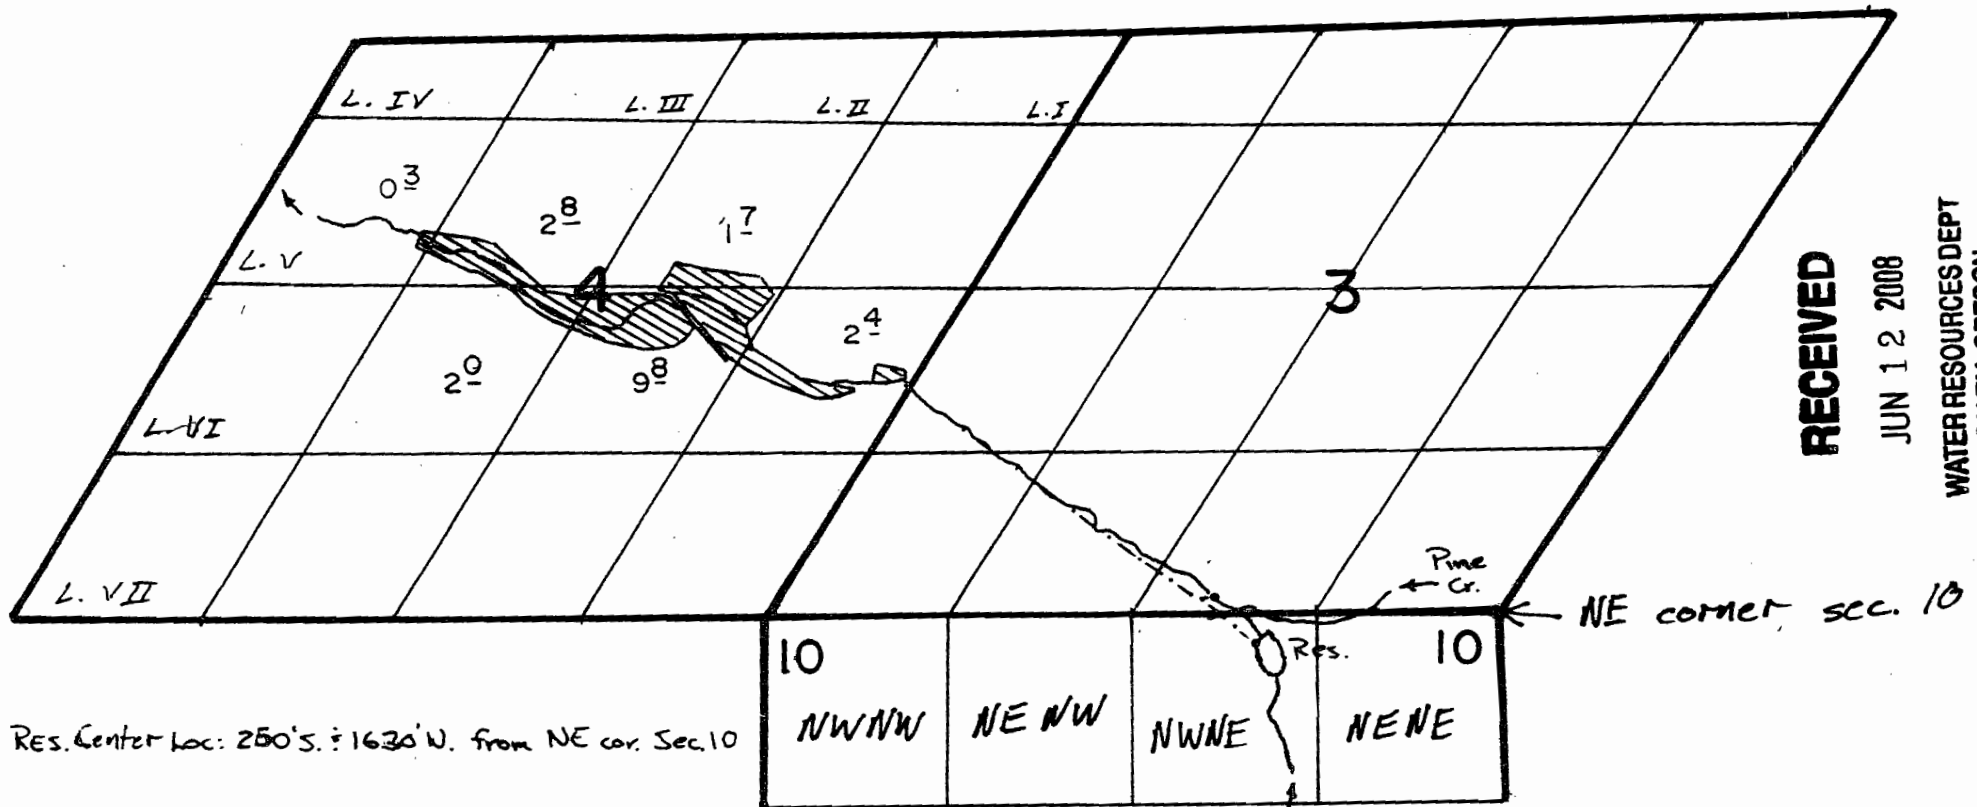

RECEIVED

JUN 12 2008

WATER RESOURCES DEPT
SALEM, OREGON

SCALE 1" = 1320'

SURVEYED SEPT. 14, 2000 by vern church
- for T-4806