


CORRECTED ADJUSTED 1" = 600 FT. APPROX SCALE


1" = 600'


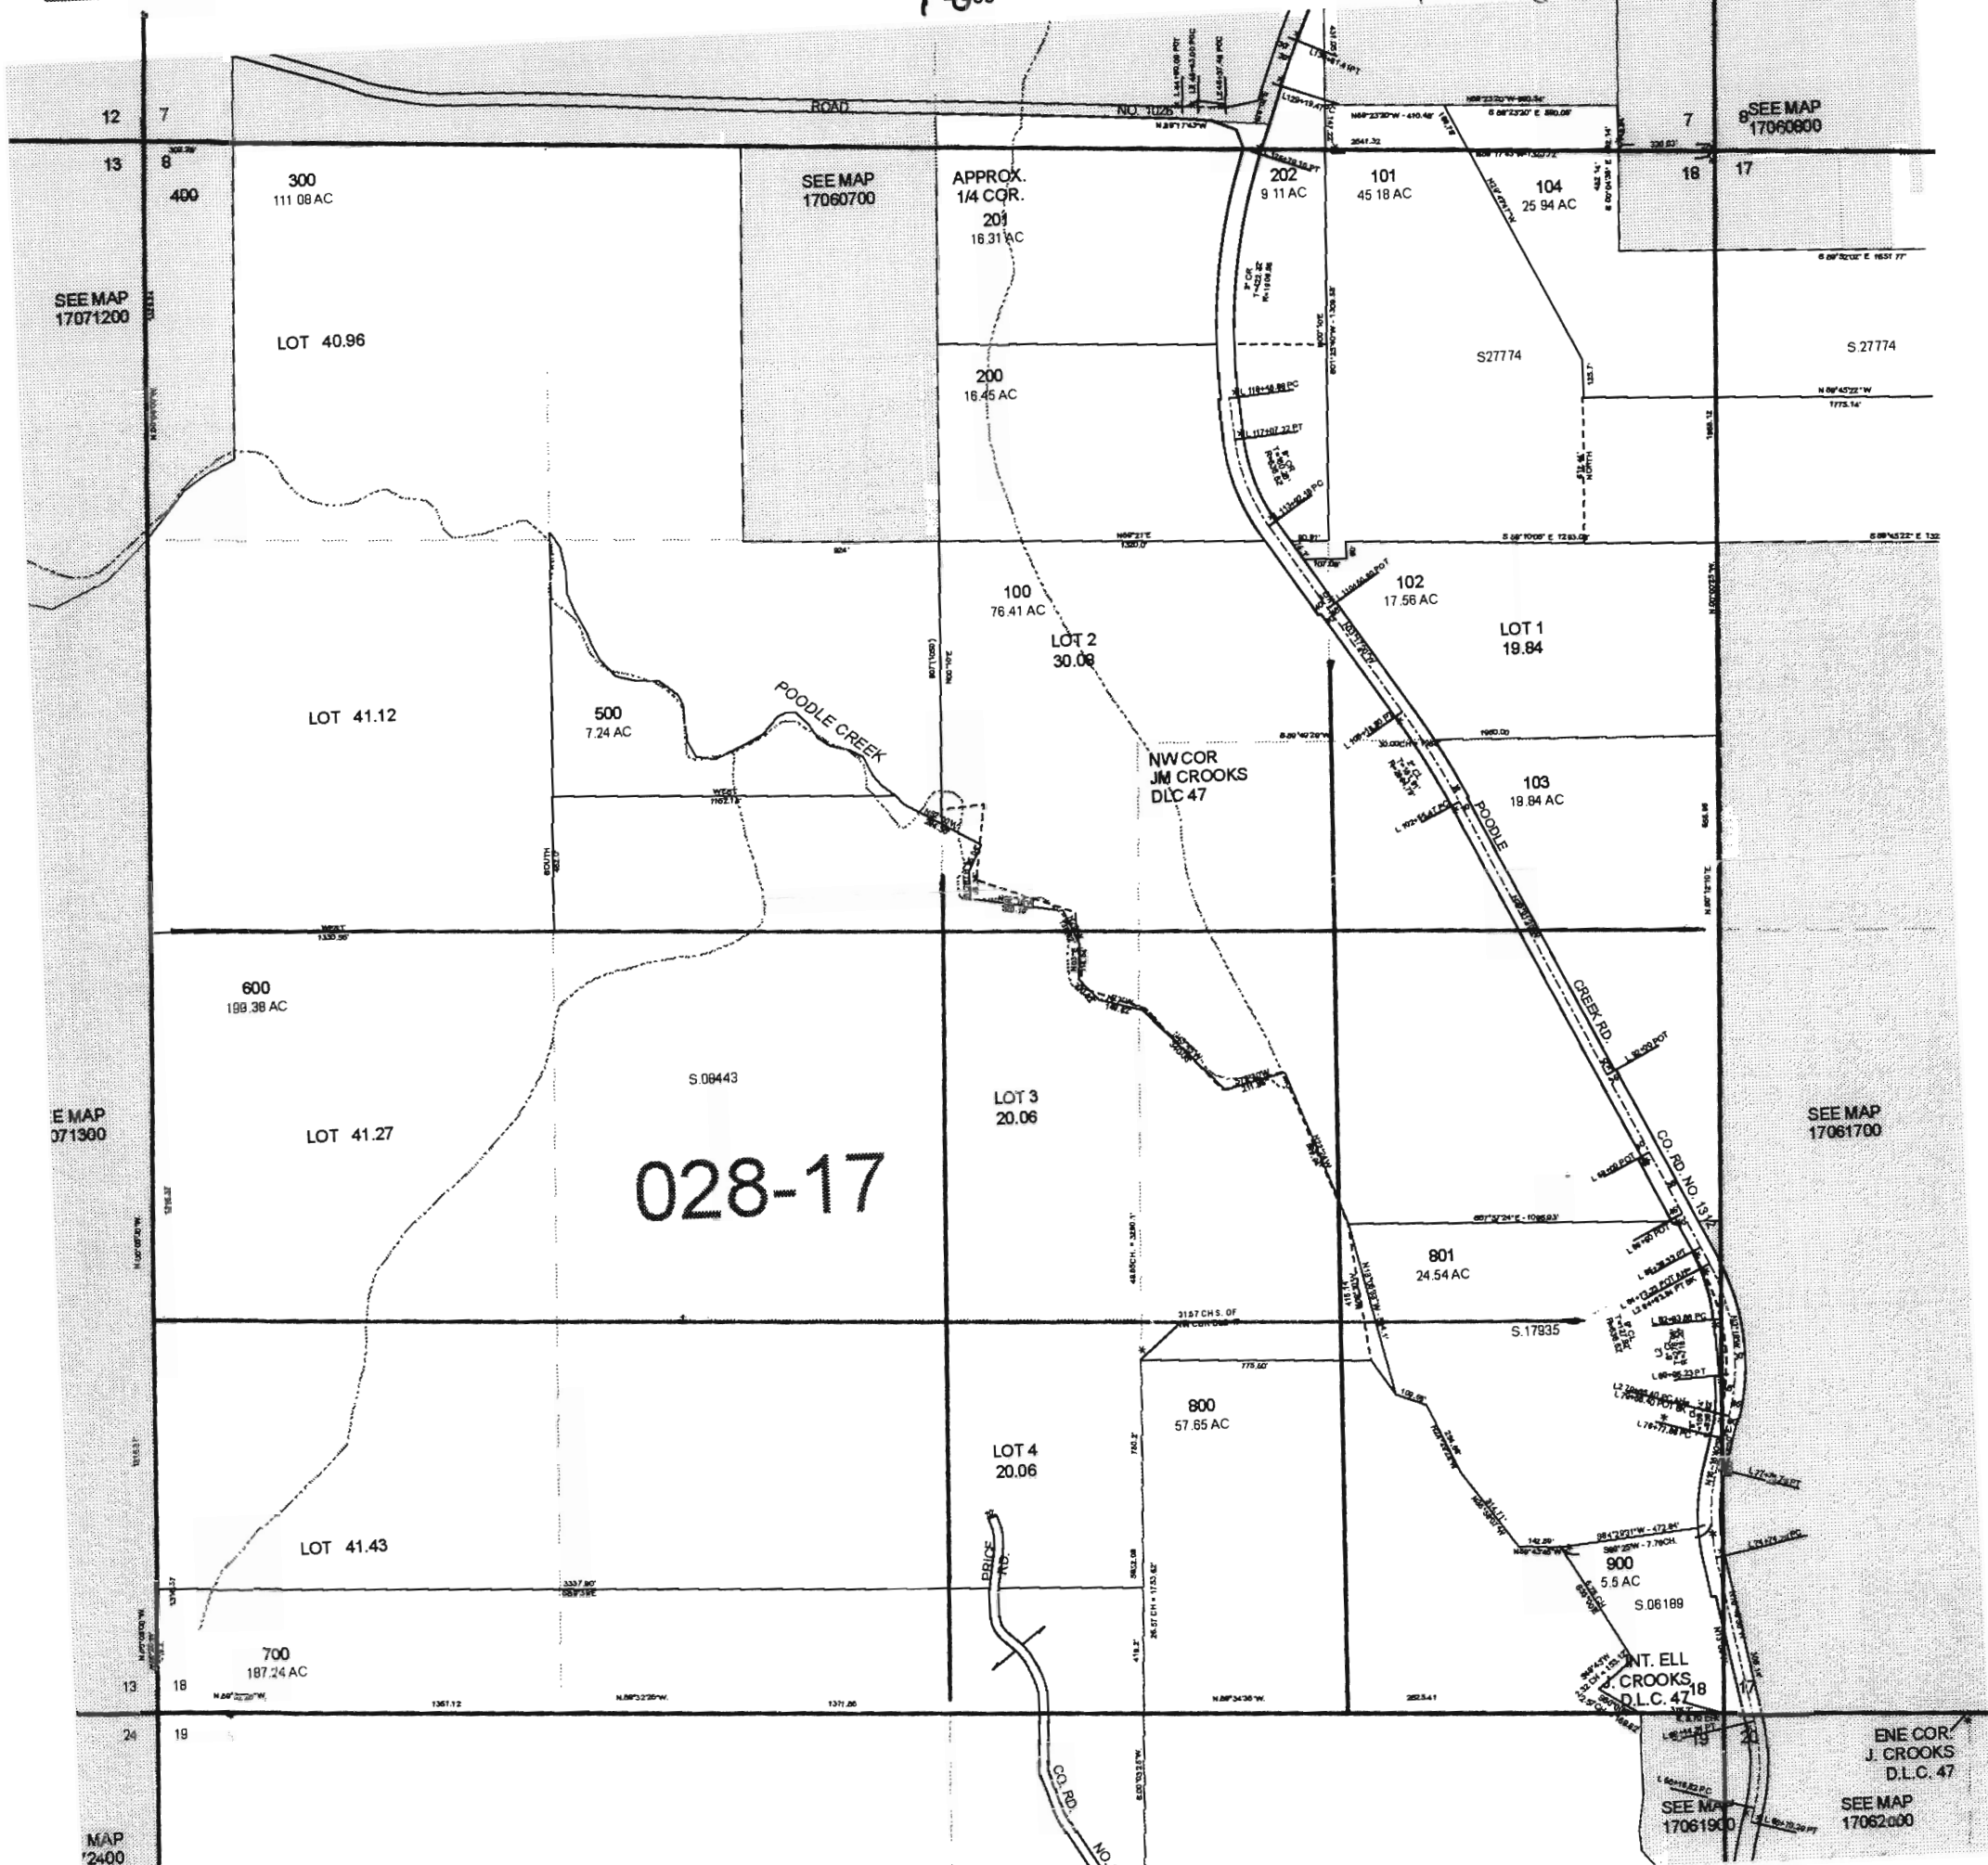


1" = 400'

Oak Pond LLC
Jack Gray
39762 Poodie Cr. Rd.
Noti, OR 97461

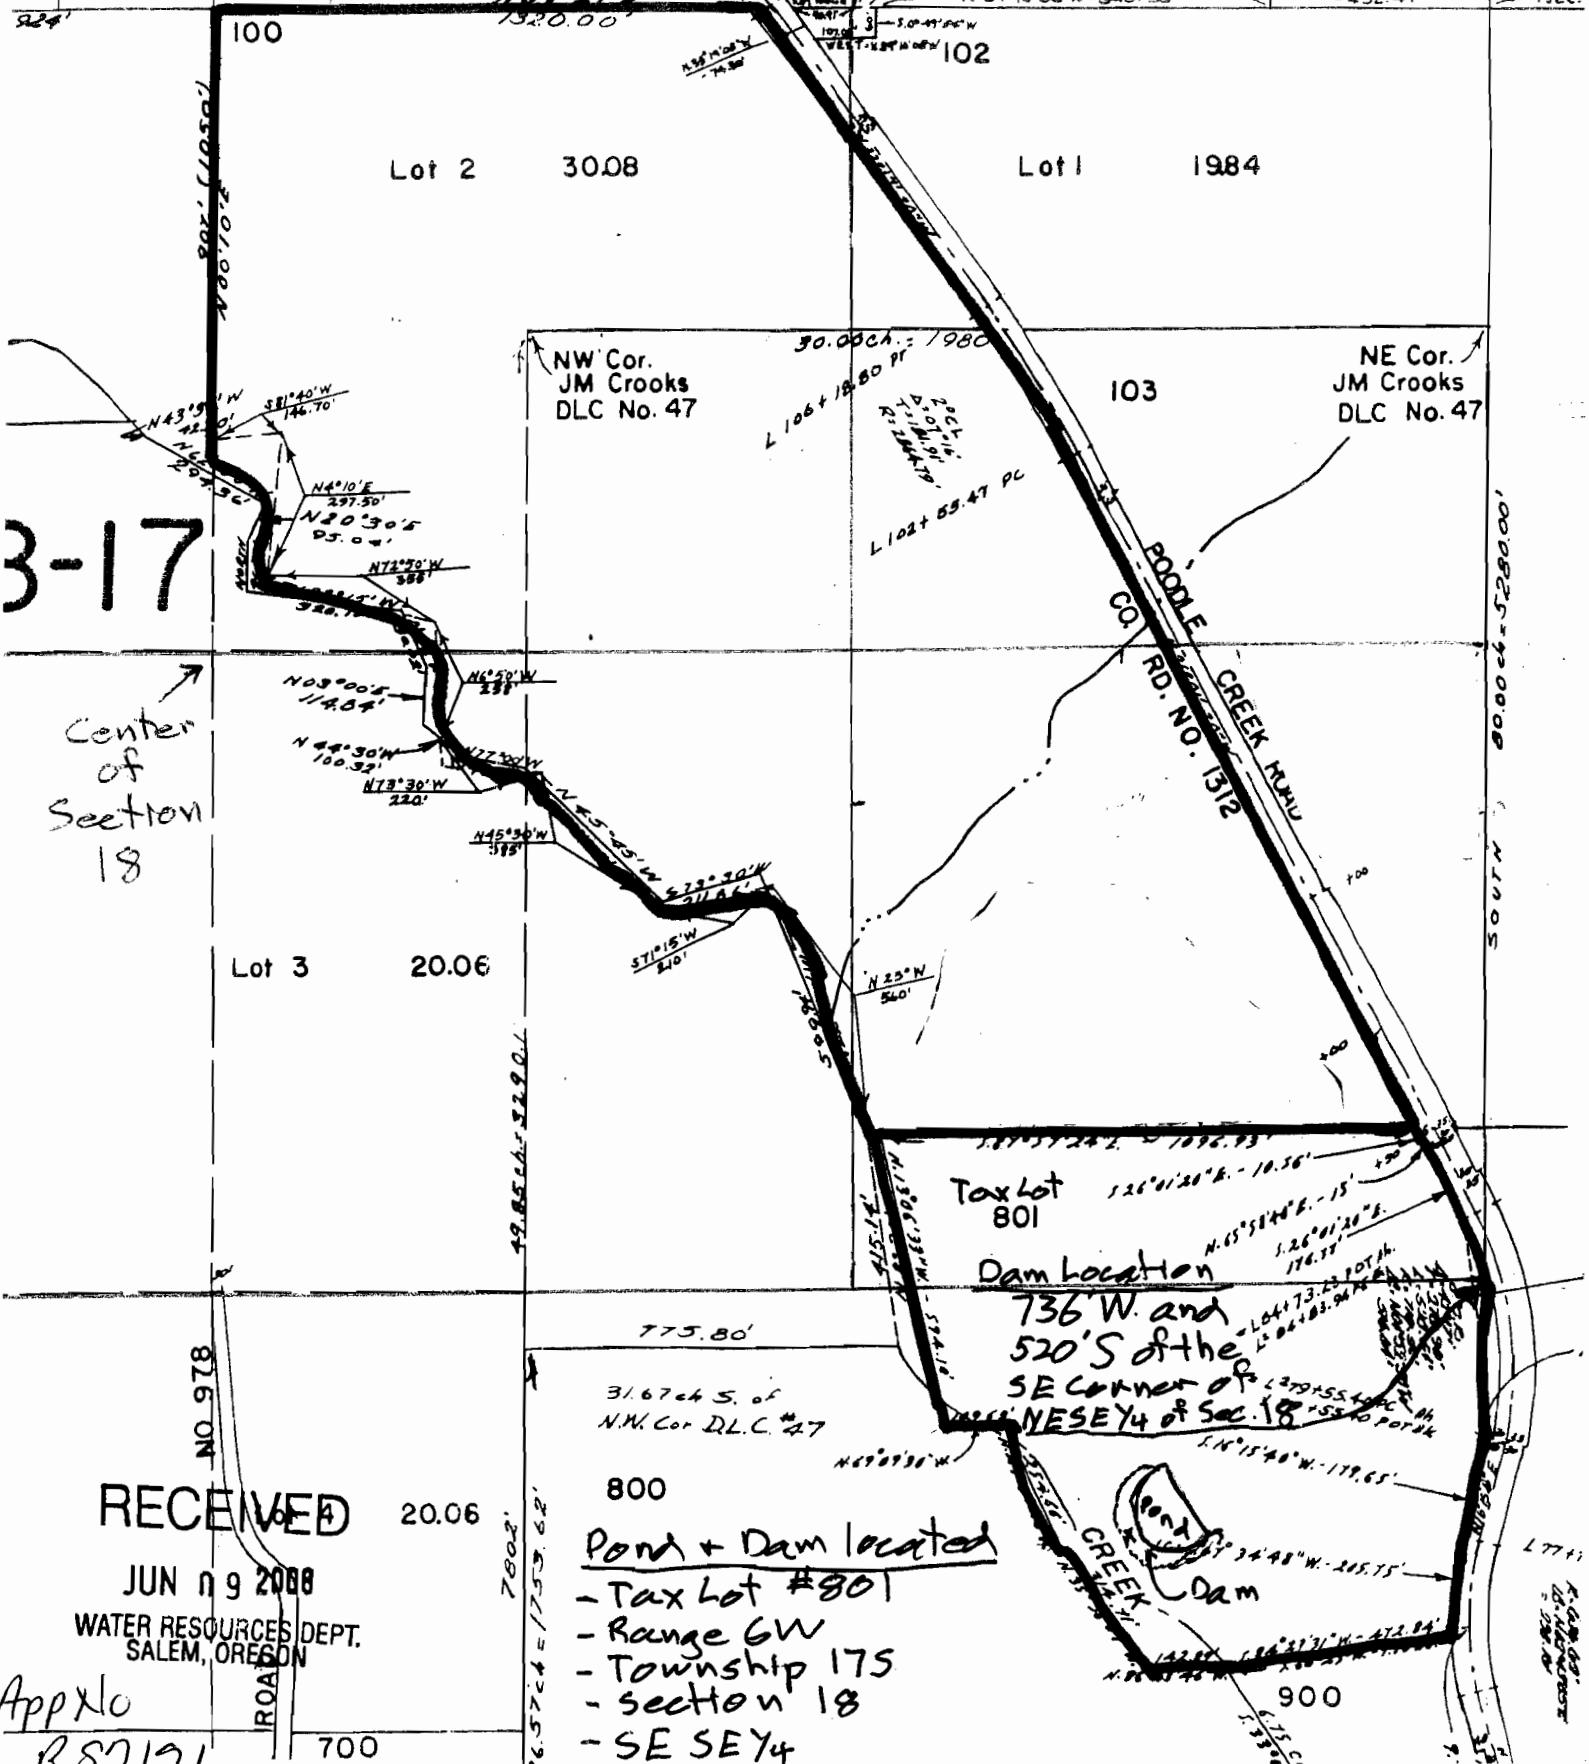

3-17

Center
of
Section
18

RECEIVED

20.06

JUN 19 2008

WATER RESOURCES DEPT.
SALEM, OREGON

App No
R87191

- 800
- Pond + Dam located
- Tax Lot #801
 - Range 6W
 - Township 17S
 - section 18
 - SE SE 1/4