

LANE COUNTY, WILLAMETTE BASIN
T16S, R5W, SEC 14
NE NE $\frac{1}{4}$ NW NE


1" = 400'

RECEIVED



JAN 18 2008

WATER RESOURCES DEPT
SALEM, OREGON

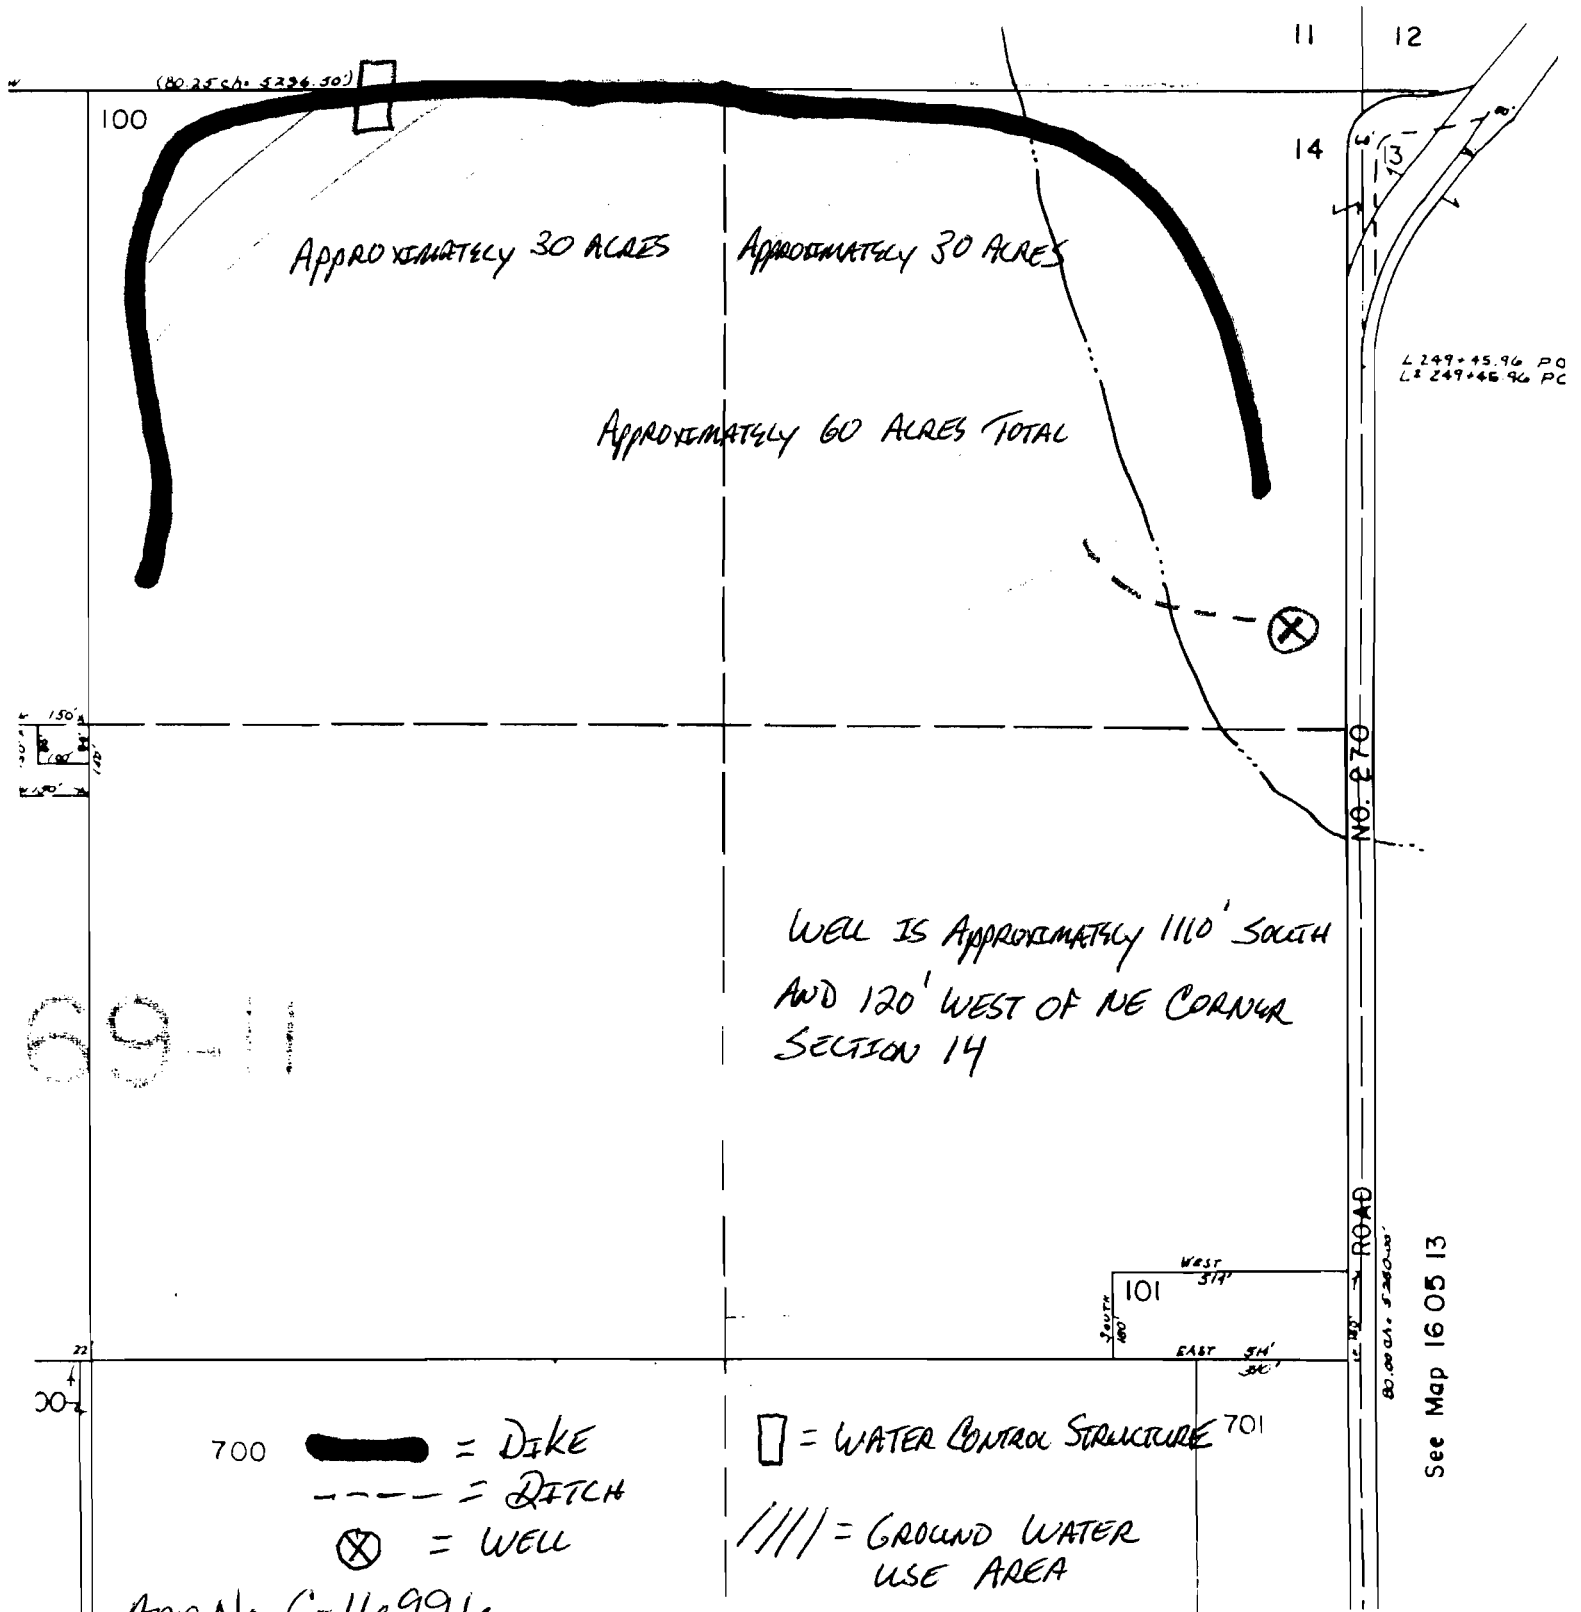

L 249+45.96 PO
L 249+46.96 PC

WELL IS APPROXIMATELY 1110' SOUTH
AND 120' WEST OF NE CORNER
SECTION 14

700

— = DIKE
--- = DITCH
⊗ = WELL

□ = WATER CONTROL STRUCTURE

//// = GROUND WATER
USE AREA

App No G-16996

See Map 1605 13