


NOTES:

1. WELL NO. 1 (WATER RIGHT PERMIT NO. G-3125, CERTIFICATE NO. 41998) HAS FAILED AND HAS BEEN ABANDONED. THE WATER RIGHT HAS BEEN TRANSFERRED TO WELL NO. 5 (TRANSFER 7867).
2. WELL NO. 3 (WATER RIGHT PERMIT NO. G-3531, CERTIFICATE NO. 41999) IS NO LONGER IN SERVICE AND IS TO BE ABANDONED.
3. WELL NO. 4 (WATER RIGHT PERMIT NO. G-3531, CERTIFICATE NO. 41999) IS CURRENTLY IN SERVICE.
4. WELL NO. 5 WAS CONSTRUCTED IN 1996 AND THE WATER RIGHT WAS TRANSFERRED FROM WELL NO. 1 (WATER RIGHTS TRANSFER 7867).
5. WELL NO. 6 (WATER RIGHT PERMIT NO. G-15927) IS CURRENTLY IN SERVICE.
6. WELL NO. 7 (WATER RIGHT PERMIT NO. G-15927) IS CURRENTLY IN SERVICE.
7. THE CITY IS CURRENTLY APPLYING FOR A WATER RIGHT PERMIT FOR WELL NO. 8.
8. ALL WATER USE IS WITHIN THE HARRISBURG CITY LIMITS.

App No G-116950

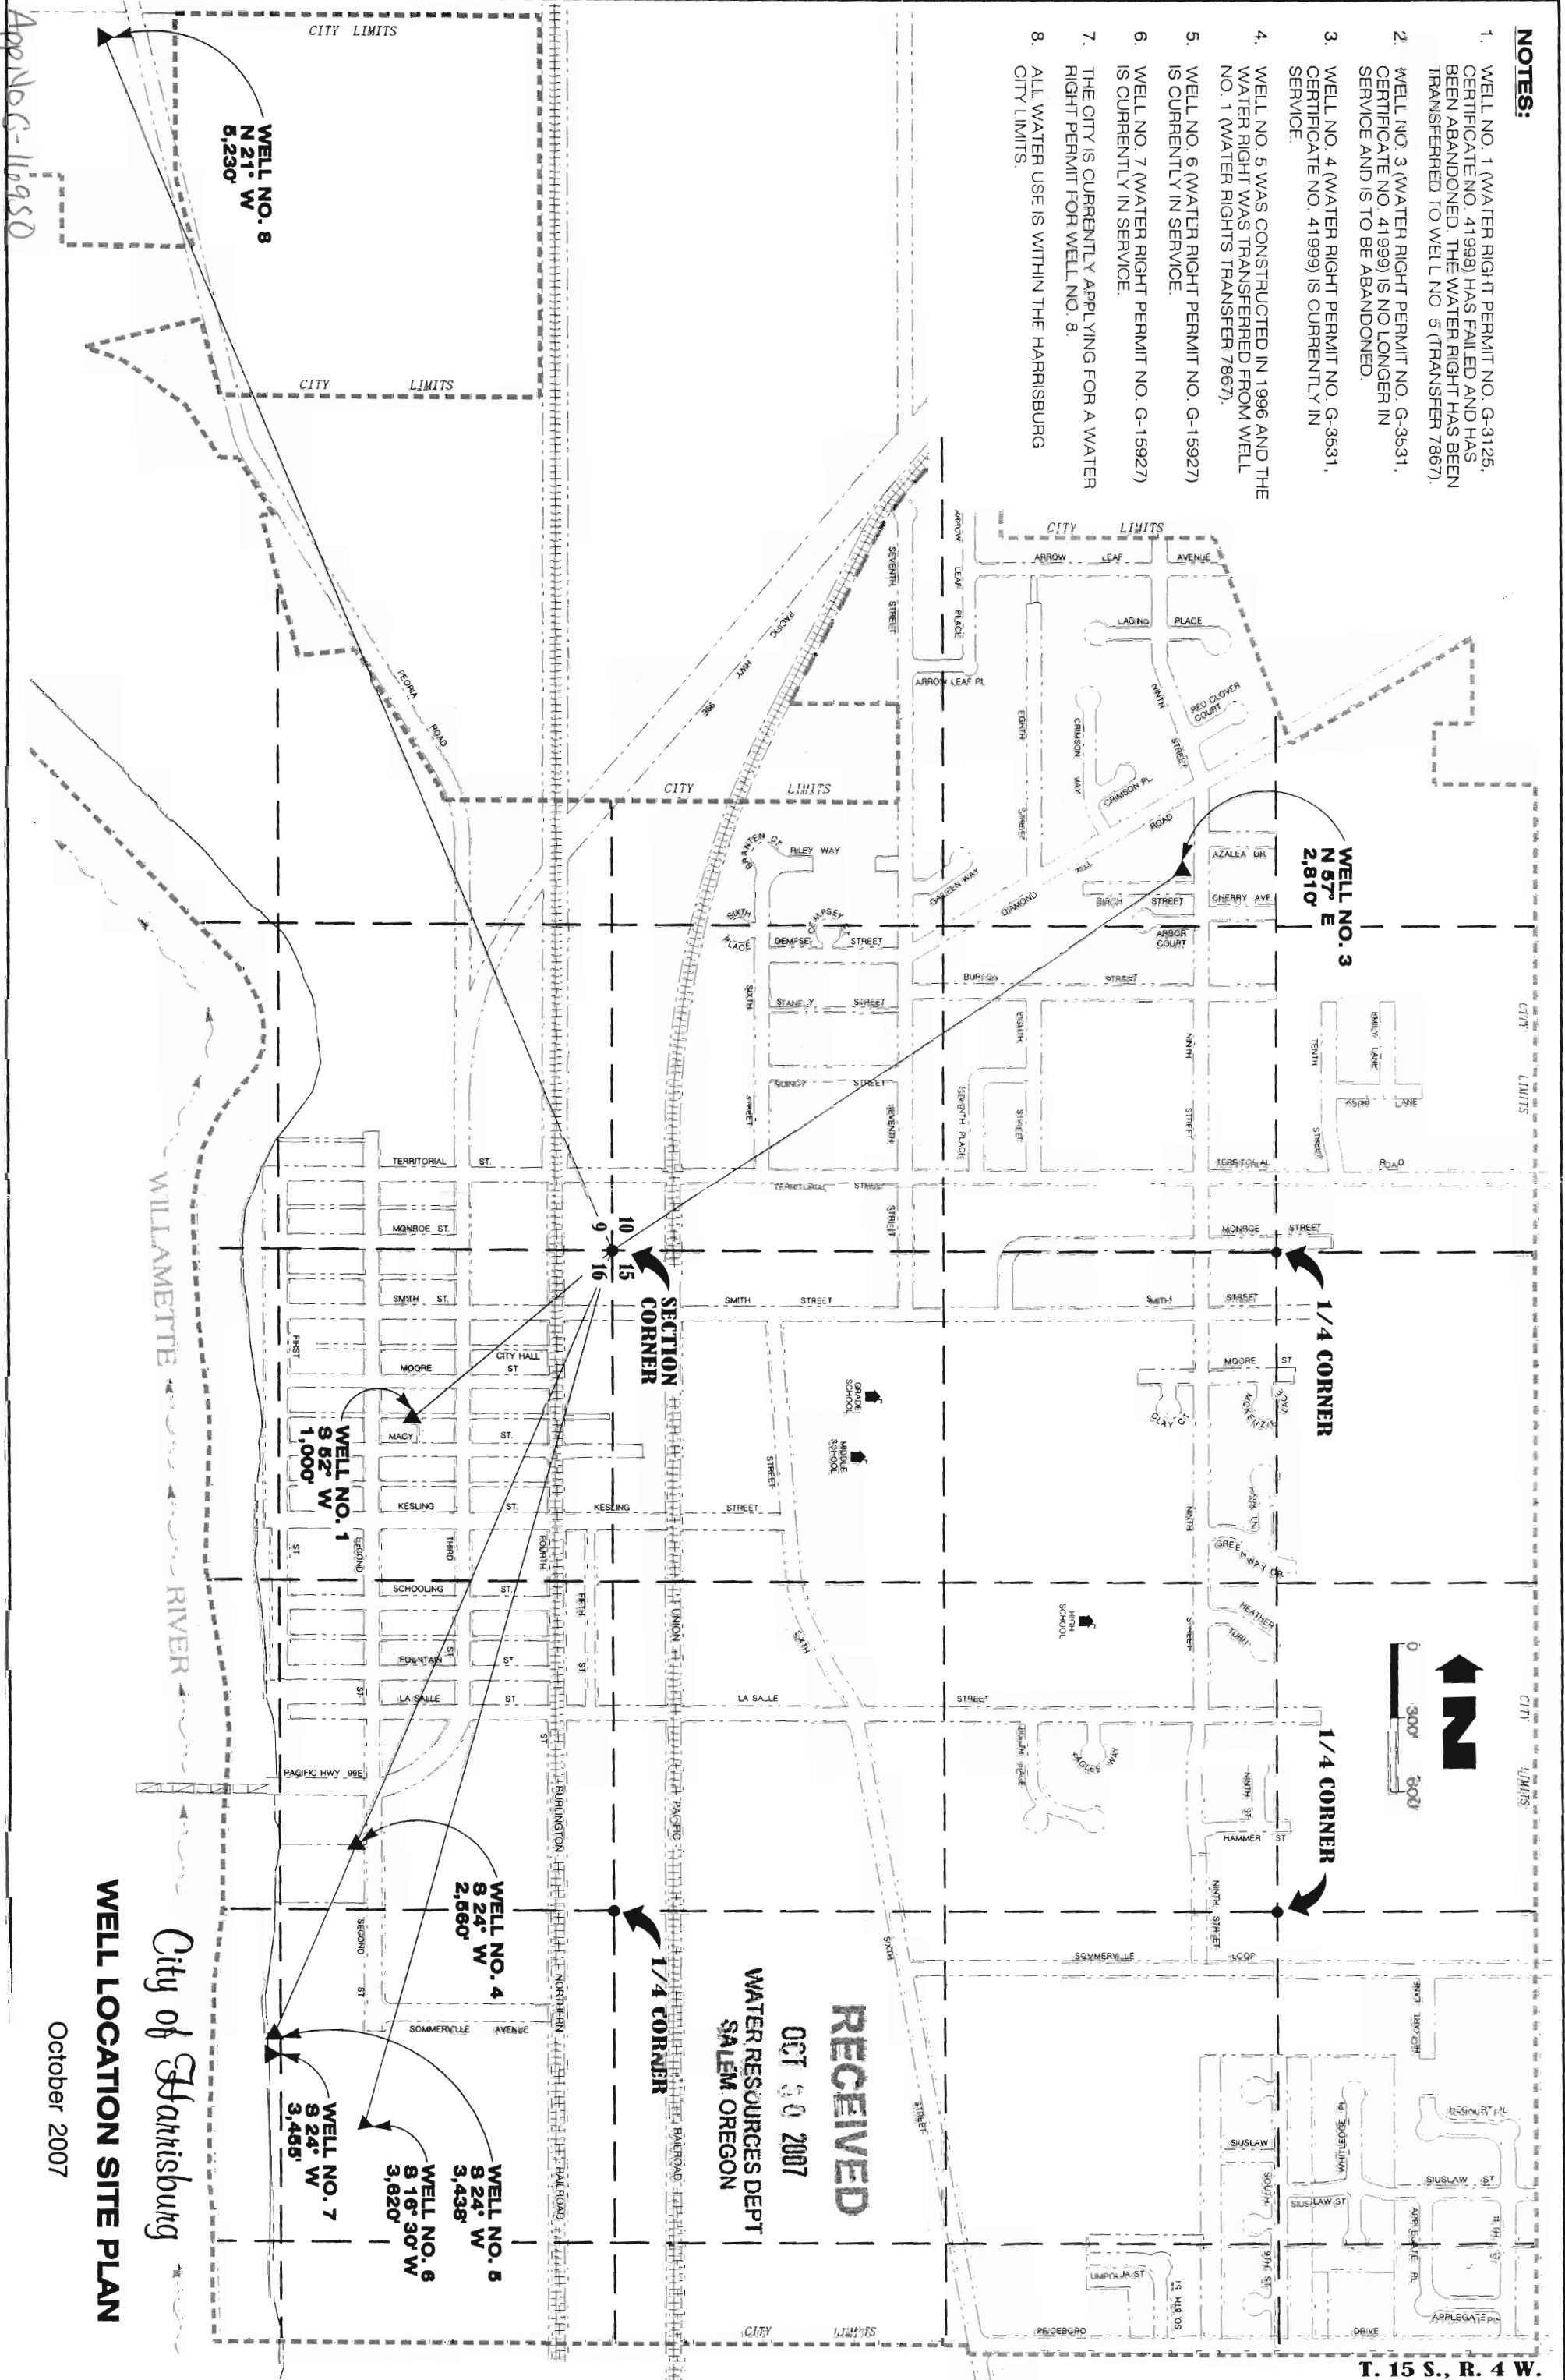

T. 15 S., R. 4 W.

WELL LOCATION SITE PLAN

October 2007