Cunha Ranch
Map# 03S36E
Tax Lot 700

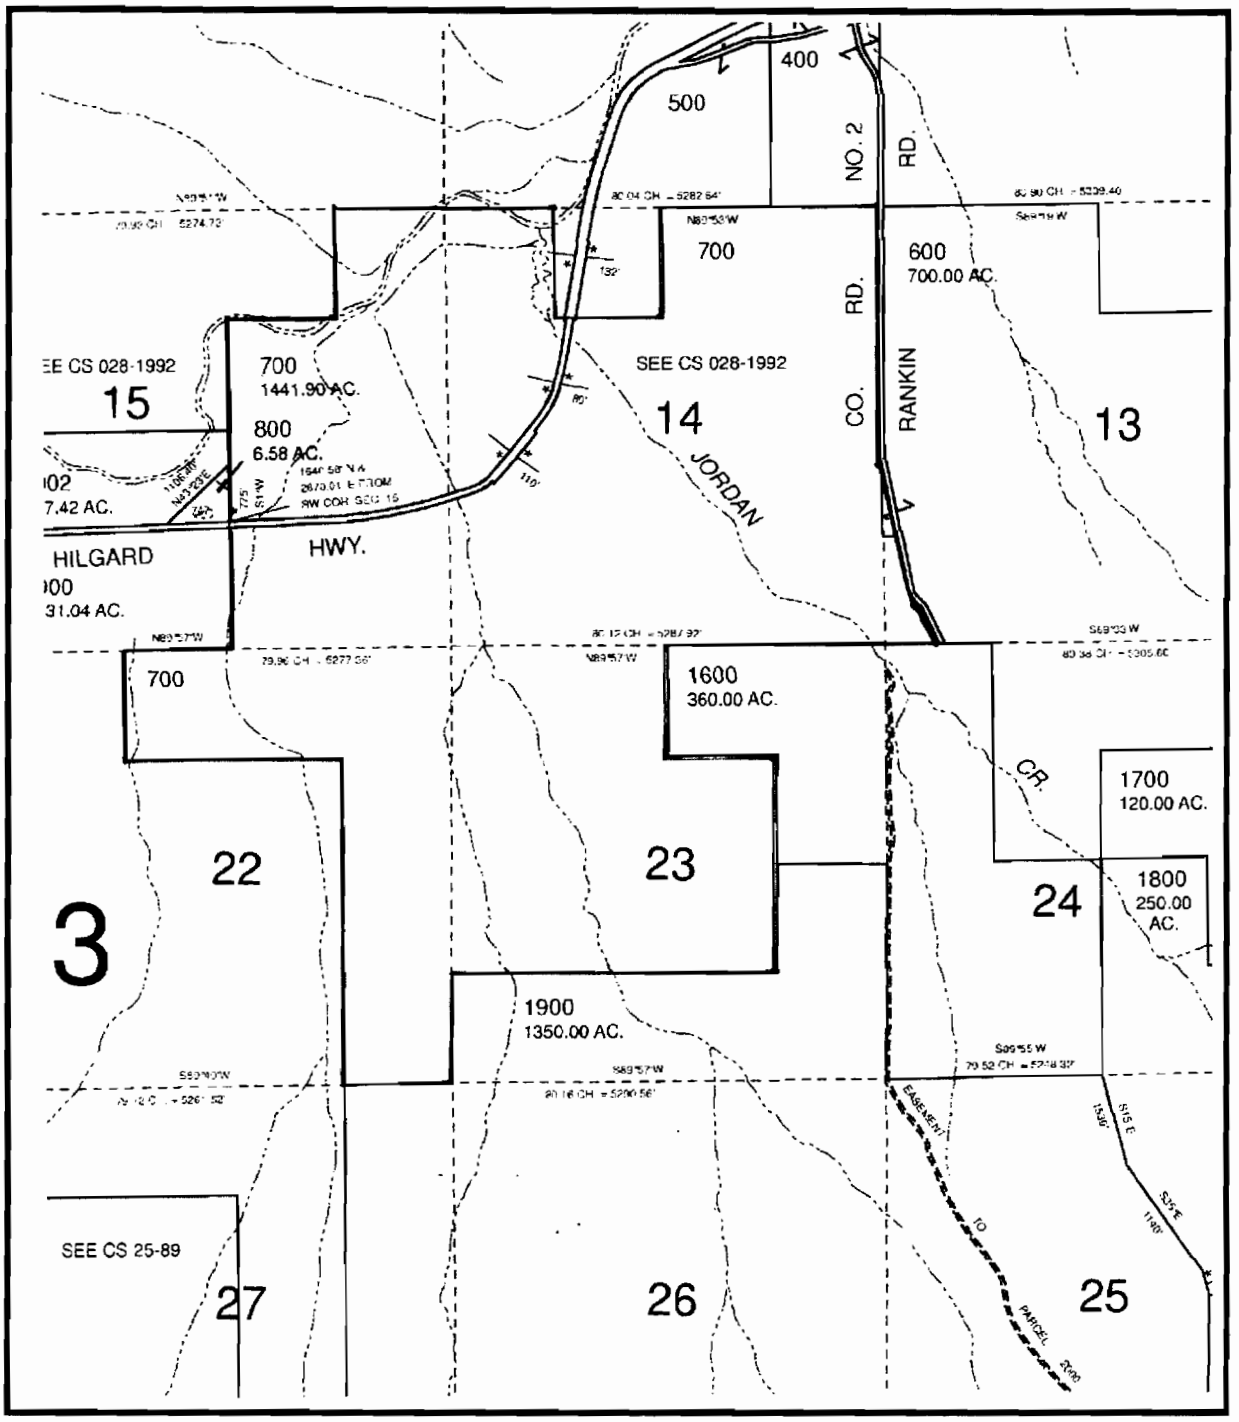

- *Prospective purchaser should verify all information on their own behalf or have verified by their own representative.*

For additional information contact:
INTERMOUNTAIN REALTY, INC.
1425 Campbell Street, Baker City, OR 97814
Office: 541.523.4434 / Fax: 541.523.9452

RECEIVED
MAR 0 3 2008
WATER RESOURCES DEPT
SALEM, OREGON

SECTION PLAT

Section 14, 15, 22, 23 Township 3 South Range 36 East

County of Union State of Oregon

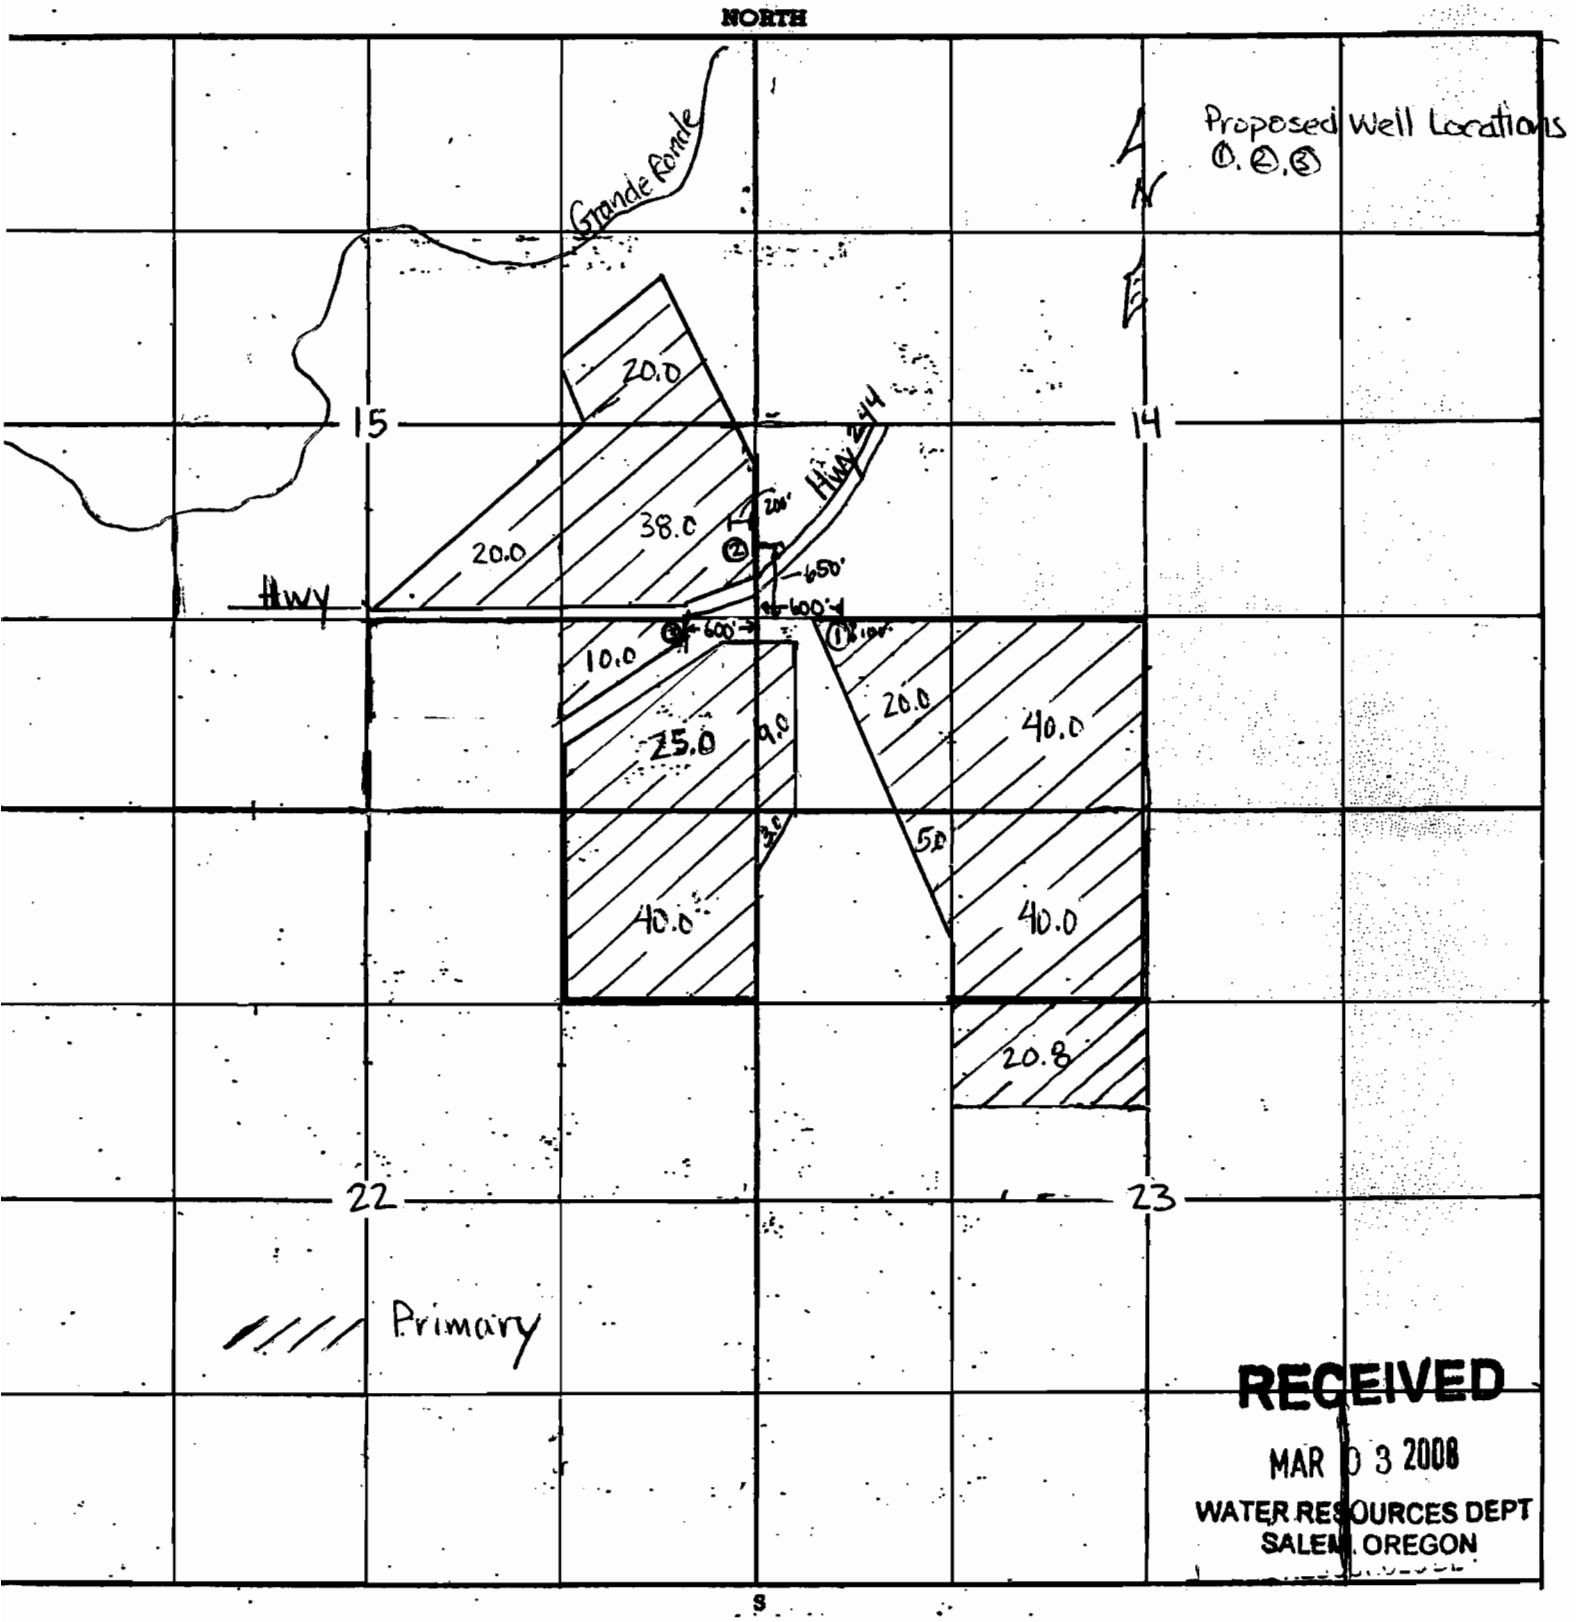

RECEIVED
MAR 0 3 2008
WATER RESOURCES DEPT
SALEM, OREGON

Remarks scale 4" = 1 mile - All in Tax Lot 700
Proposed Well Locations are aproximated

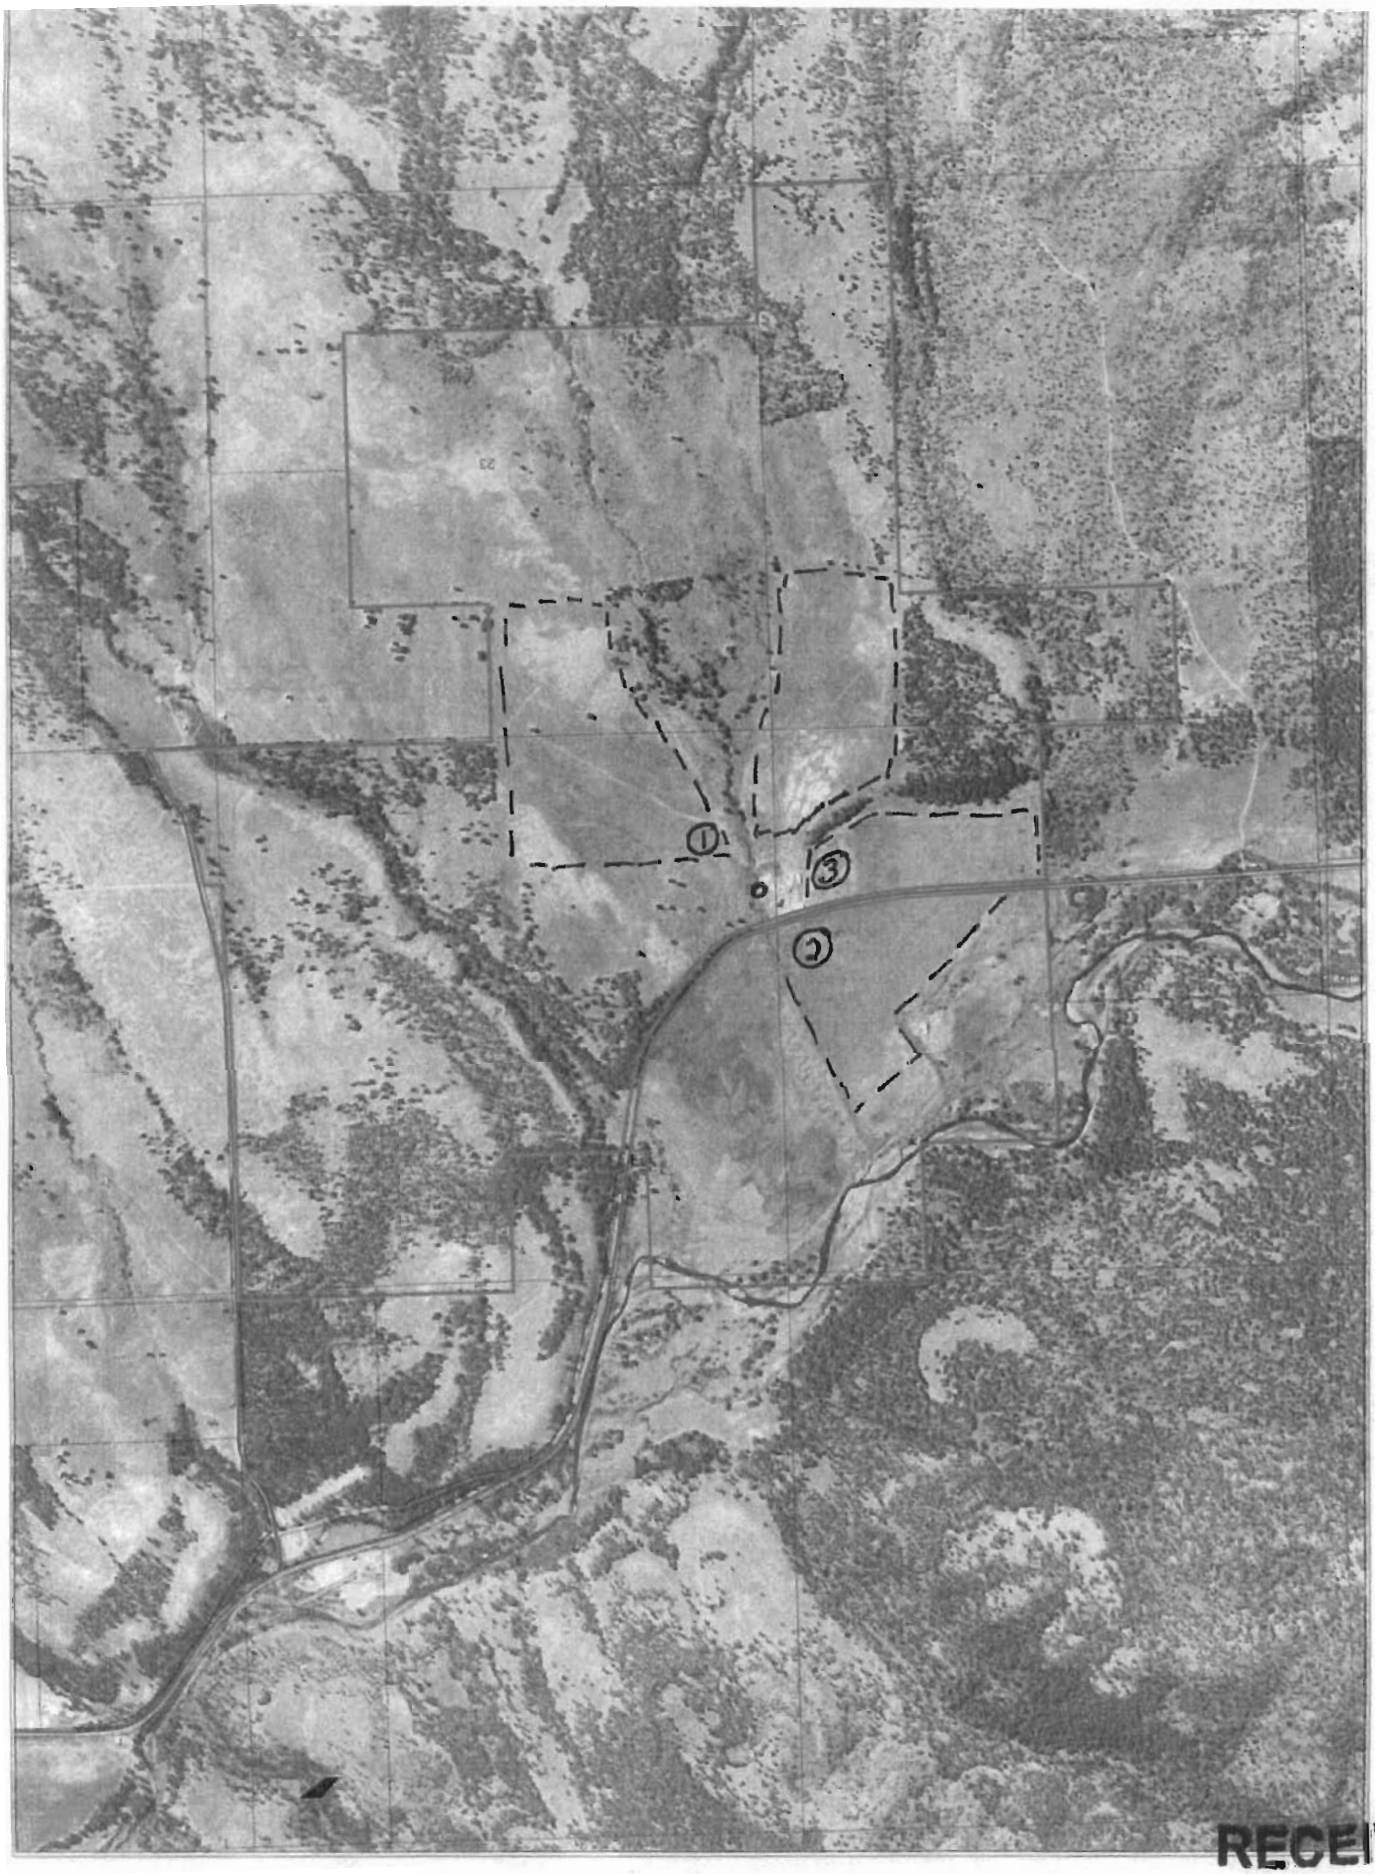

RECEIVED

MAR 0 3 2008

WATER RESOURCES DEPT
SALEM, OREGON

----- FIELDS TO IRRIGATE

① - ② ③ POSSIBLE WELL SITES

Laura A. Schroeder
Licensed in Oregon, Idaho, Nevada and Washington

V. Scott Borison, Ph.D.
Certified Legal Manager

Daryl N. Cole
Office Manager

SCHROEDER
LAW OFFICES, P.C.

Lynn L. Steyaert
Licensed in Oregon and Nevada

Cortney D. Duke
Licensed in Oregon and Nevada

Colm Moore
Licensed in Oregon and Nevada

Therese A. Ure
Licensed in Nevada

Wyatt E. Rolfe
Licensed in Oregon and Nevada

March 11, 2008

VIA US MAIL

RECEIVED
MAR 12 2008
WATER RESOURCES DEPT
SALEM, OREGON

Oregon Water Resources Department
ATTN: Herb Mosgar
725 Summer Street N.E. Suite A
Salem, OR 97301-4172

RE: Daniel Heath
Application G-17016

To Mr. Mosgar:

Pursuant to your request for clarification of the location of proposed well site number three (3), enclosed please find an updated map to be filed with the original application. Please replace the original map submitted with the map enclosed herein. Also enclosed, please find additional funds in the amount of $400.00 to cover the Department's fees associated with review of the two additional proposed well sites. Based on our conversations with you, we understand that these sites will be evaluated as additional points of diversion, even though the applicant only intends to develop one well at the most desirable location.

We will provide the temporary permit from the Oregon Department of Transportation, authorizing access to the highway shortly. Please contact me if anything further is needed to complete the above application.

Very truly yours,

SCHROEDER LAW OFFICES, P.C.

Tara J. Jackson, paralegal for
Laura A. Schroeder

TJJ:tjj

Enclosures

cc: Client

SECTION PLAT

Section 14,15,22,23 Township 3 South Range 36 East

County of Union State of Oregon

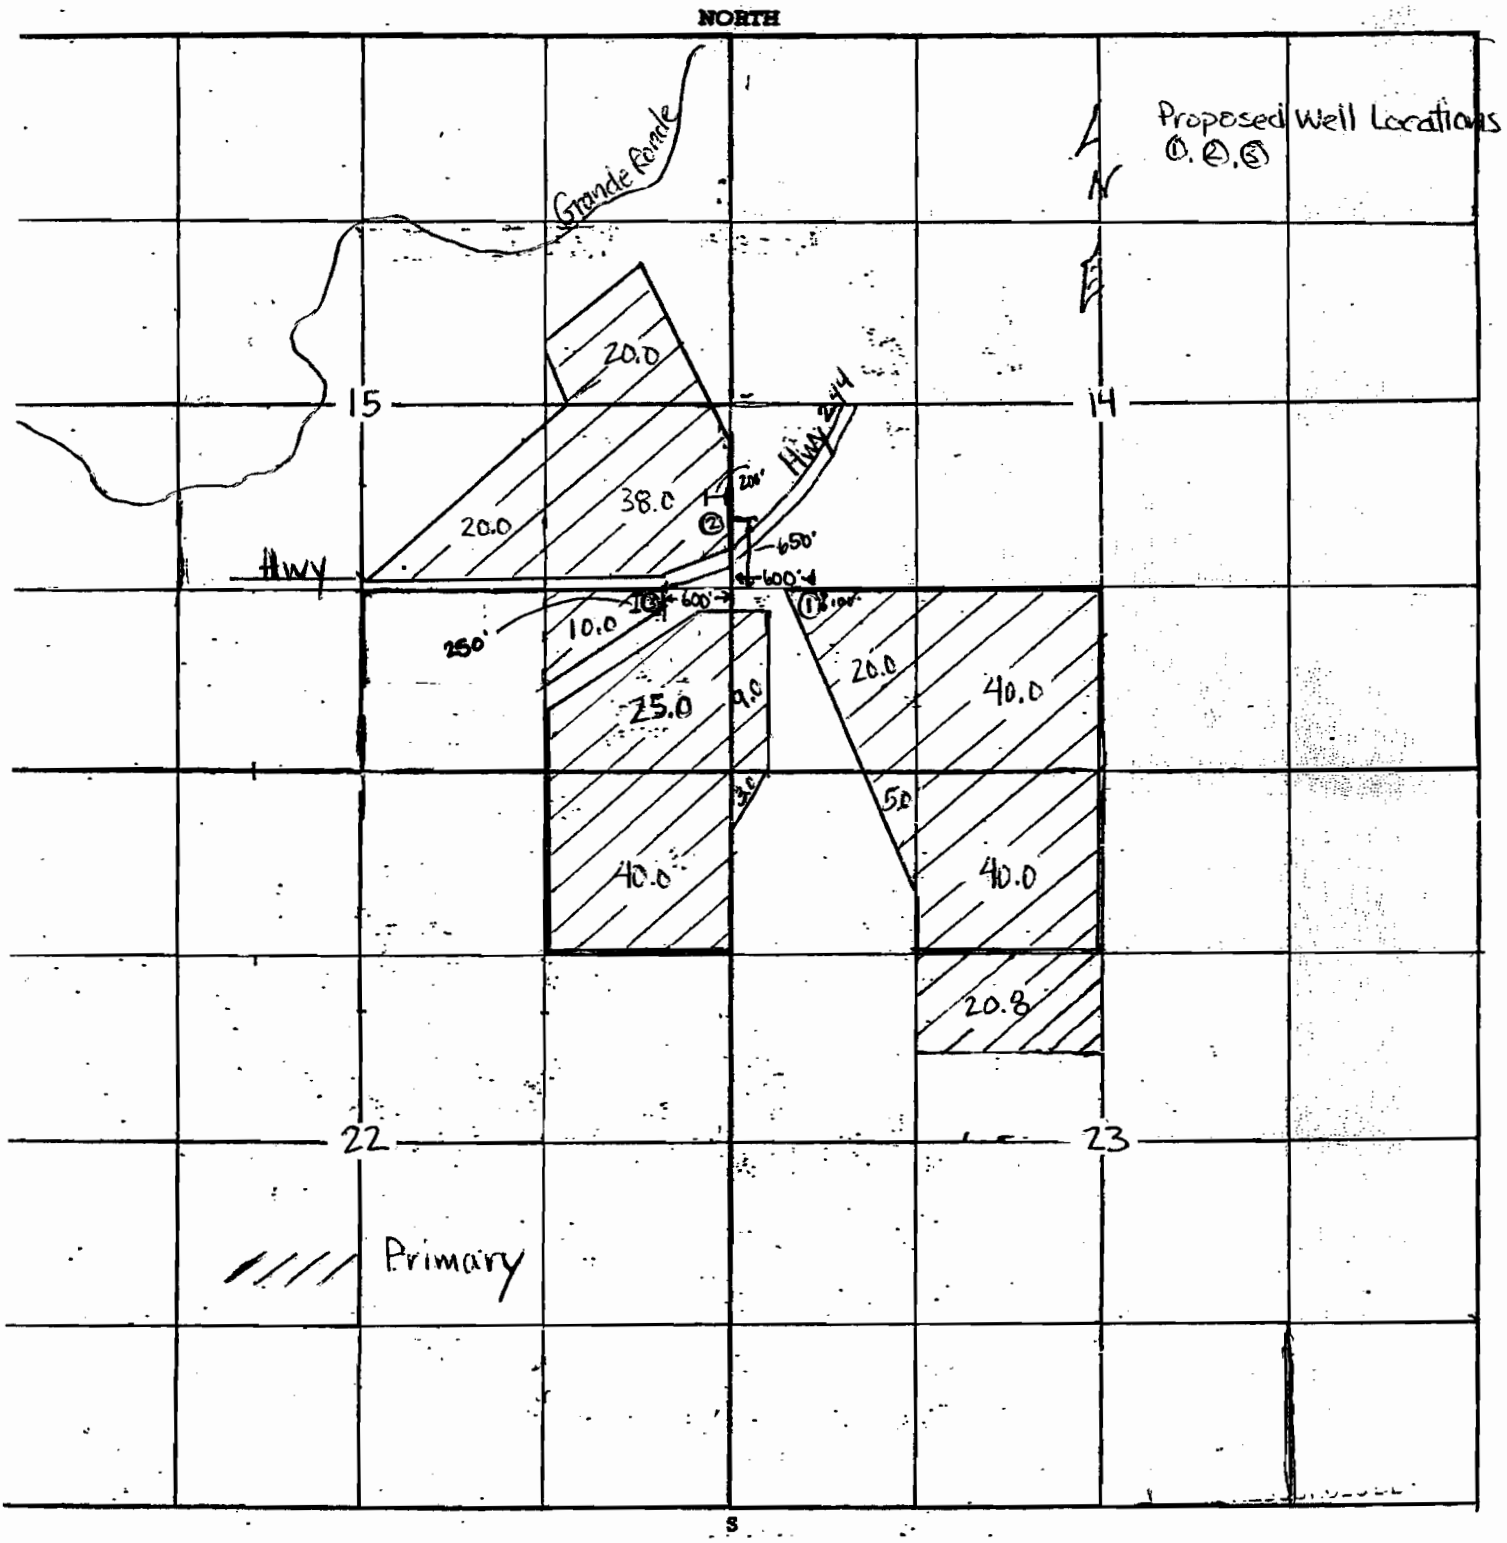

Remarks scale 4" = 1 mile - All in Tax Lot 700

Proposed well locations are aproximated

RECEIVED

MAR 12 2008

WATER RESOURCES DEPT
SALEM, OREGON