


T. 1S., R. 25E., W. M.

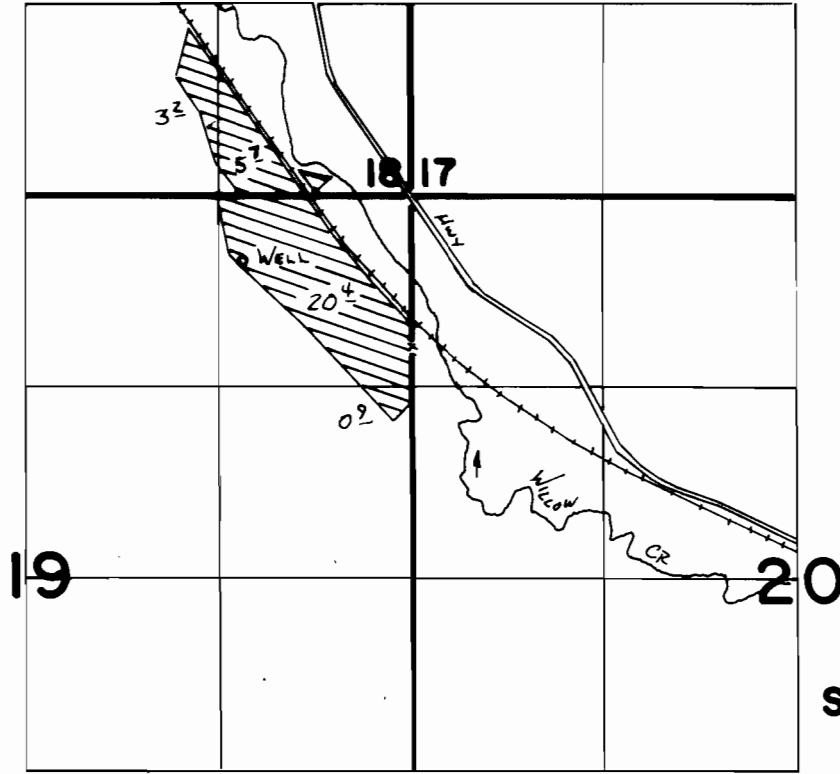

SCALE 1" = 1320'

WELL LOCATED 440'S. & 1160' W. FROM NE COR. SEC. 19

FINAL PROOF SURVEY
UNDER

Application No. ~~G:8400~~ Permit No. ~~G:7611~~.....
IN NAME OF

.....**CHARLES C. JONES**.....

Surveyed 11-4..... 1987, by V.L. CHURCH.....