

# SECTION PLAT


Section 13

Township 23-5

Range 32.5-E

County of Harney State of OR

NORTH

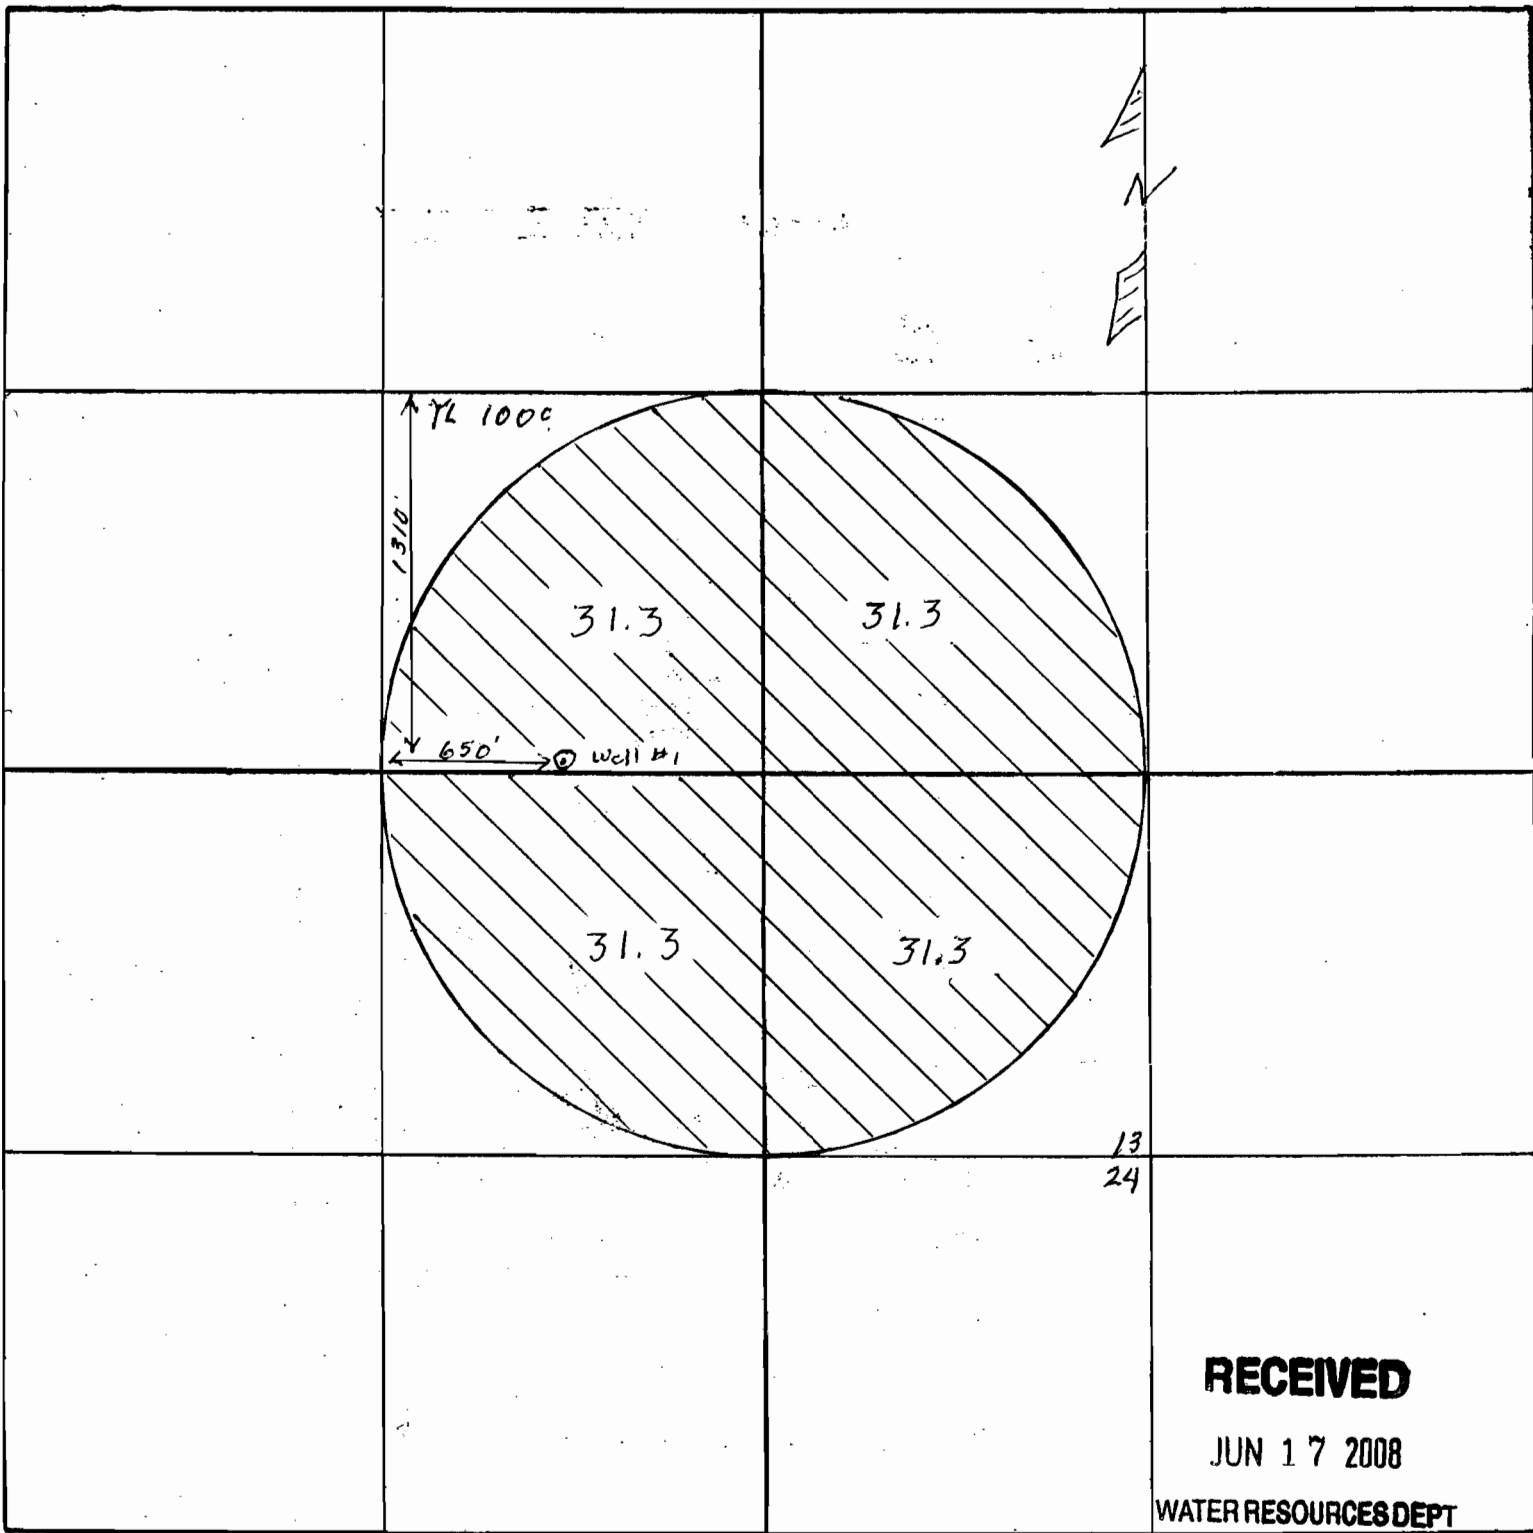

**RECEIVED**

JUN 17 2008

WATER RESOURCES DEPT  
SALEM, OREGON

Remarks scale - 8" = 1 mile - 660' -