

SECTION PLAT

Section 3


Township 24-S

Range 33-E

County of Harney

State of OR

NORTH

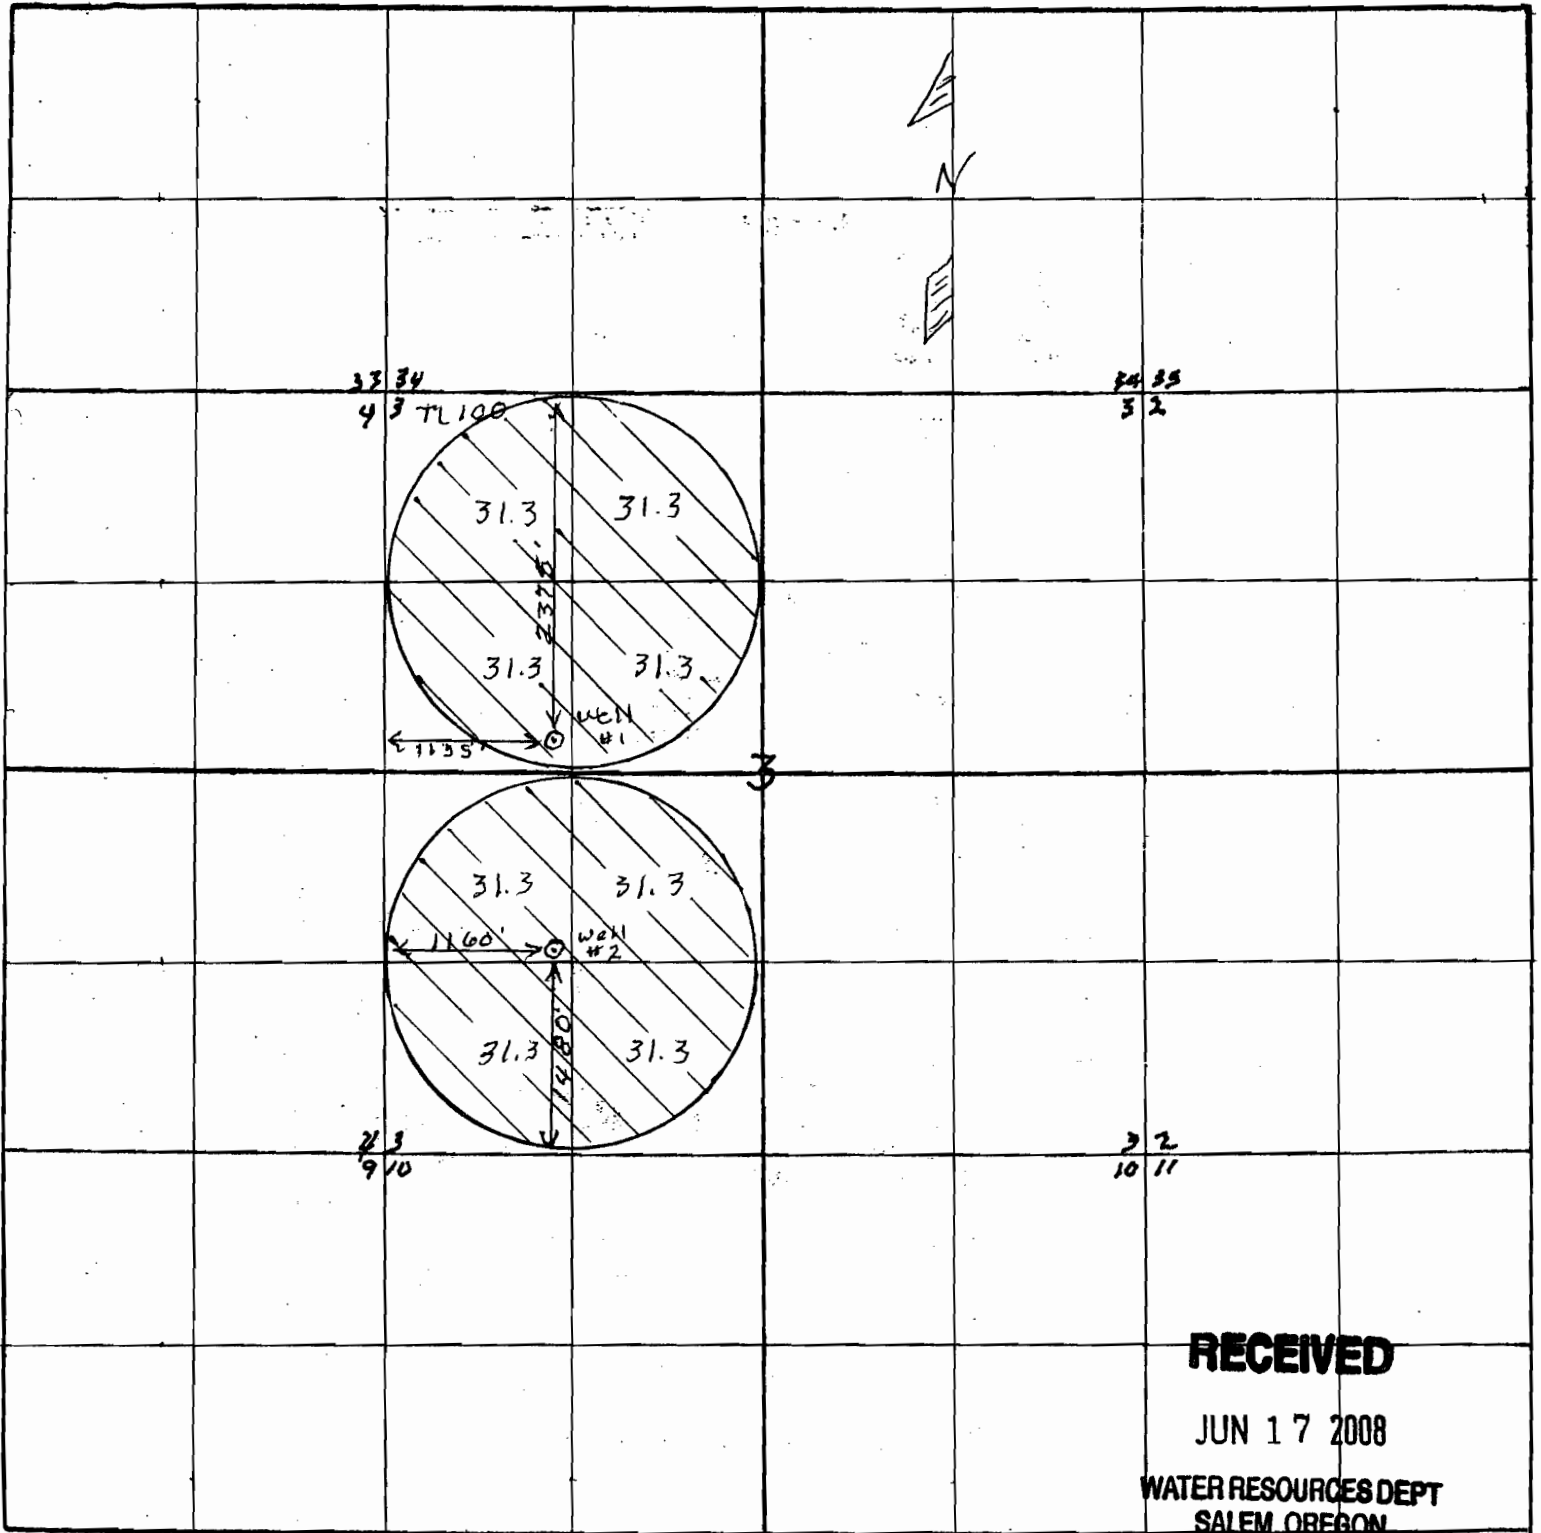

RECEIVED

JUN 17 2008

WATER RESOURCES DEPT
SALEM, OREGON

3

Remarks scale - 4" = 1 mile - 660' - 1" = 1320'