


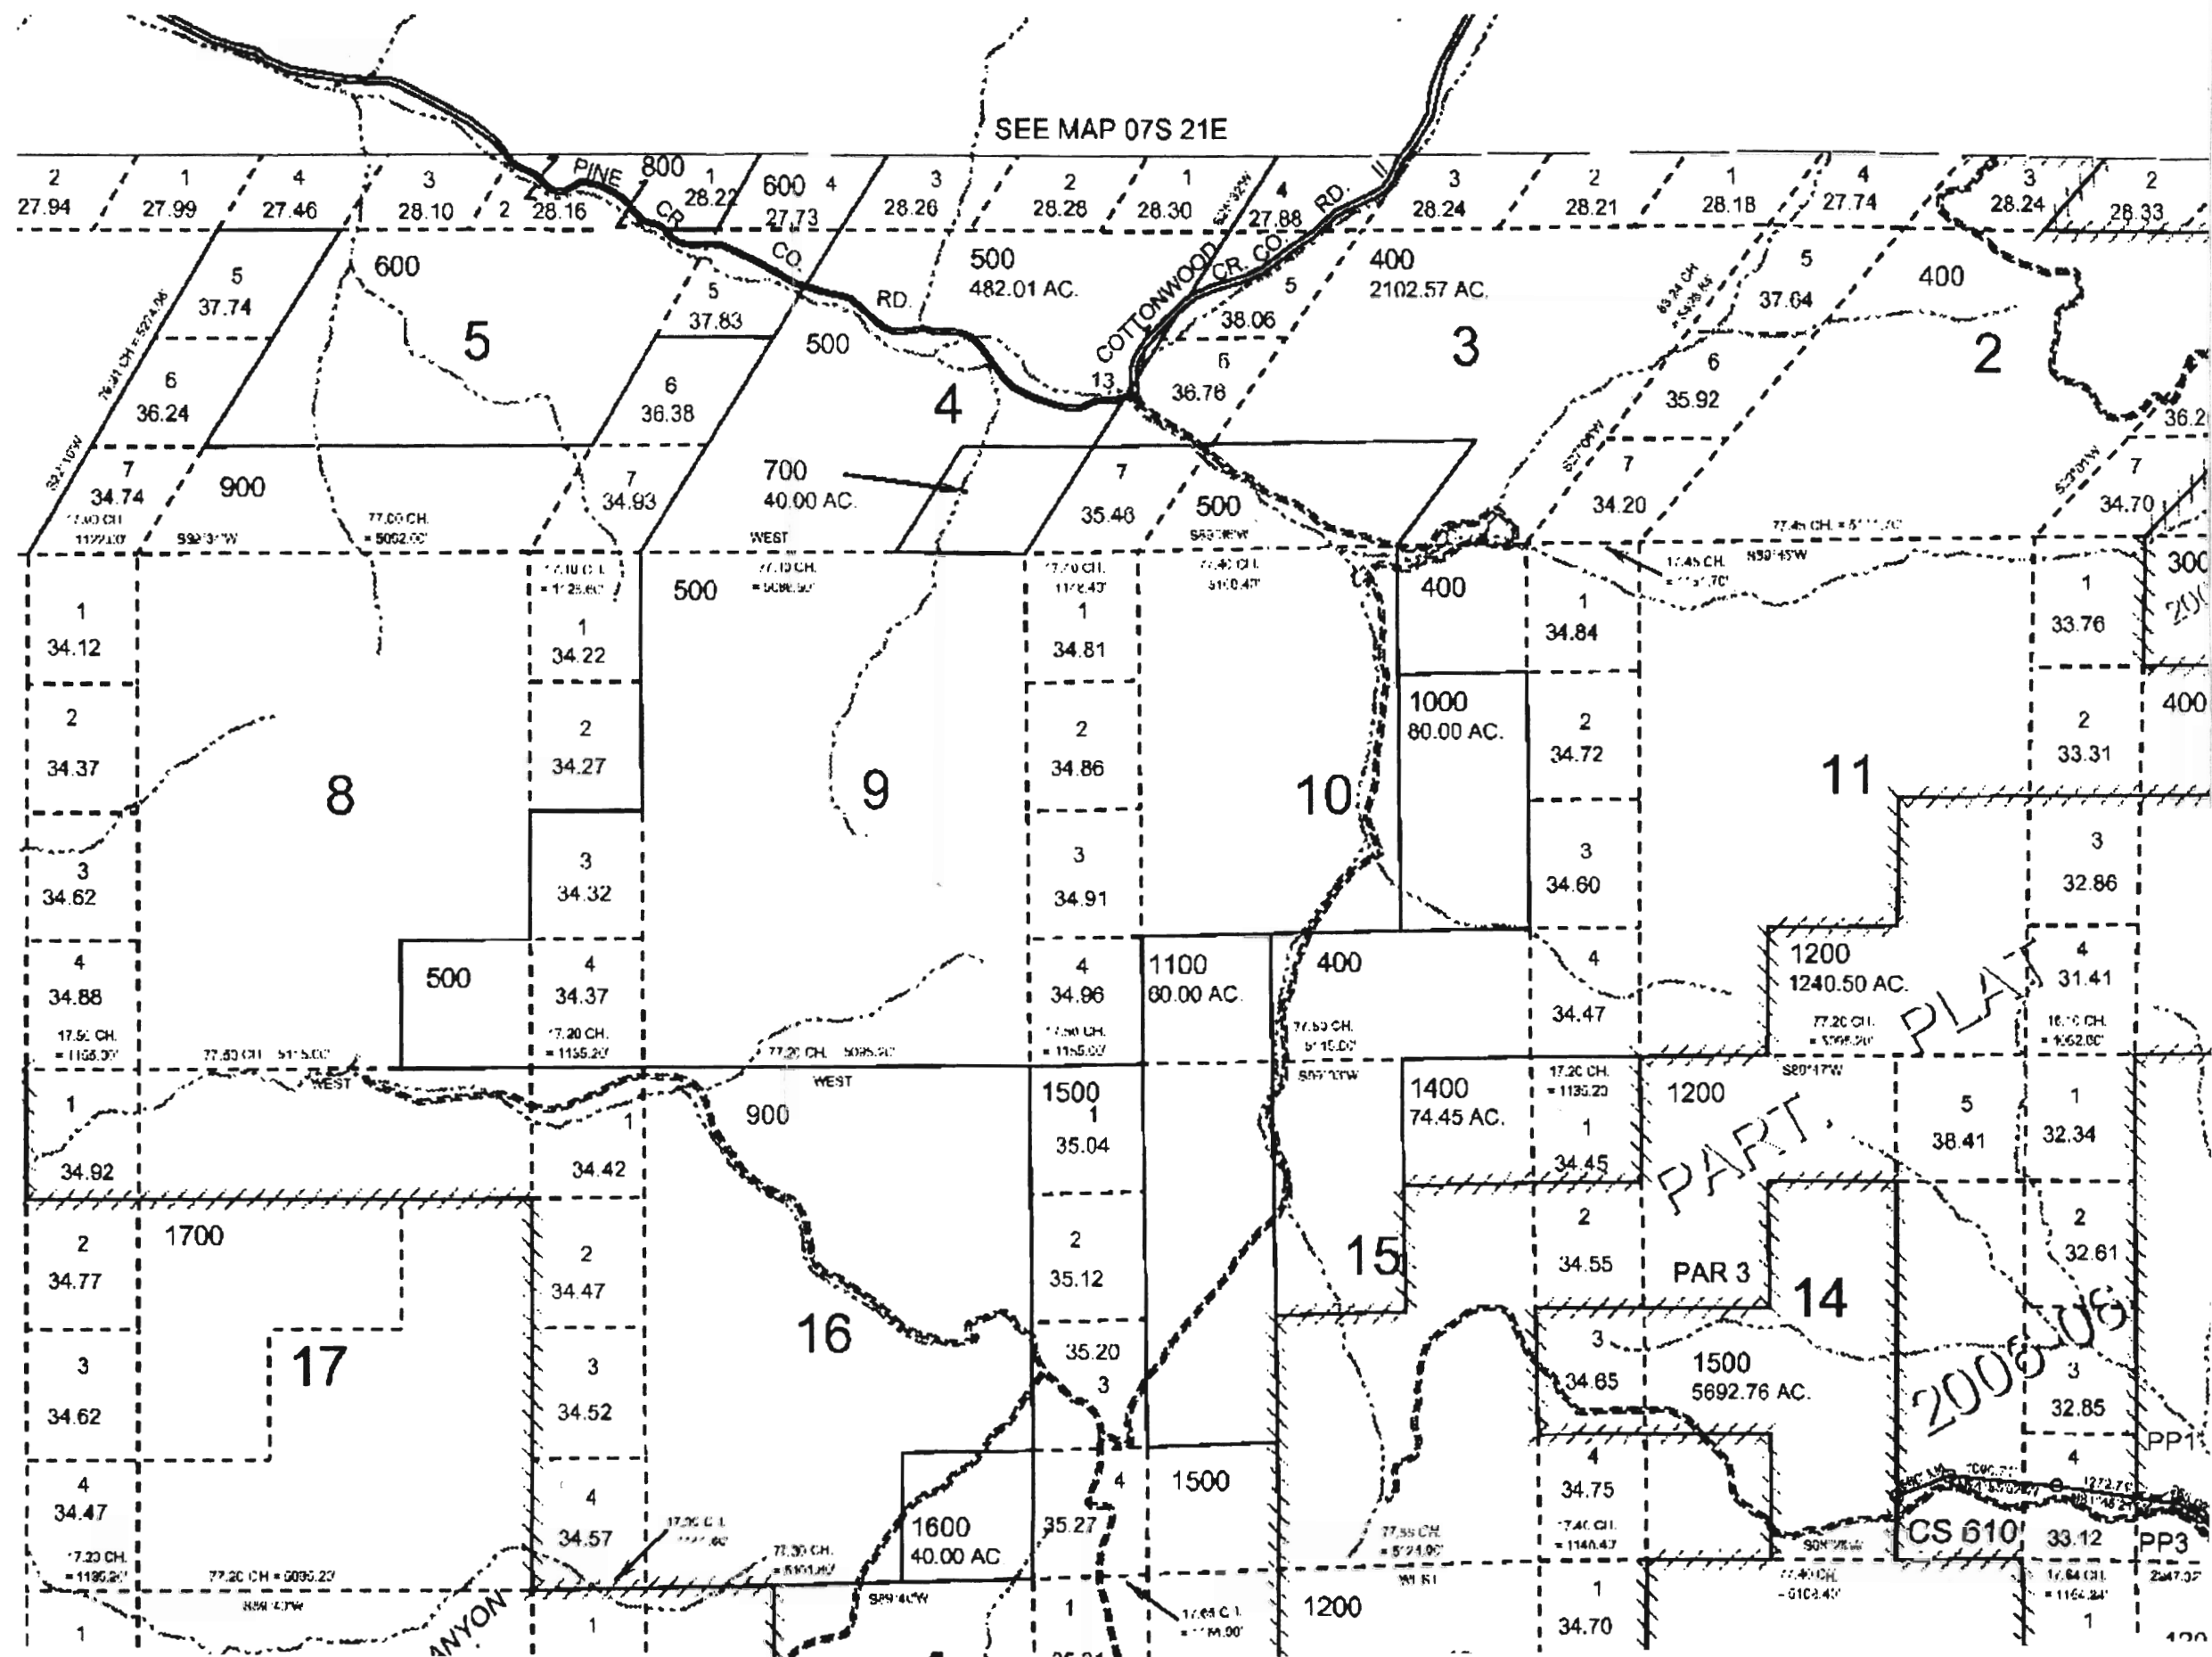

Work Copy

TL 400

8 south
21 east

SE SE

Jobe



SE corner
Section 3

pond
200 ft North
710 ft West
from SE corner
Section 3

Clubfoot

3974-7

14