



06/24/2008 10:36

5039860901

WRD 1ST FL


PAGE 02/03

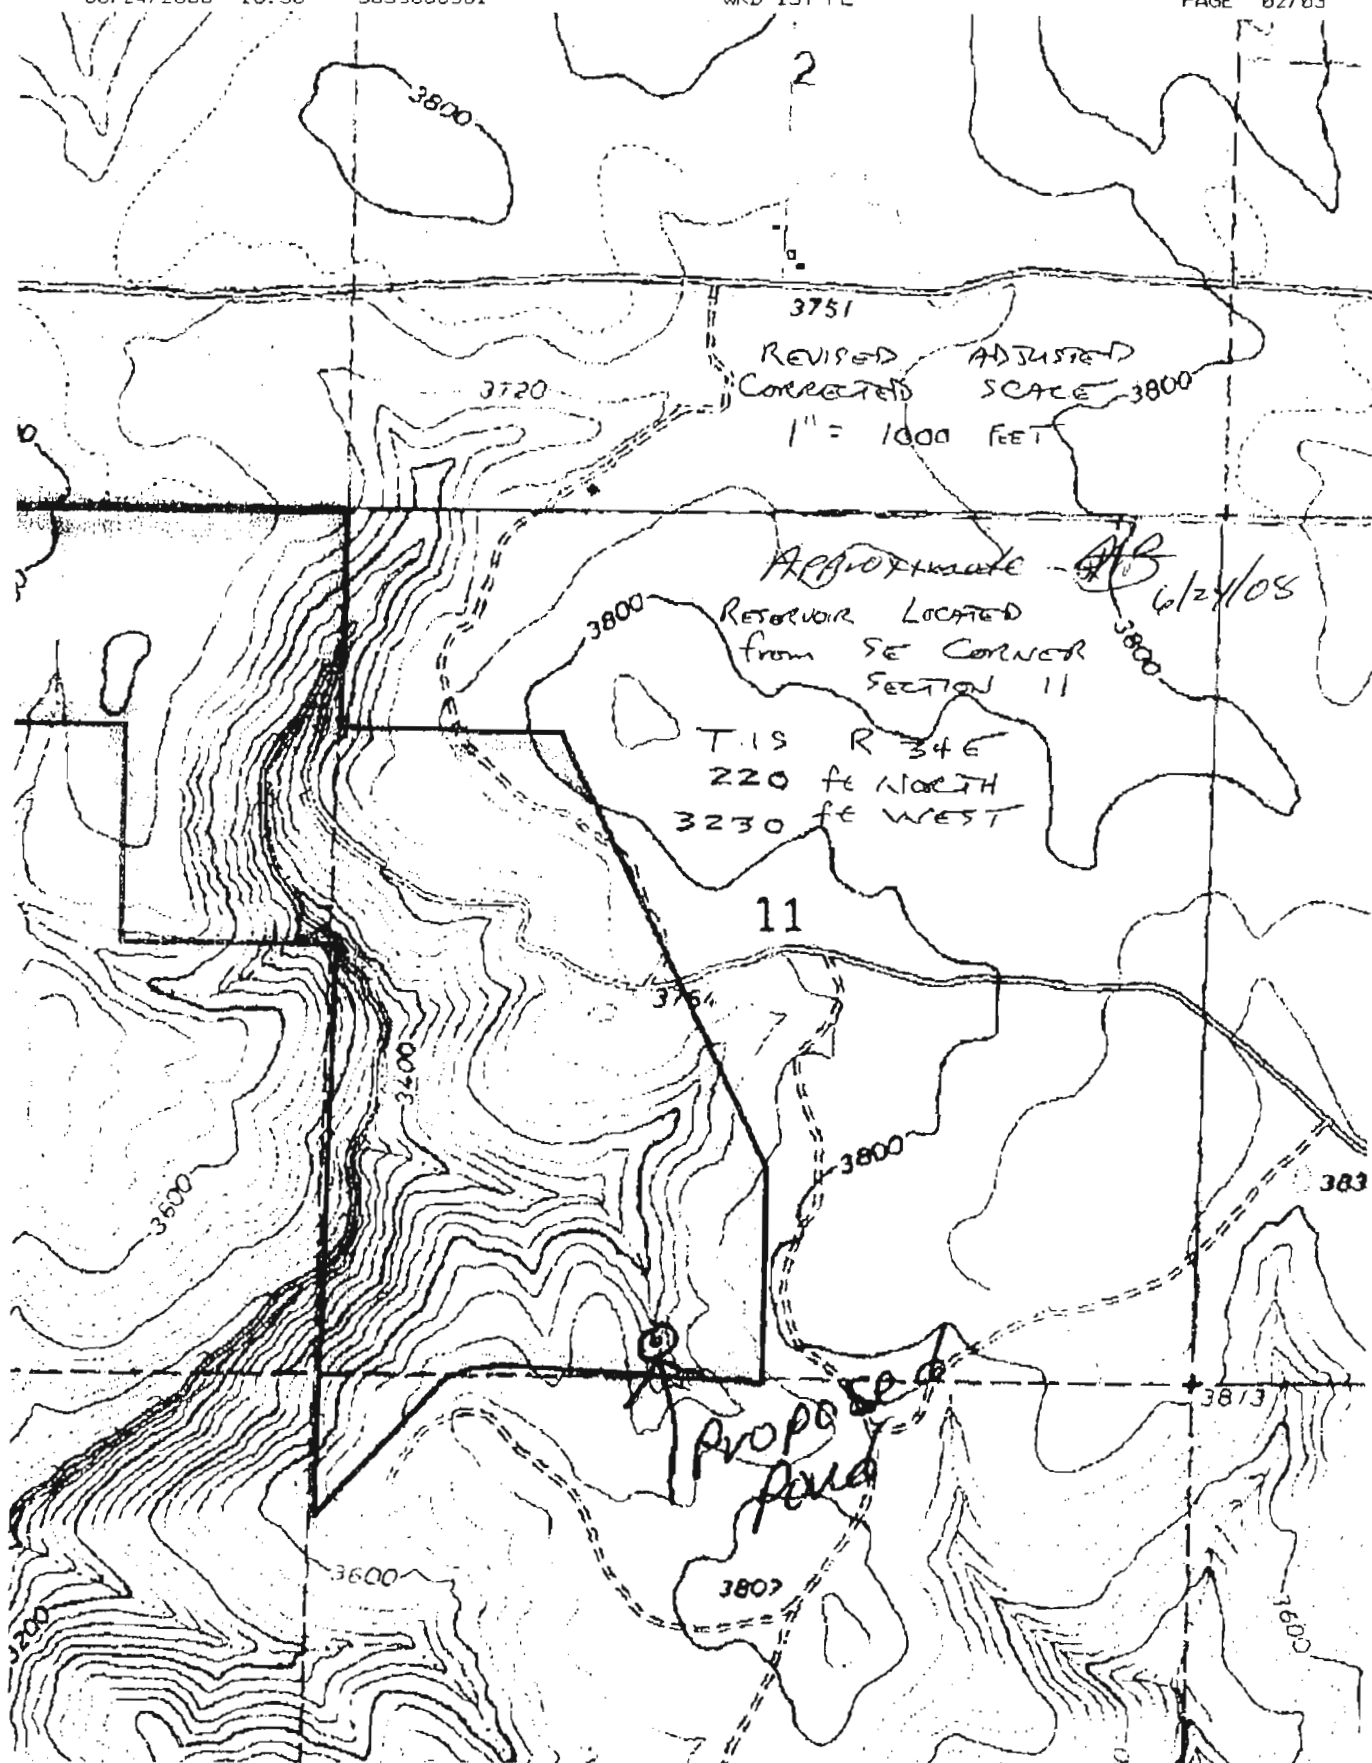

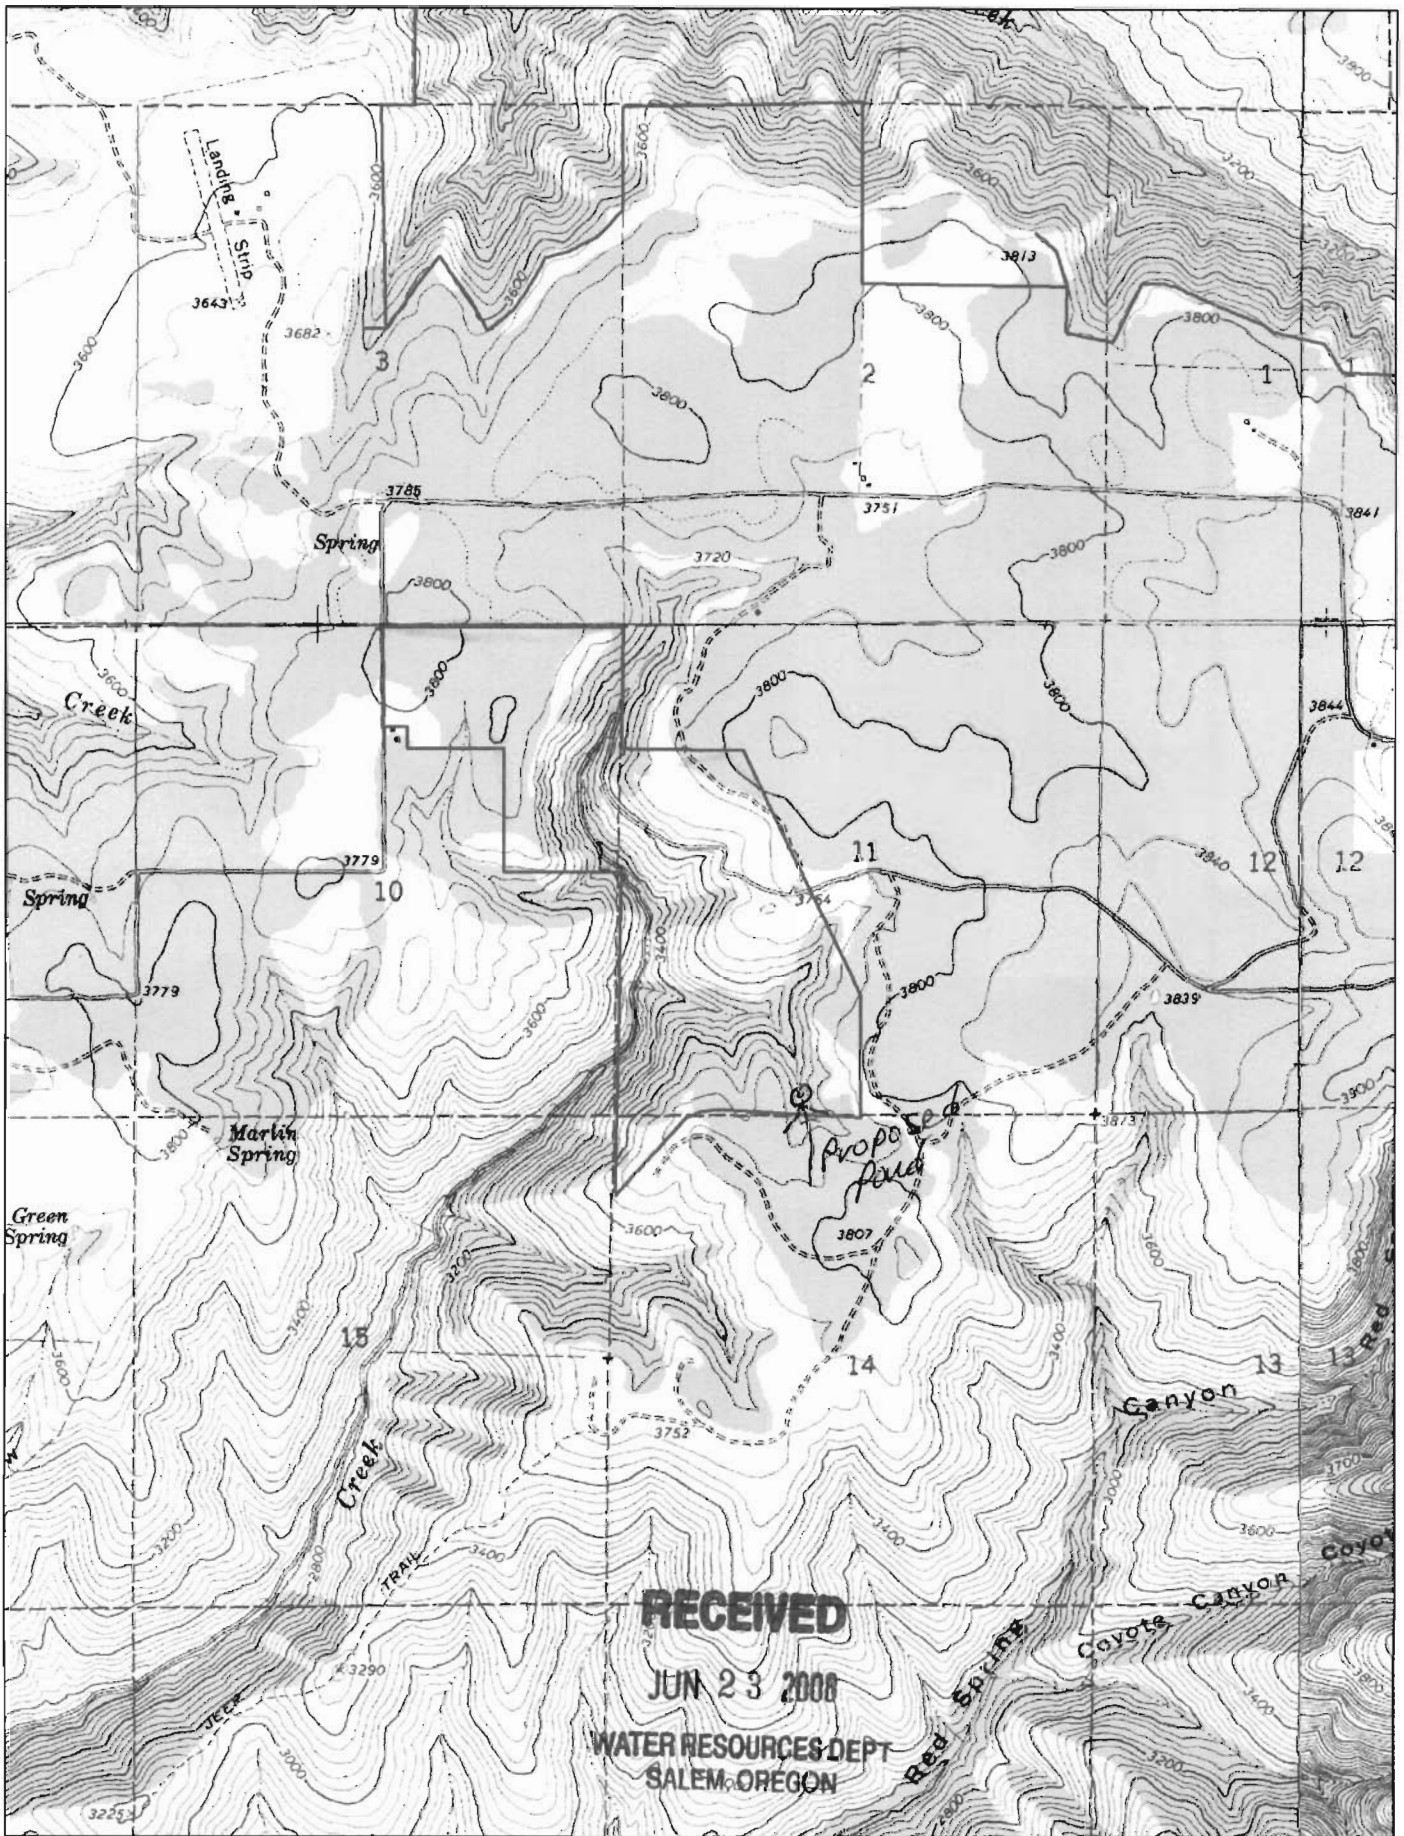


DE LORME

© 2002 DeLorme. 3-D TopoQuads ®. Data copyright of content owner.

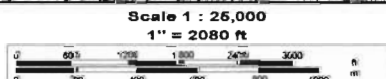

TN
MN
16.9°E

JUN 23 2008

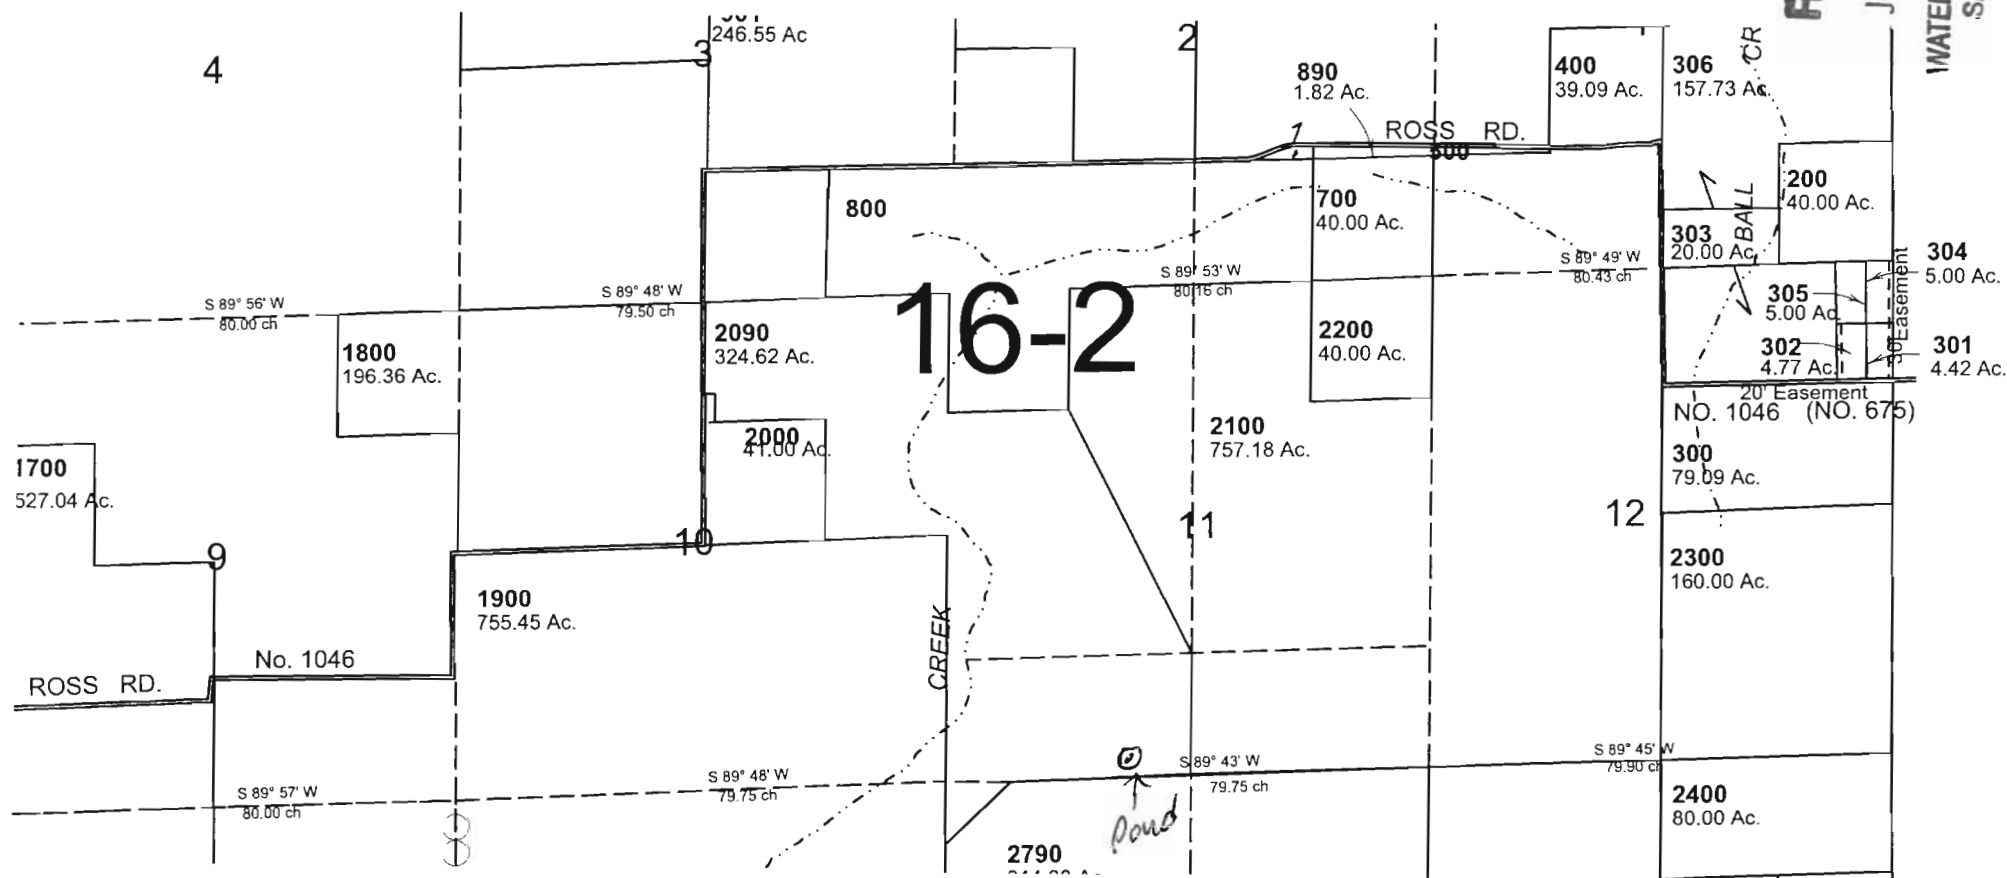WATER RESOURCES DEPT
SALEM, OREGON

RECEIVED

JUN 23 2008

WATER RESOURCES DEPT
SALEM, OREGON

