


RECEIVED

SEP 25 1997

WATER RESOURCES DEPT.
SALEM OREGON

T 1 N., R 23 E., W.M.
NW ¼ SE ¼ Section 22
MORROW COUNTY, OREGON

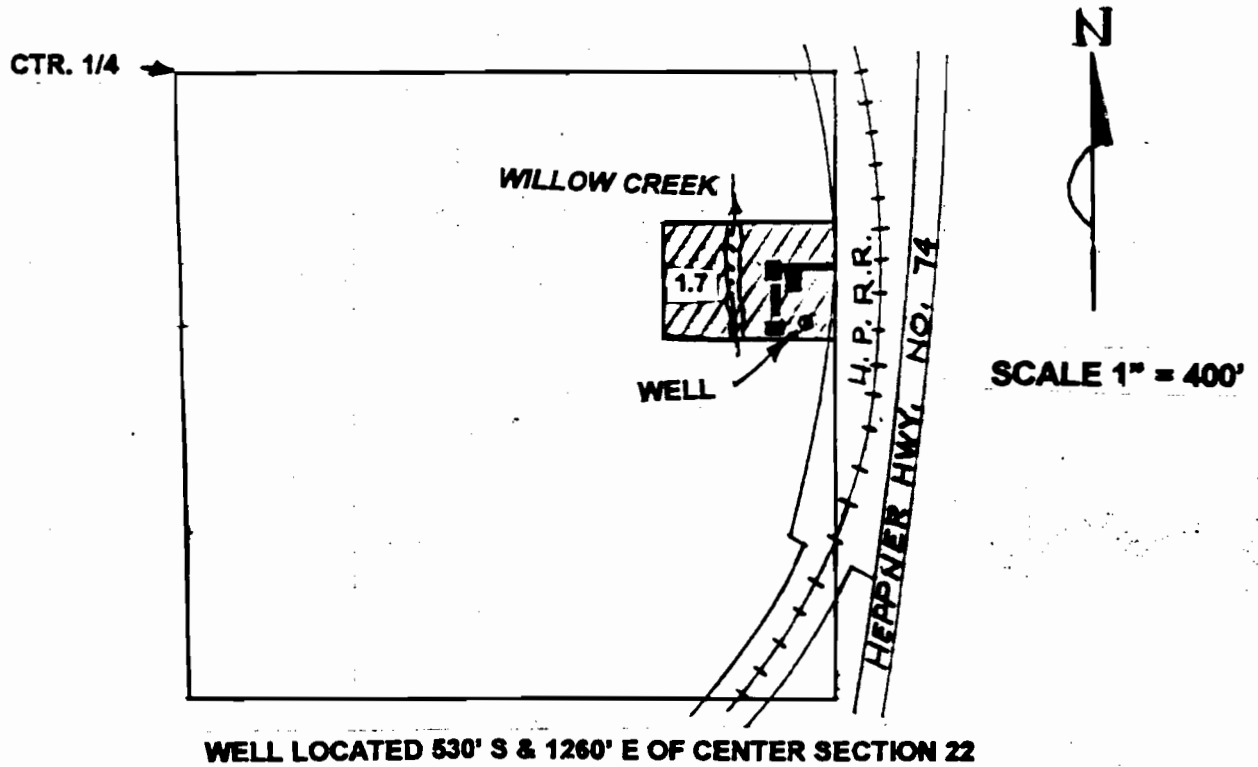

FINAL PROOF SURVEY

UNDER
PERMIT NO. G-11839 APPLICATION NO. G-13071

IN NAME OF
MARVIN L. & BEVERLY A. BOYLE

THIS MAP IS FOR THE PURPOSE
OF IDENTIFYING THE LOCATION
OF WATER RIGHTS ONLY, AND
IS NOT INTENDED TO PROVIDE
DIMENSIONS OR LOCATIONS OF
PROPERTY OWNERSHIP LINES.

