

#2

REQUEST FOR ASSIGNMENT

1. Eugene W. Gramzow
(Name of Applicant / Permit / Transfer Holder)

678 Rendezvous Ct. Pagosa Spr^{CO} 81147 970-731-9518
(mailing address) (City) (State) (Zip) (Phone #)

CHECK ONE

- ...hereby assign **all my interest** in and to application/permit/transfer;
- ...hereby assign **all my interest** in and to a **portion** of application/permit/transfer, (You must include a map showing the portion of the application/permit to be assigned.)
- ...hereby assign **a portion of my interest** in and to the **entire** application/permit/transfer;

RECEIVED
 JUN 01 2006
 WATER RESOURCES DEPT
 SALEM, OREGON

Application # G-13804, Permit # G-13738, Transfer # N/A
-OR-
GR Statement # N/A, GR Certificate of Registration # N/A

as filed in the office of the Water Resources Director, to:

Brent Stumbaugh
(Name of New Owner)

60475 Arnold MA Rd Bend OR 97702 541-389-5432
(mailing address) (City) (State) (Zip) (Phone #)

NOTE: If there are other owners of the property described in this Application, Permit, Transfer or Certificate of Ground Water Registration, you must provide a list of all other owners' names and mailing addresses and attach it to this form.

I hereby certify that I have notified all other owners of the property described in this Application, Permit or Certificate of Registration of this request for assignment.

Witness my hand this 6 day of Feb, 2006.

Applicant/Permit holder [Signature]

Applicant/Permit holder _____

ok. ASSIGN PERMIT
 Eugene Row TO STUMBAUGH
 J.M.S. 6/01/2006

DO NOT WRITE IN THIS BOX

- This certifies assignment and record change at Oregon Water Resources Department effective 8:00a.m. on date of receipt at Salem, Oregon.
 - Fee receipt # 81807
 - For Director by Jerry Sauter, Program Analyst in Water Rights Division. [Signature]

The completed "Request for Assignment" form must be submitted to the Department along with the appropriate recording fees:

- ◆ \$25 for the first page, and
 - ◆ \$5 for each additional page.
- [as required by ORS 536.050(1)(d)]

WATER RESOURCES DEPARTMENT
725 SUMMER STREET NE, SUITE A
SALEM, OREGON 97301-1271

Attn: Jerry Sauter.

DOUGLAS NEWMAN

RECEIVED


SEP 30 1996

WELL FOR SUPPLEMENTAL IRRIGATION WATER RESOURCES DEPT. SALEM, OREGON

Permit G-13738

T7S, R38EWM

Portion Transferred to Brent Stumbaugh 2/6/2006

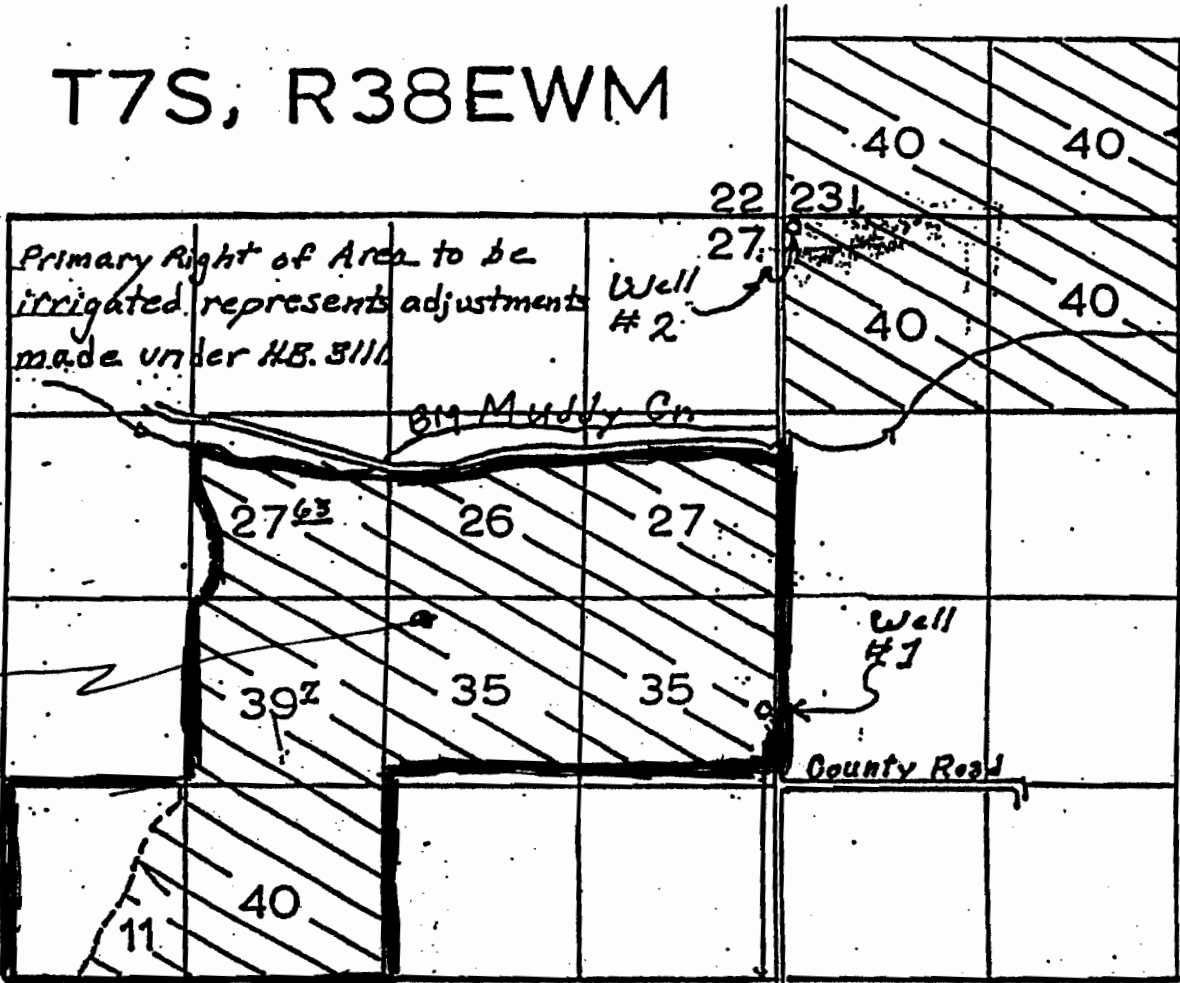



Primary Right of Area to be irrigated represents adjustments made under HB. 3111

Scale 1"=1320'

Well number 1 is located 2055 ft south and 50 ft west of the corner common to sections 23, 23, 26 & 27 T.8S.; R.38E.; W.M.

Well number 2 is located 10 ft south and 50 ft East of the corner common to sections 23, 23, 26 & 27 T.8S.; R.38E.; W.M.

Drawn by JEN Date 8-2
 Revised by TMK Date 9-2

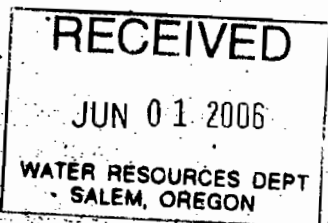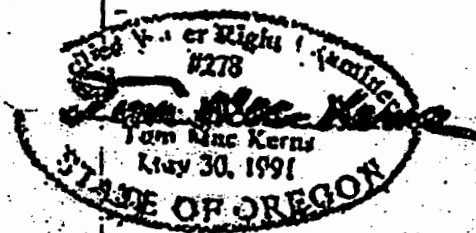

SHEET 1 of 2

A: G-13804
 D: G-13738