

W. Lynn Barnes
25294 Hwy 99E
Harney, Or. 97348


RECEIVED

FEB 08 2008

WATER RESOURCES DEPT
SALEM, OREGON

SECTION PLAT

Section 1 Township 24 S Range 32 E
County of Harney State of Oregon

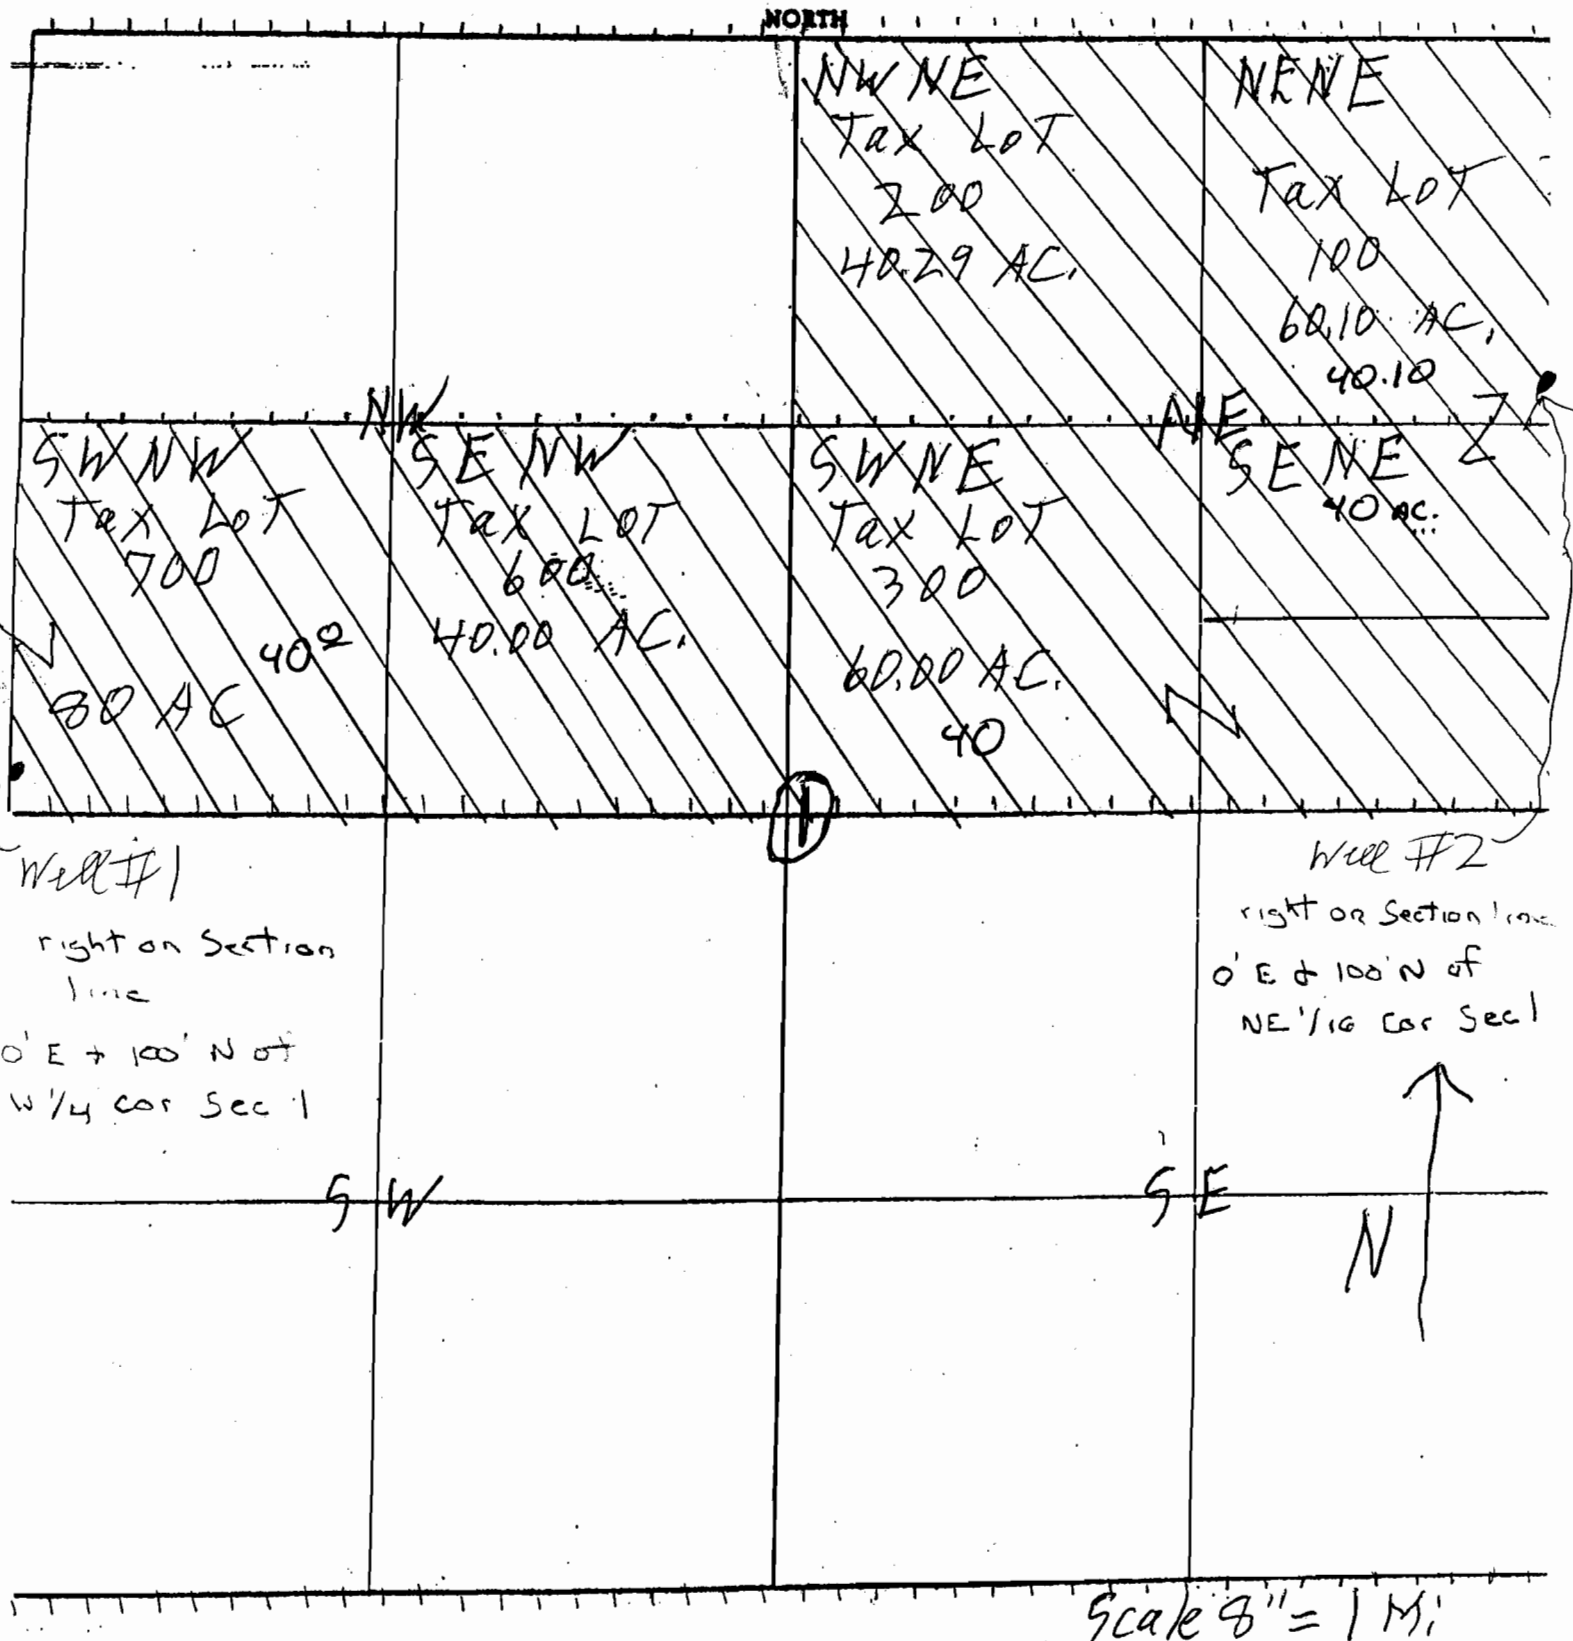

W. Lynn Barnes
25294 Hwy 99E
Harney, OR 97348

SECTION PLAT

RECEIVED

Section 2

Township 24 S


Range 32 E FEB 10 8/2008

County of Harney

State of Oregon

WATER RESOURCES DEPT
SALEM, OREGON

NORTH

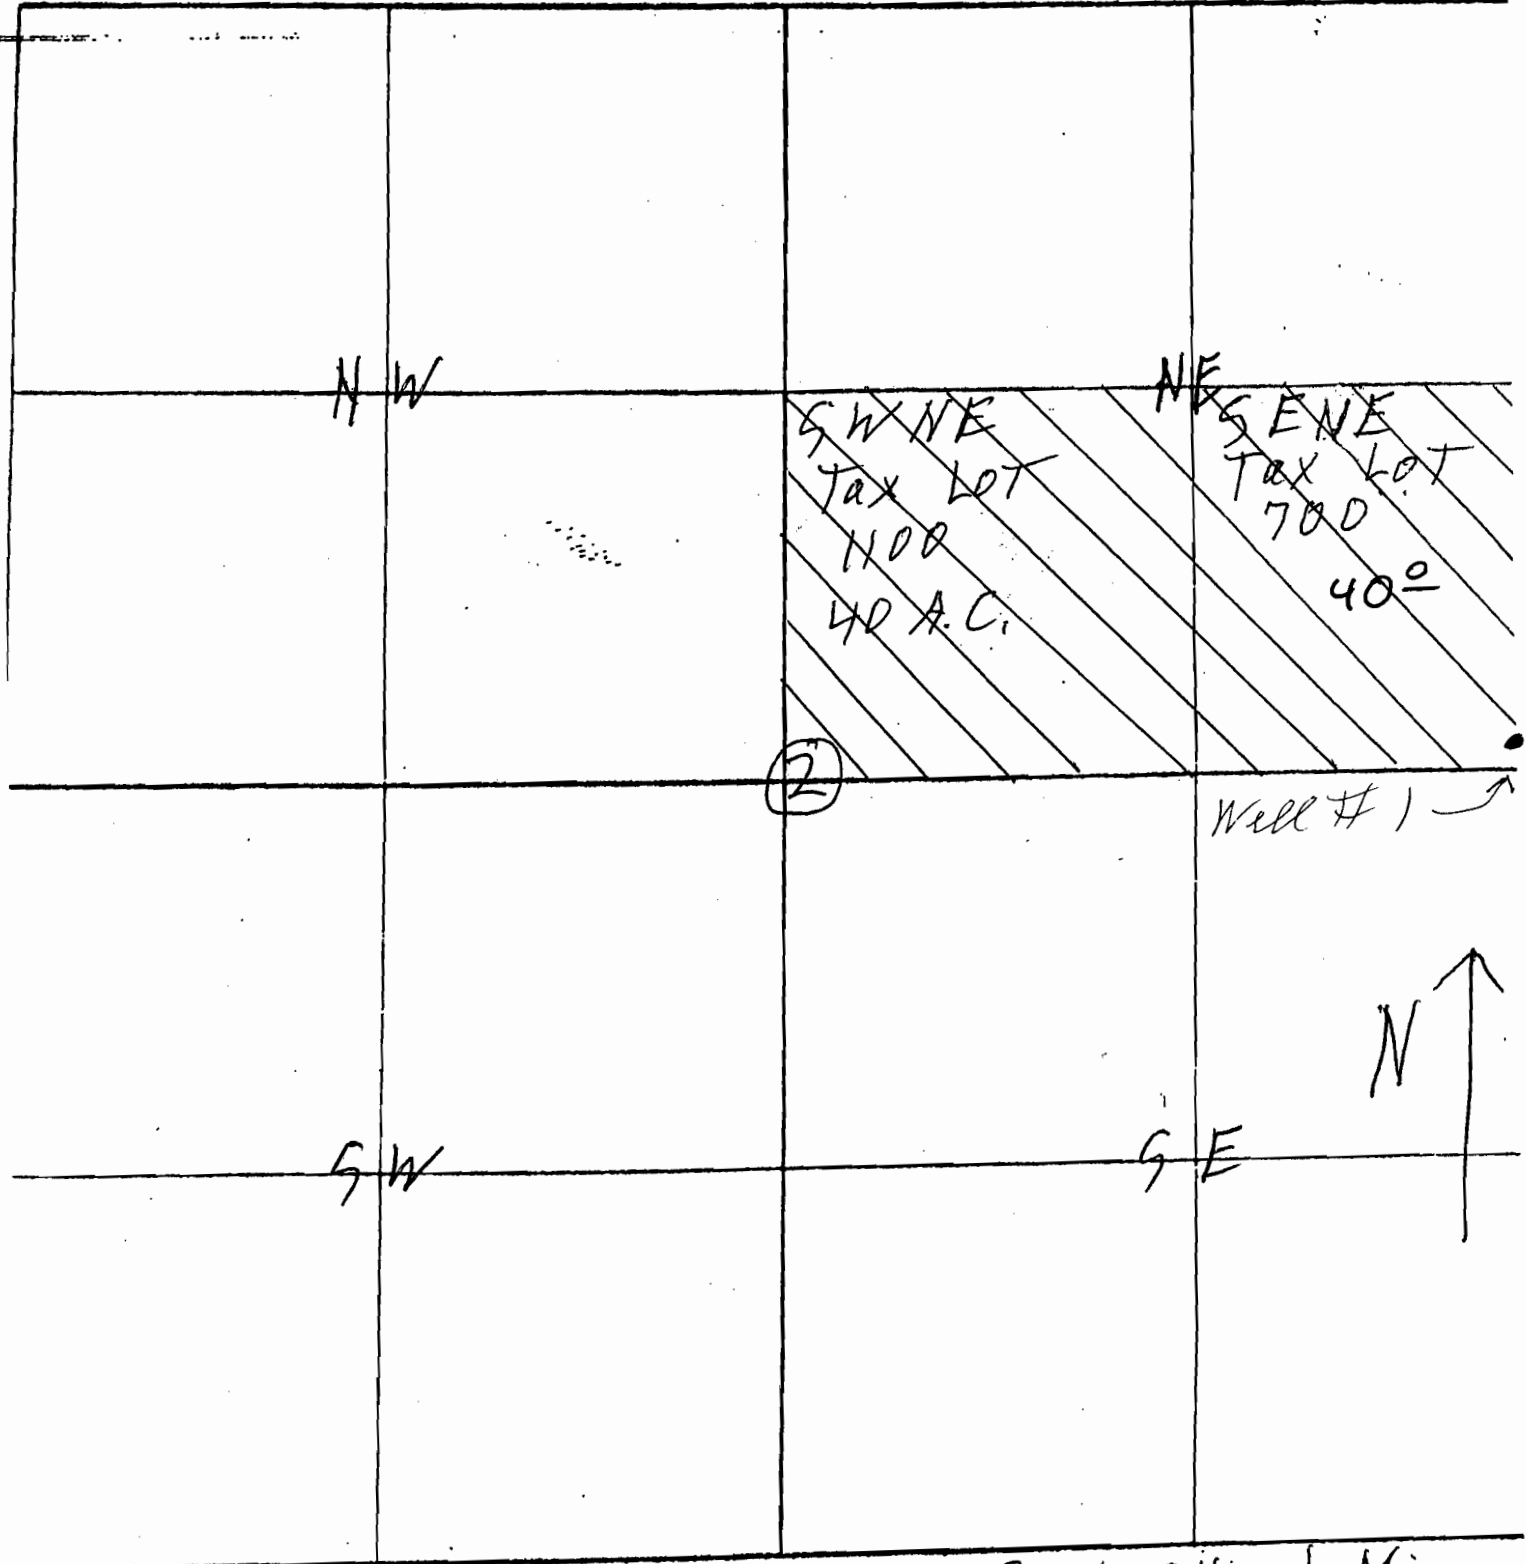

Scale 8" = 1 Mi