


Houghton, Ashley & Delma

Water Transmission

Lot 8, Tract T, Odell Lake

Sec 18 T 23 S R 6 E WM (unsurveyed)

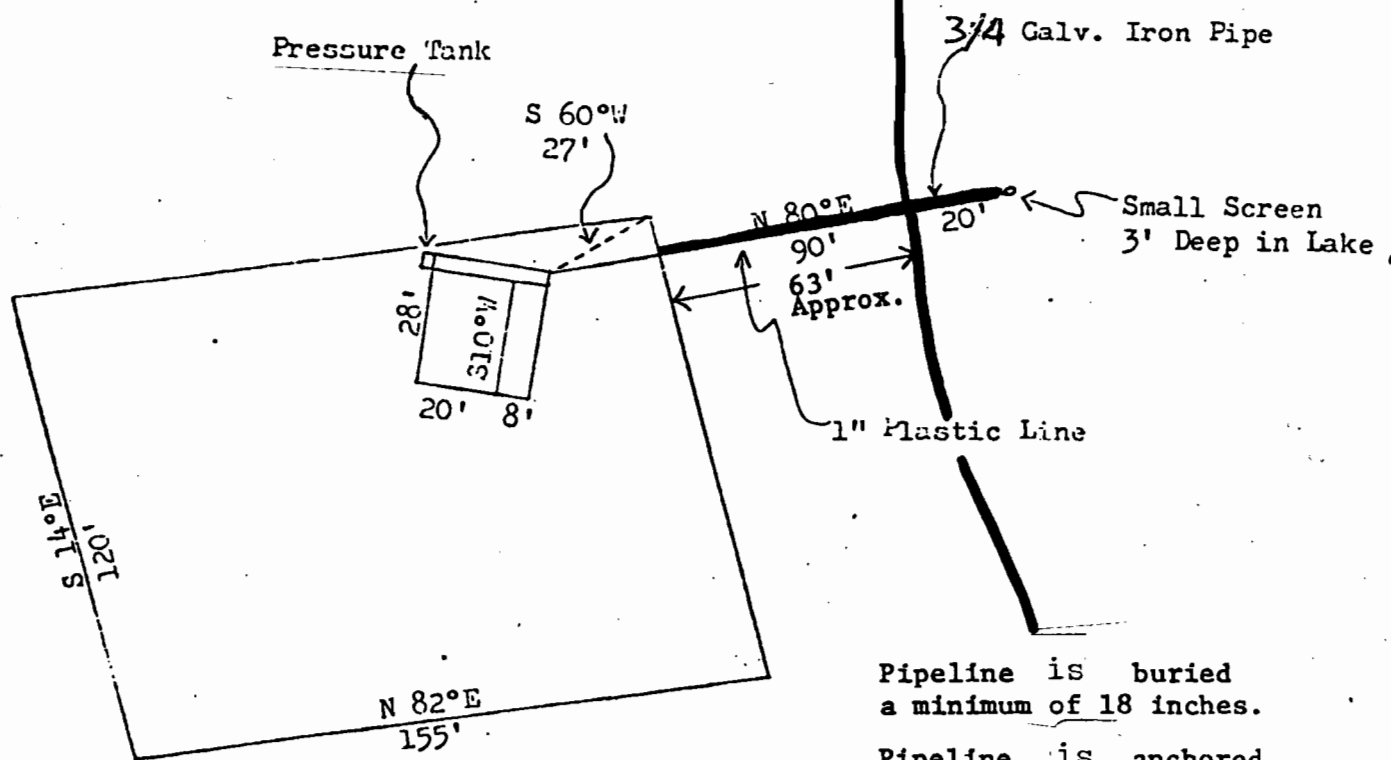

Pipeline is buried
a minimum of 18 inches.

Pipeline is anchored
securely along the bottom
of the lake

Scale: 1" = 50'

R.V.C. 9-18-63

RECEIVED


JUN 26 2008

WATER RESOURCES DEPT.
SALEM, OREGON

10-9-63

Don L. Delma

**ODELL LAKE
TRACT T
8 LOTS**

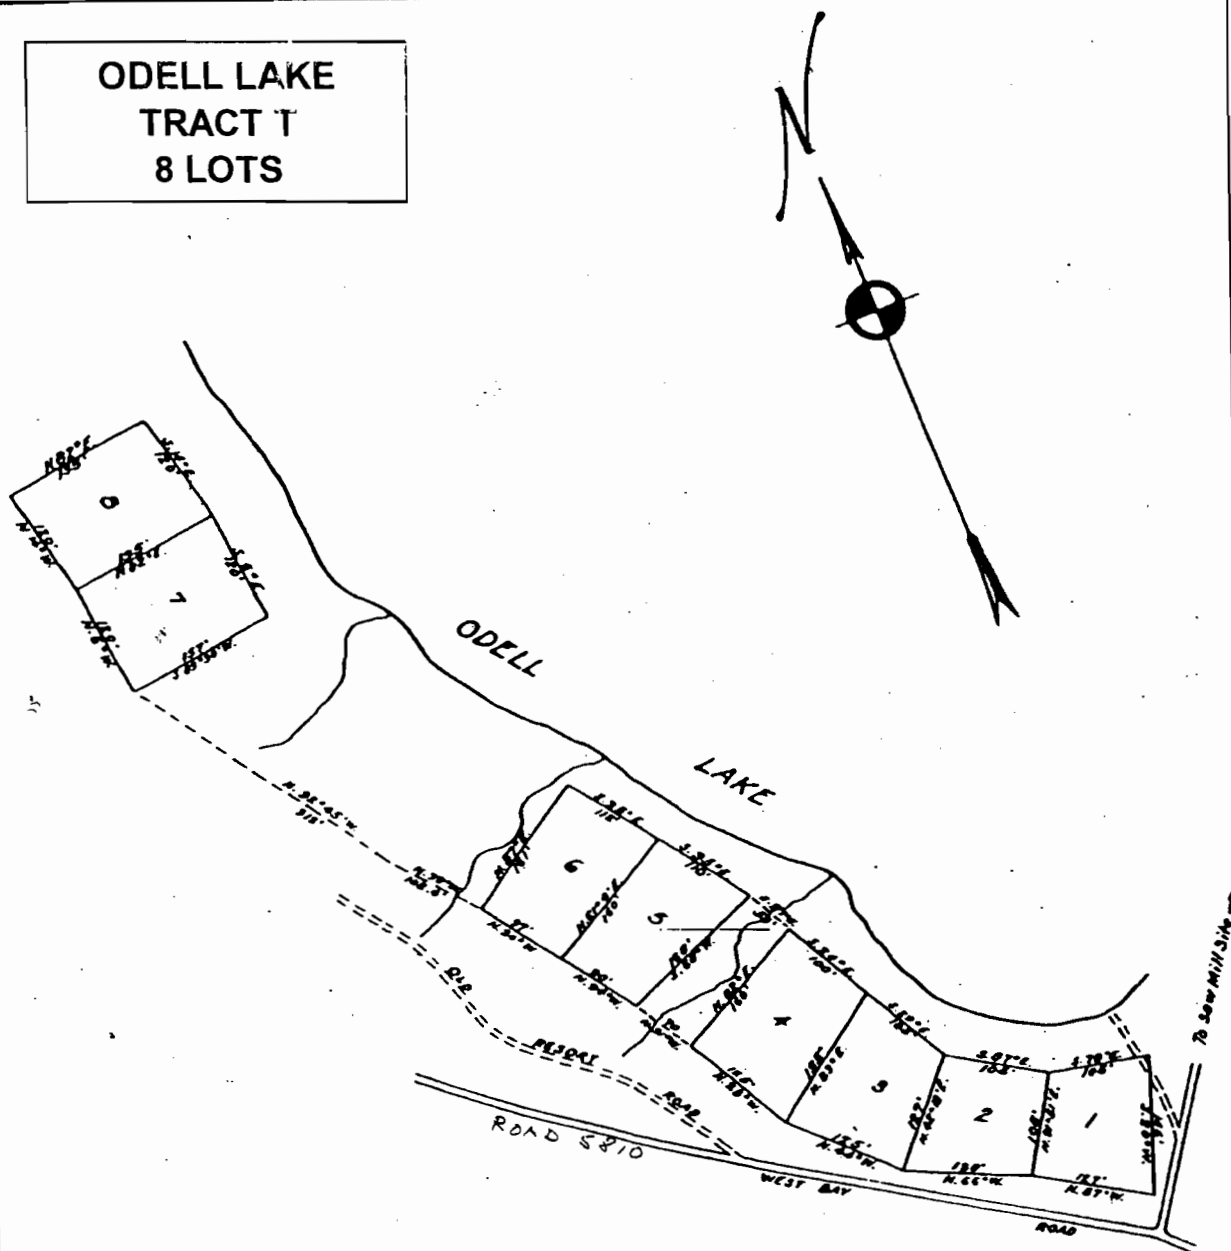

U. S. DEPARTMENT OF AGRICULTURE
FOREST SERVICE
DESCHUTES NATIONAL FOREST
KLAMATH COUNTY
APPROX. SEC. 18 T.23S. R.8E. W.6M. UNSURVEYED
ODELL LAKE RECREATION RESIDENCE SITE
(TRACT T)

Scale 1"=100'
Map Dec. 1904.
Surveyed Aug. 1927
by
R. L. Fromme
Resurvey of Lots 7 & 8 Aug. 1934
by
J. Thompson

RECEIVED

JUN 26 2008

WATER RESOURCES DEPT.
SALEM, OREGON

Approved _____

