

LAND PARTITION

PARTITION P.

 41-9-2, TB-1701 (TL 1411, 1412)


WORK
 COPY

PL. 1/4" MON. AND
 PER. 1/4" 14-12

LINE DATA

LINE NO.	DESCRIPTION	LENGTH	BEARING
1
2
3
4
5
6
7
8
9
10
11
12
13
14
15
16
17
18
19
20

ADJUSTED CORRECTED
 AREA SCALE
 1" = 1000 FEET

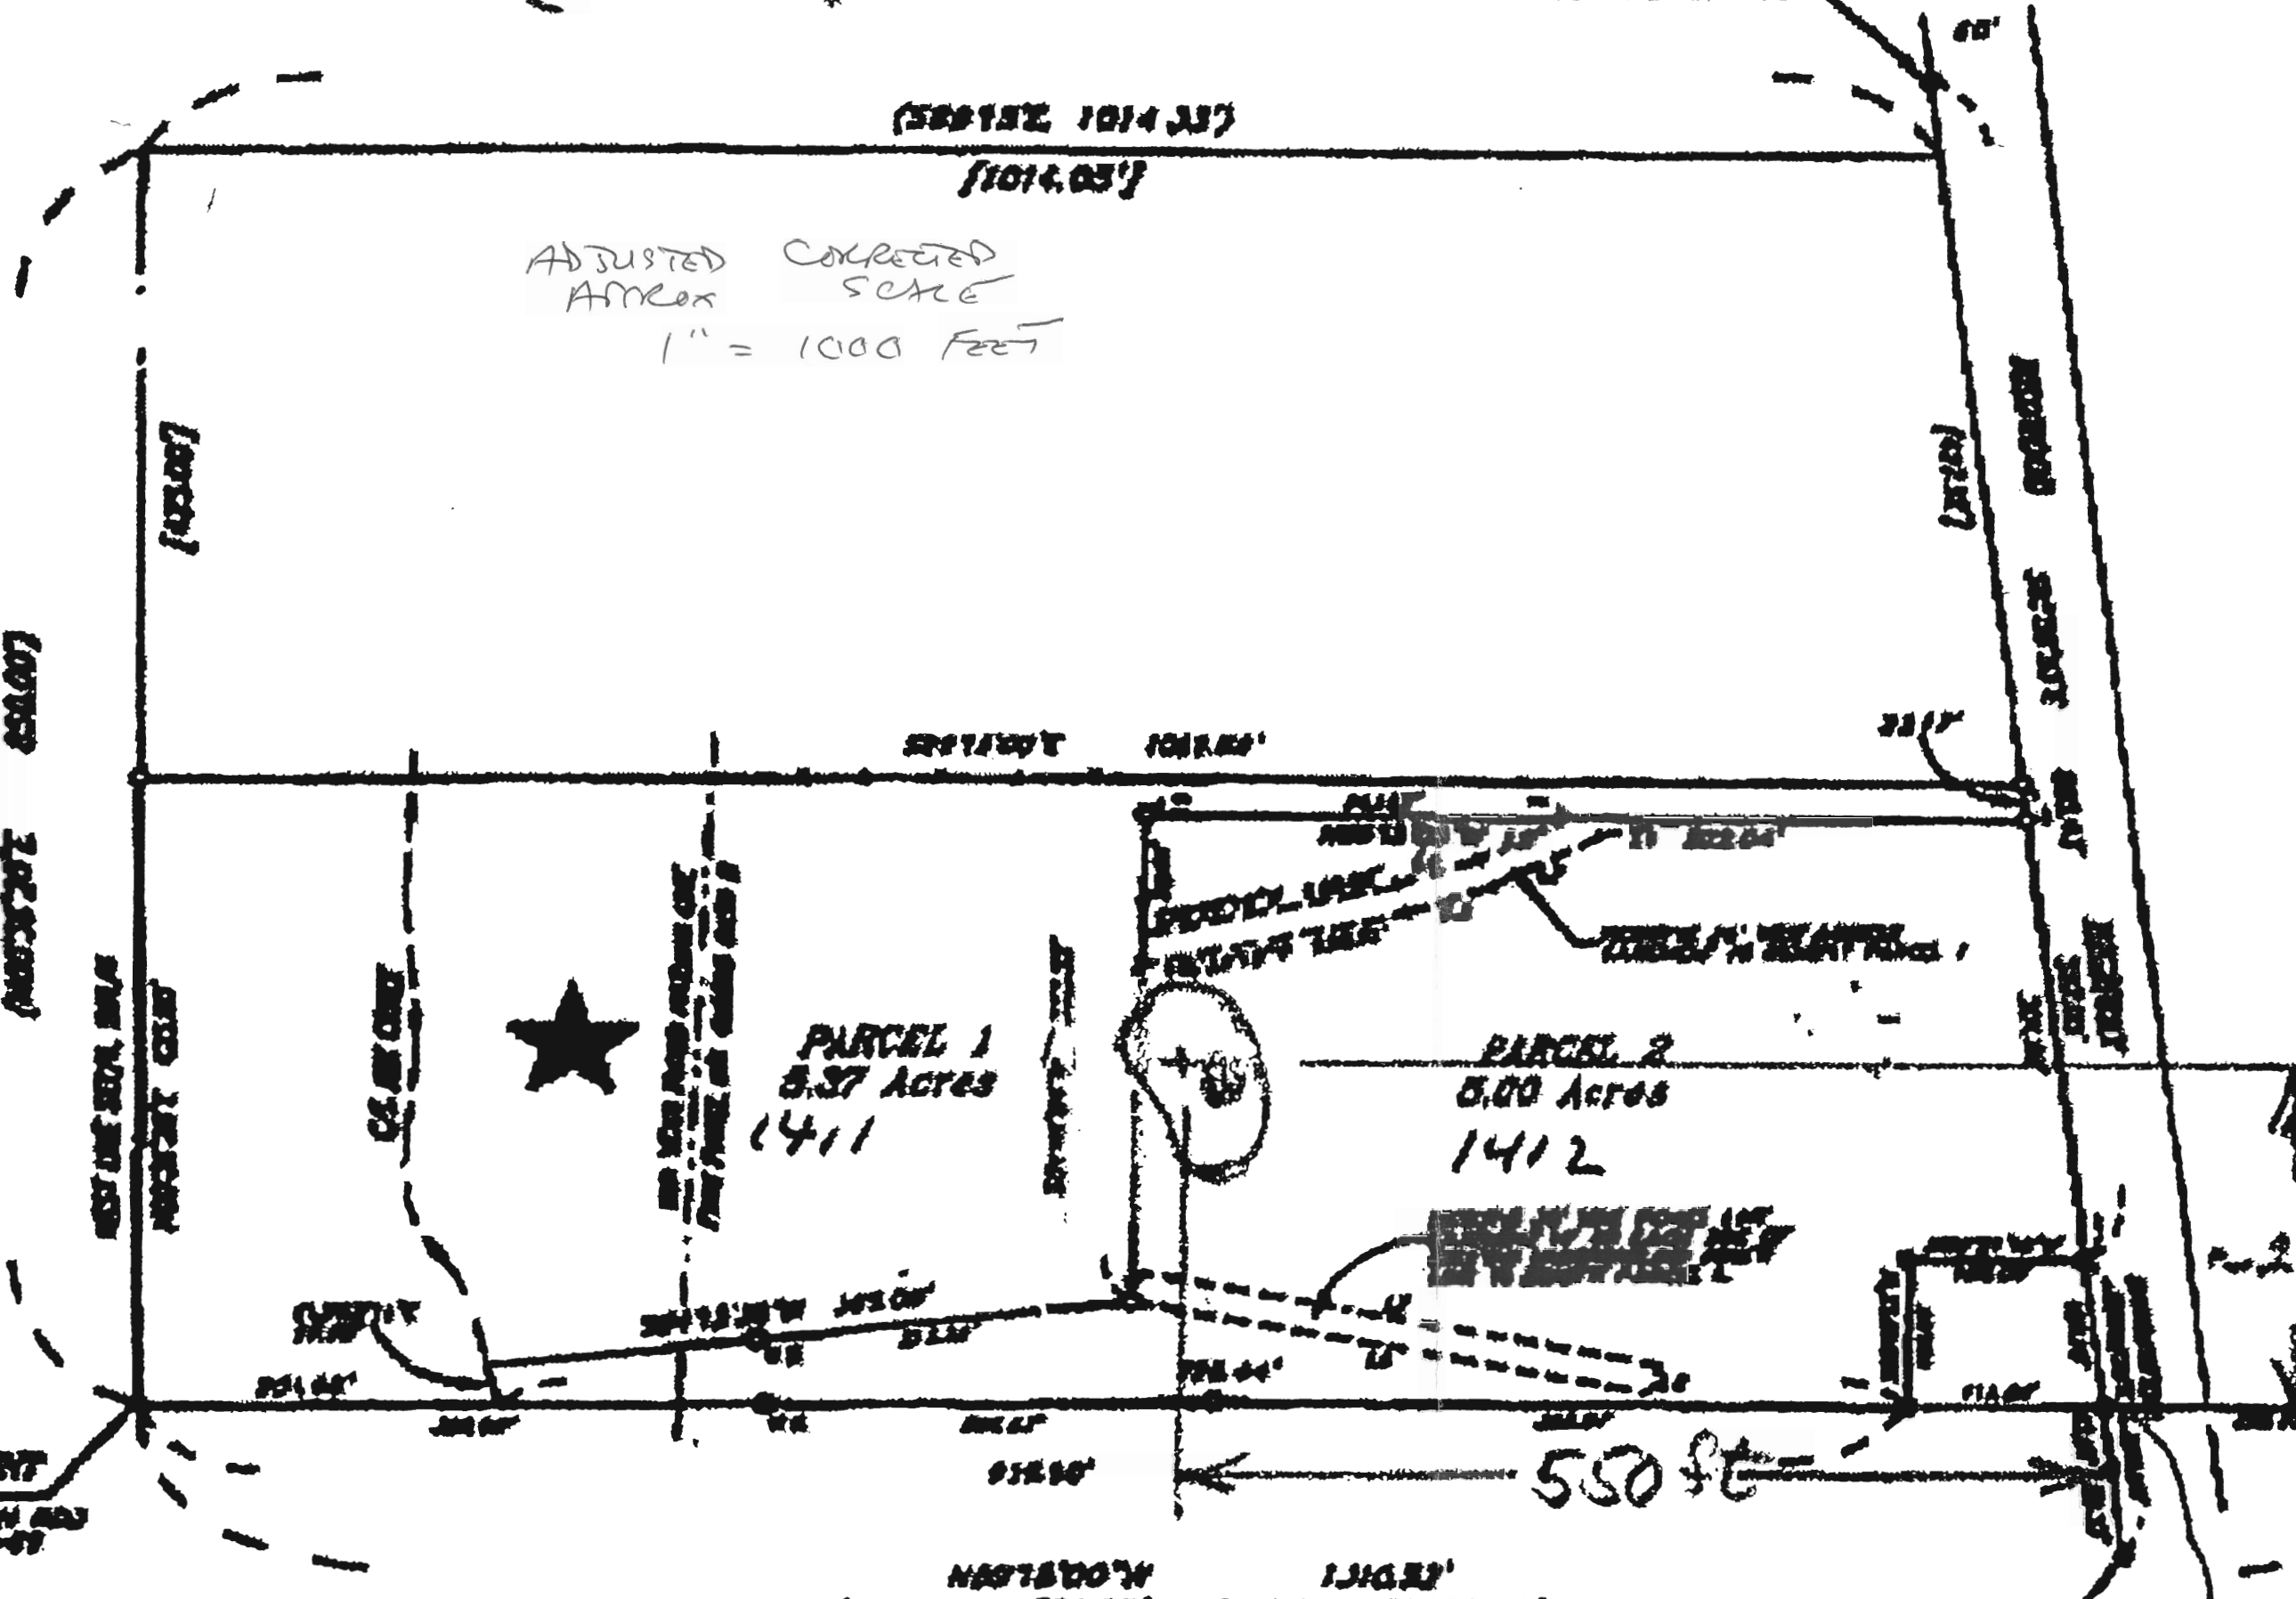

- MET. CAP. PLASTER
- MET. CAP. WOOD
- MET. CAP. IRON
- () METAL
- () CONCRETE
- NC. WOOD
- FENCE
- BOUNDARY

SURVEY


200 ft

550 ft

1/4" MON. AND
 PER. 1/4" 14-12