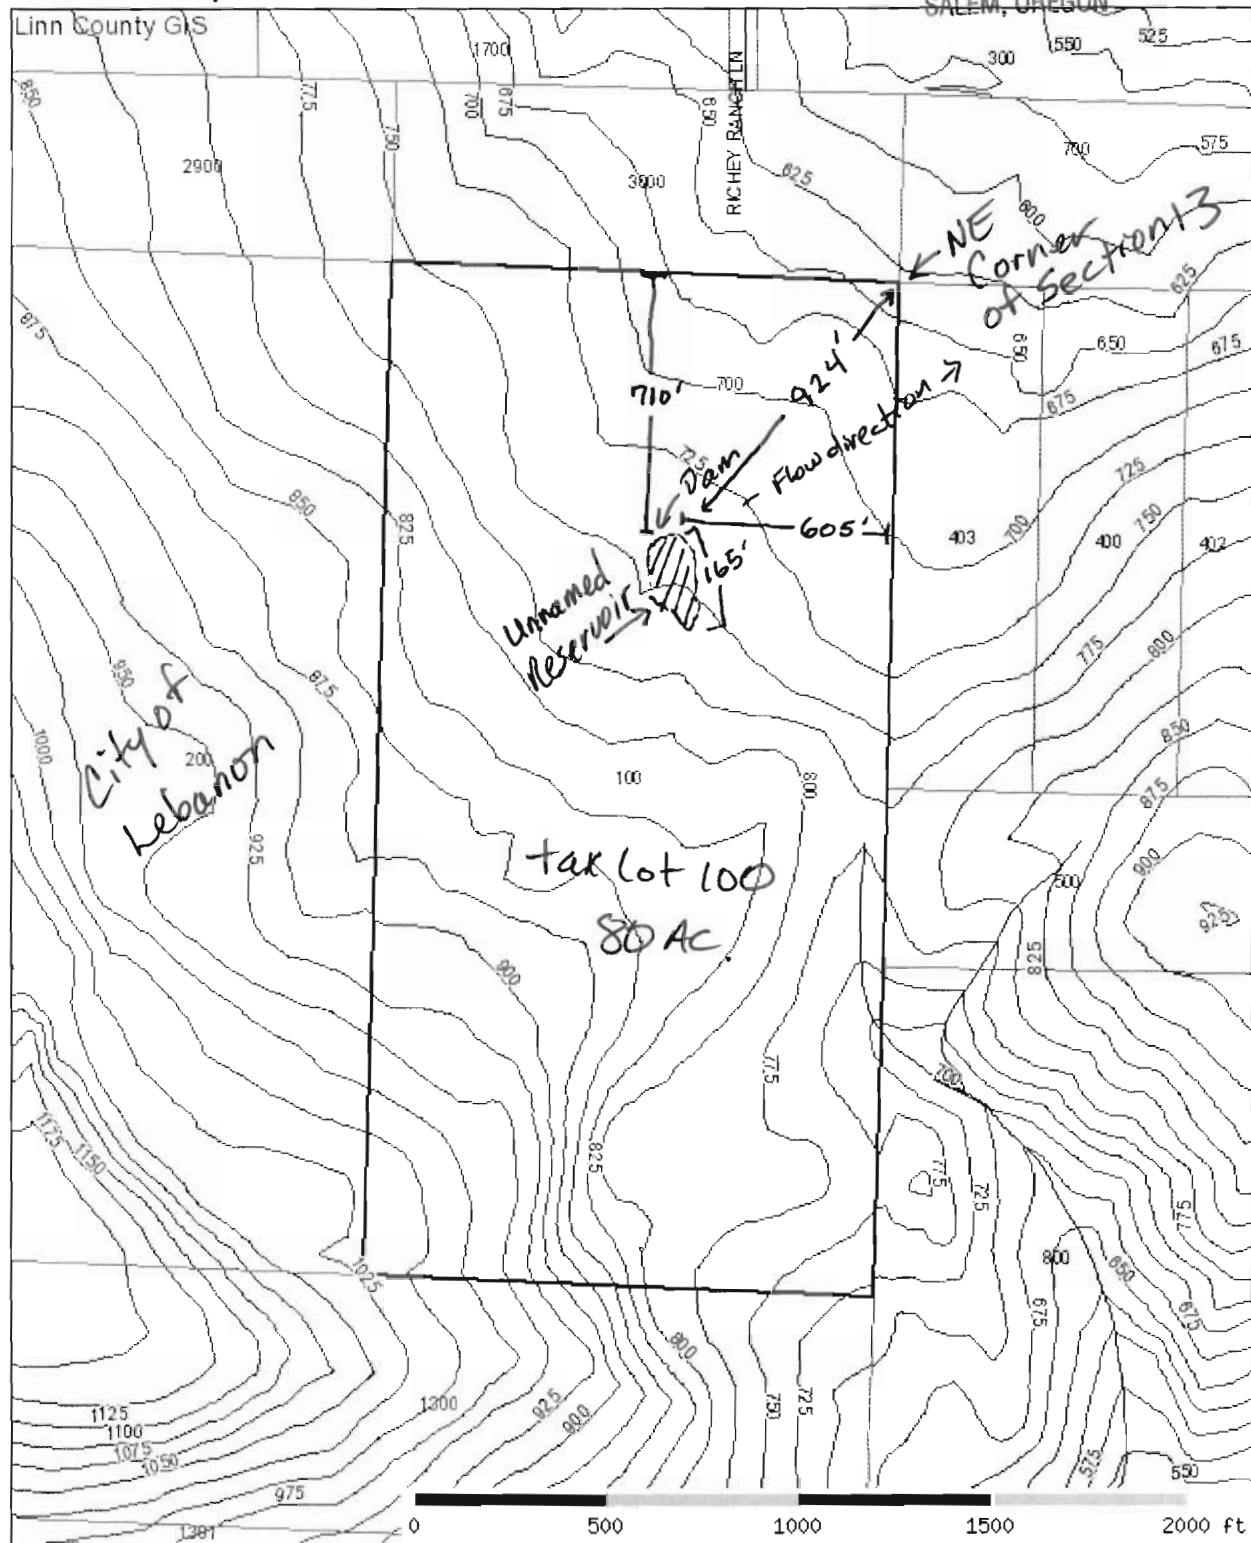


Owner: Lynn Merrill

20 E. Airport Rd #277, Lebanon, OR 97355

RECEIVED

JUN 25 2008

WATER RESOURCES DEPT.
SALEM, OREGON

* Reservoir is approximately 120 ft wide, 165 feet long, and 15 ft deep.

* Its dam is located 924 ft from the NE corner of Section 13 along the bearing of 42° 24' 13" SW.


* Reservoir is primarily excavated rather dammed and holds 6.75 acre-feet of water.

N
↑



WATER RESOURCES DEPT.
SALEM, OREGON

2005 Aerial Photo

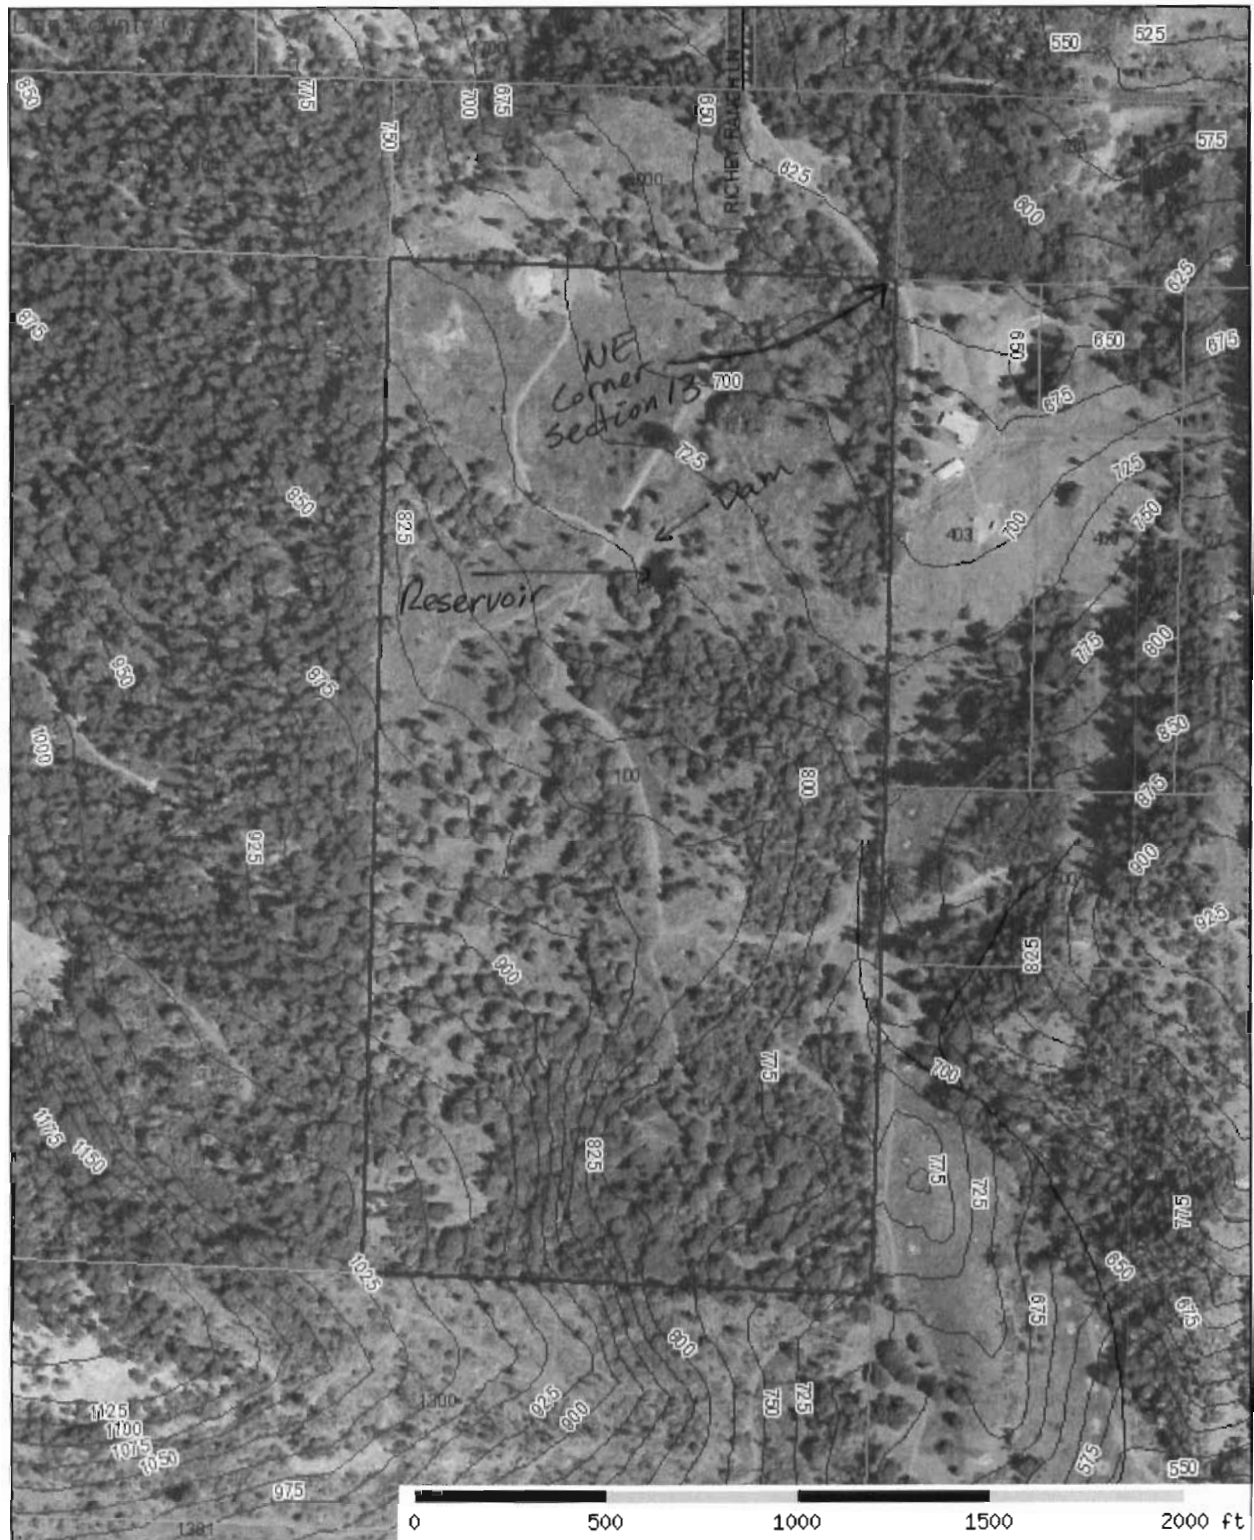


RECEIVED

JUN 25 2008

WATER RESOURCES DEPT.
SALEM, OREGON

Close up view - 2005 Aerial Photo

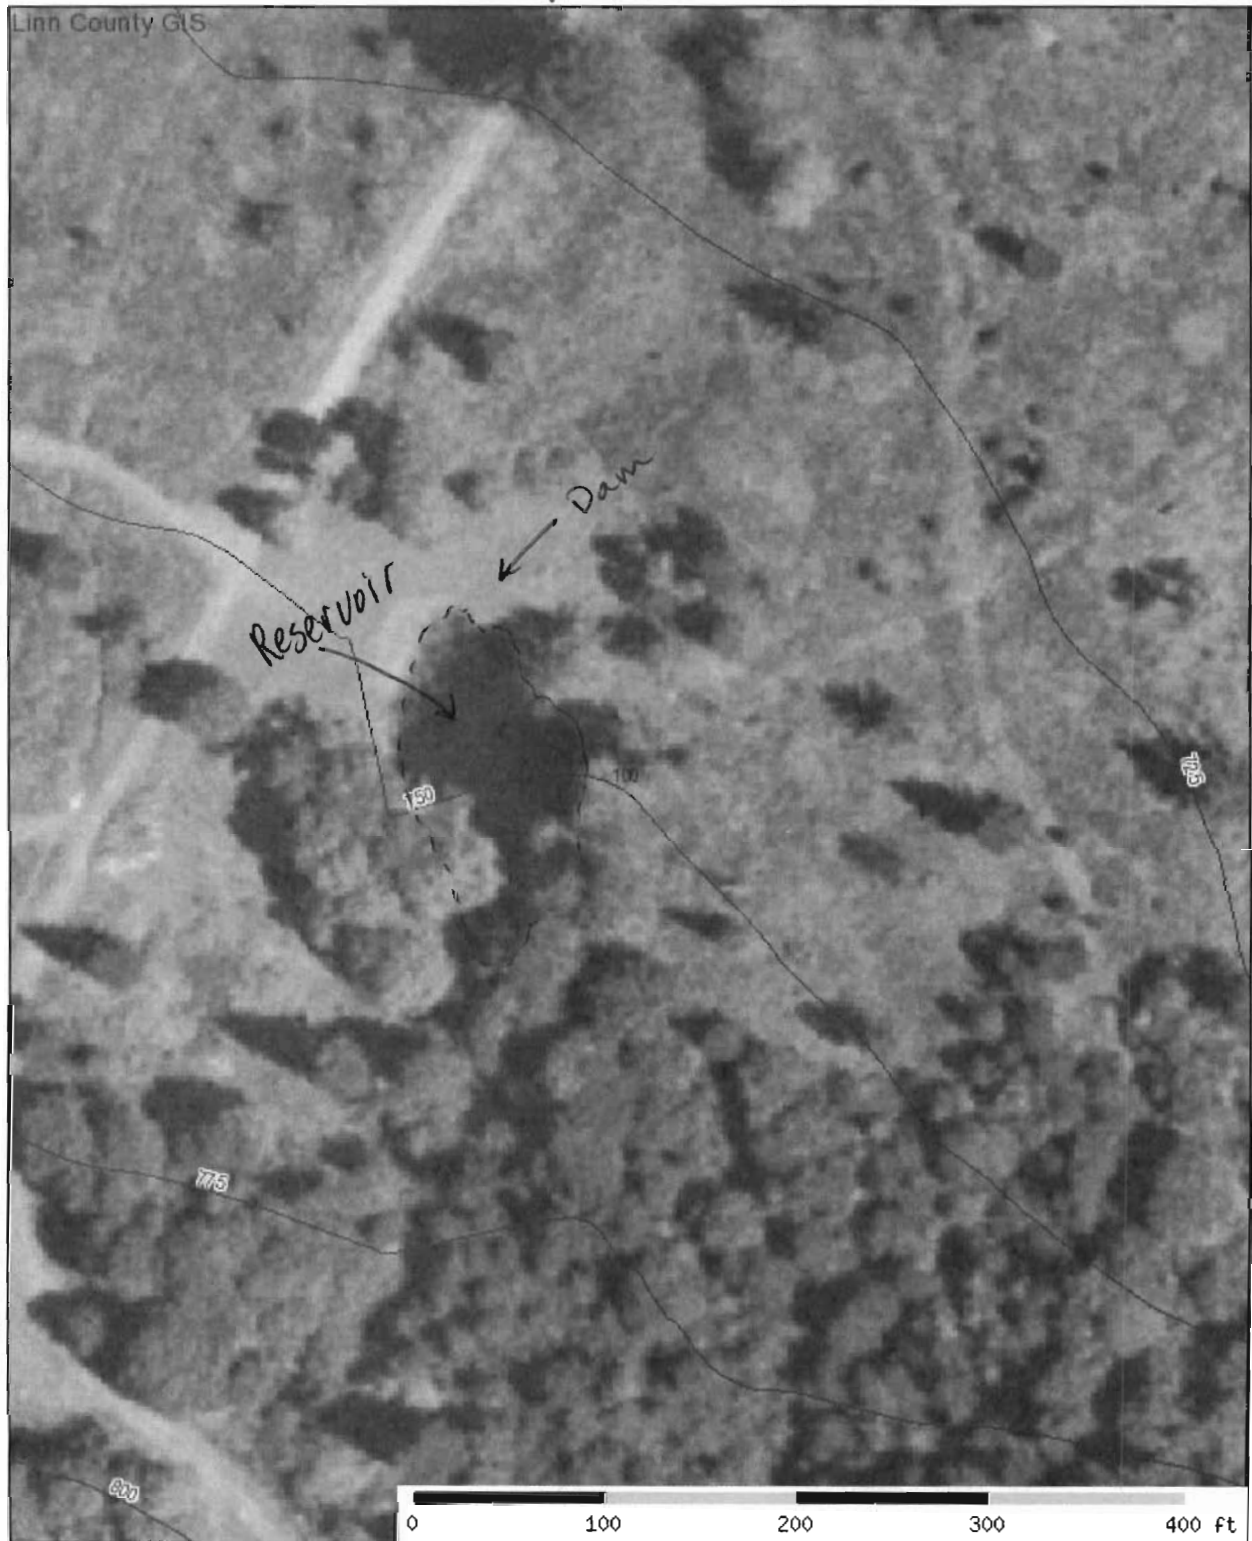


RECEIVED

JUN 25 2008

WATER RESOURCES DEPT.
SALEM, OREGON

Subdivision S-08-02
Ridgeway Butte (East Grant Street)

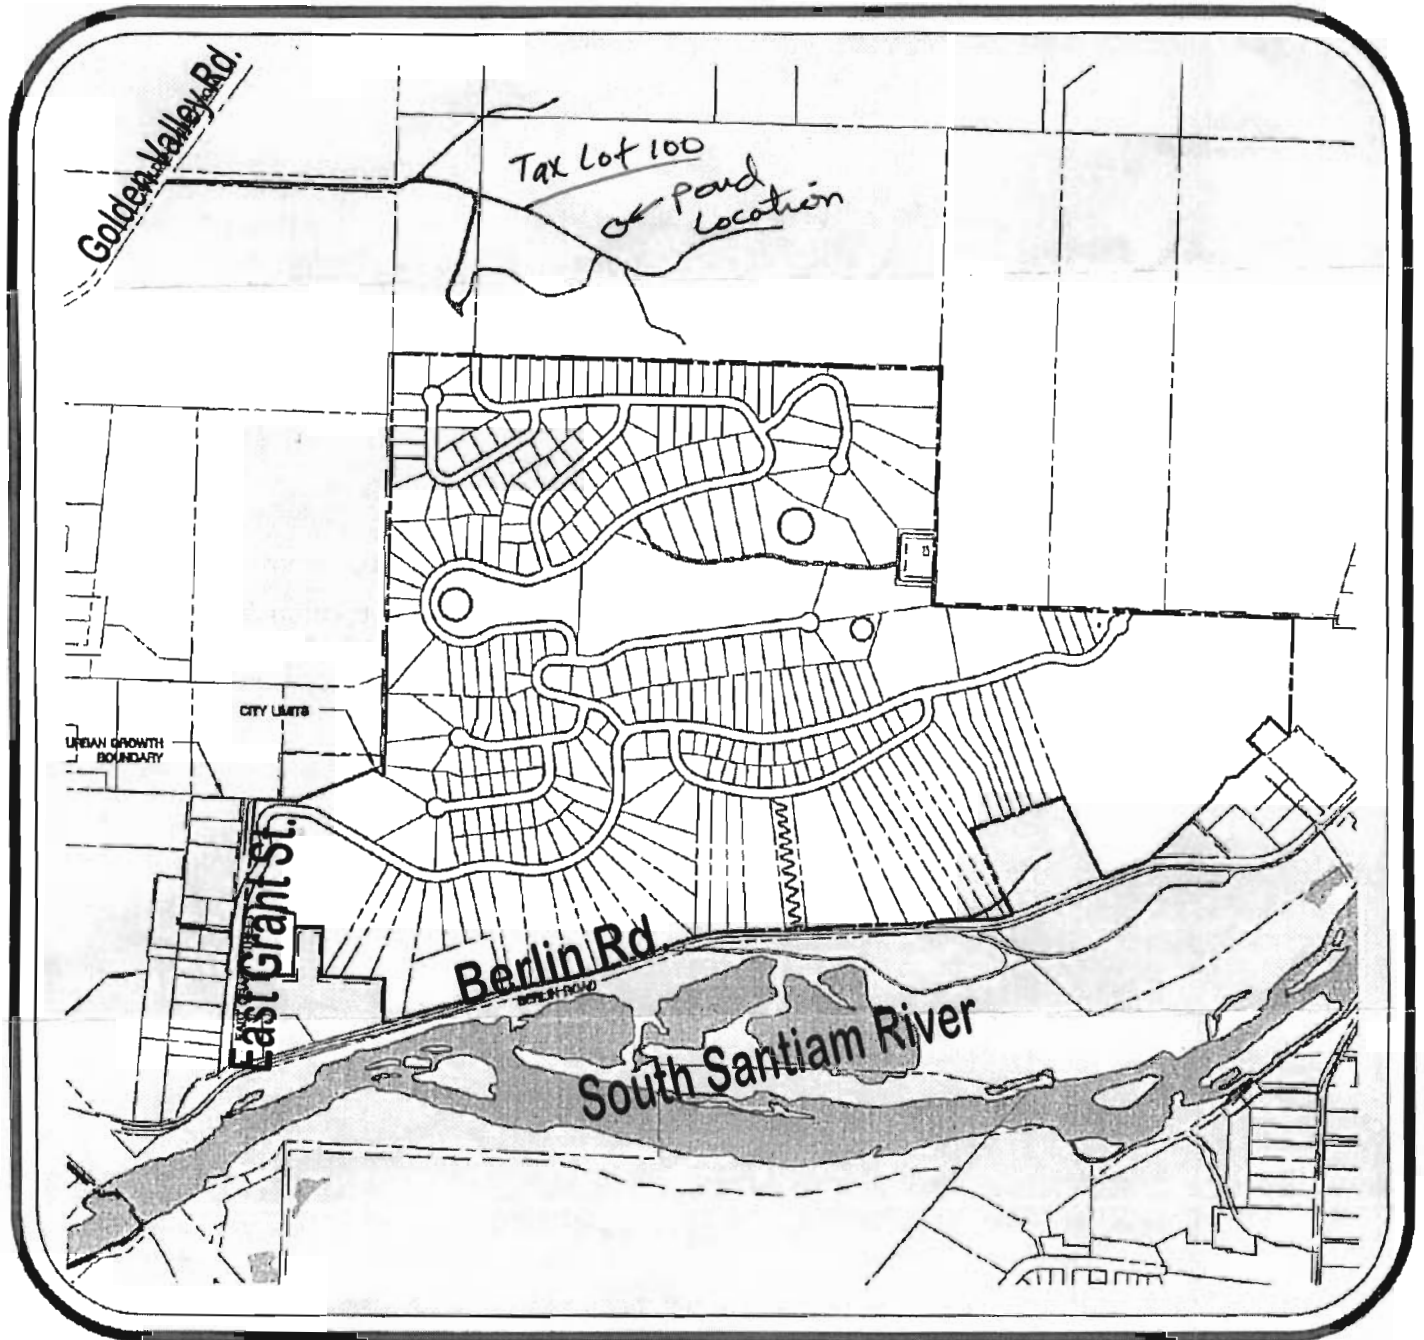

SITE MAP

T=600'



RECEIVED

JUN 25 2008

WATER RESOURCES DEPT.
SALEM, OREGON

Expanded View - 2005 Aerial



RECEIVED

JUN 25 2008

WATER RESOURCES DEPT.
SALEM, OREGON