



Oregon Water Resources Department  
725 Summer Street NE, Suite A  
Salem Oregon 97301  
(503) 986-0900  
www.wrd.state.or.us

RECEIVED

JUN 09 2008

WATER RESOURCES DEPT  
SALEM, OREGON

Application for a Permit to  
**Store Water  
in a Reservoir**  
(Alternate Review)

Alternate Review Process (ORS 537.409): You may use this form for any reservoir storing less than 9.2 acre-feet or with a dam less than 10 feet high.

Use a separate form for each reservoir

Please type or print in dark ink. If your application is found to be incomplete or inaccurate, we will return it to you. If any requested information does not apply, insert "n/a". A summary of review criteria and procedures that are generally applicable to these applications is available at [www.wrd.state.or.us/OWRD/PUBS/forms.shtml](http://www.wrd.state.or.us/OWRD/PUBS/forms.shtml).

**1. APPLICANT INFORMATION**

Landowner: LOU GLOTTONINI (GLOTTONINI FAMILY TRUST)  
First Last

Mailing Address: P.O. Box 13

WEDDERBURN, OREGON 97491  
City State Zip

Phone: 541-247-7232 541-425-0044 (CELL)  
Home Work Other

\*Fax: 541-247-7232 \*E-Mail Address: LOUJOT@HARBORSIDE.COM

\*Optional Information

**2. LOCATION AND SOURCE**

A. Reservoir Name: \_\_\_\_\_

B. Source: Provide the name of the water body or other source from which water will be diverted, and the name of the stream or lake it flows into. Indicate if source is run-off, seepage, or an unnamed stream or spring.

Source: ROWE CREEK Tributary to: JOHN DAY RIVER

**C. Reservoir Location**

| Township<br>(N or S) | Range<br>(E or W) | Section   | quarter/quarter      | tax lot number |
|----------------------|-------------------|-----------|----------------------|----------------|
| <u>T9S</u>           | <u>R21E</u>       | <u>22</u> | <u>SE 1/4 NW 1/4</u> | <u>101</u>     |

D. County of use: WHEELER

E. Dam: Maximum height of dam: 15 feet. If excavated, write "excavated" or "0 feet".

F. Quantity: Amount of water to be stored in the reservoir at maximum capacity. List quantity in Acre-Feet: 2.83

|                |                                        |            |
|----------------|----------------------------------------|------------|
| App. No. _____ | For Department Use<br>Permit No. _____ | Date _____ |
|----------------|----------------------------------------|------------|

RECEIVED

### 3. WATER USE

Indicate the proposed use(s) of the stored water. **NOTE: You may wish to consider filing for "Multipurpose use" for your reservoir. Multipurpose use does not limit the types of future uses for the stored water. Multipurpose covers all uses including: stockwater, fish and wildlife, aesthetics, domestic, irrigation, agriculture, fire protection and pollution abatement.** If any use will be out of reservoir use, regardless of the type of storage listed, a secondary application must be filed to appropriate the stored water. \_\_\_\_\_

MULTI - PURPOSE

### 4. PROPERTY OWNERSHIP

Do you own all the land where you propose to divert, transport, and use water?

☒ Yes (Please check appropriate box below then skip to section 5)

☒ There are no encumbrances

☐ This land is encumbered by easements, rights of way, roads or other encumbrances (please provide a copy of the recorded deed(s))

☐ No (Please check the appropriate box below)

☐ I have a recorded easement or written authorization permitting access.

☐ I do not currently have written authorization or an easement permitting access to lands not under my ownership.

☐ Written authorization or an easement is not necessary, because the only affected lands I do not own are state-owned submersible lands, and this application is for irrigation and/or domestic use only (ORS 274.040). (Do not check this box if you described your use as "Multipurpose" in #3 above.)

List the names and mailing addresses of all affected landowners:

**RECEIVED**

JUN 09 2008

**WATER RESOURCES DEPT  
SALEM, OREGON**

### 5. ENVIRONMENTAL IMPACT

A. **Channel:** Is the reservoir in stream Rowe or off channel \_\_\_\_\_?

B. **Wetland:** Is the project in a wetland? ☐ Yes ☒ No ☐ Don't know

C. **Existing:** Is this an existing reservoir? ☒ Yes ☐ No  
If yes, how long has it been in place? 60 years.

D. **Fish Habitat:** Is there fish habitat upstream of the proposed structure? ☐ Yes ☐ No ☒ Don't know  
If yes, how much? \_\_\_\_\_ miles.

E. **Partnerships:** Have you been working with other agencies? ☐ Yes ☒ No

Indicate agency, staff and phone numbers of those involved. Also indicate any agencies that are cost sharing in this project.

### 6. SIGNATURE

I swear that all statements made and information provided in this application are true and correct to the best of my knowledge.

Landowner Signature

Date

June 4, 2008

Before you submit your application be sure you have:

- Answered each question completely.
- Included a legible map that includes Township, Range, Section, quarter-quarter and tax lot number.
- The map must meet map requirements to be accepted.
- Included a land use form or receipt stub signed by a local planning official.
- Included a check payable to Oregon Water Resources Department for the appropriate amount.

**RECEIVED**

JUN 30 2008

**WATER RESOURCES DEPT  
SALEM, OREGON**

**FEE STRUCTURE:** The fee is based on the number of acre-feet proposed to be stored. The base fee is \$80. In addition, there is a fee of \$20 per acre-foot or fraction thereof. Example: 0.3 AF=\$100; 1.5 AF=\$120; 20.0 AF=\$480; 30.0 AF=\$680.



# Oregon

Theodore R. Kulongoski, Governor

## Water Resources Department

Watermaster District 21  
Gilliam County Courthouse  
P.O. Box 427  
Condon, OR 97823  
(541) 384-4207


14 April 2006

Lou Giottonini  
PO Box 13  
Wedderburn, OR 97451

Mr. Giottonini,

I have put together water rights certificates that may apply to the property you have purchased. Some of the water rights are adjudicated rights (pre 1909 priority date) while others are permit rights (post 1909 priority date). I have also included two maps showing adjudicated rights and permit rights (please note: maps included are not legal documents). If you have questions about the water rights certificates please feel free to contact me. I am hesitant to say which water rights in certain quarter quarters containing multiple owners apply to your property as this process would require a survey by a certified water right examiner.

Regards,

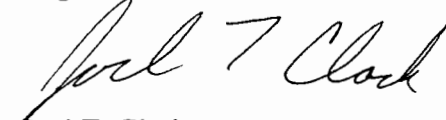

Joel T. Clark

**RECEIVED**

JUN 30 2008

WATER RESOURCES DEPT  
SALEM OREGON

21

22

23

28

27

WATER RESOURCES DEPT  
SALEM, OREGON

JUN 30 2008

RECEIVED

DIV PTS

28  
19

02  
04

02  
28

03  
05

03  
55

38  
04

17  
13

12  
22

03  
55

5080'  
5340'

5050'

5360'

ROWE

JOHN DAY RIVER

PRIMARY  
SUPPLEMENTAL

# FINAL PROOF SURVEY

UNDER

APPLICATION NO. R-22424 PERMIT NO. R-930  
22425 18275


IN NAME OF

## ROWE CREEK RANCH, INC.

SURVEYED APRIL 19, 1955  
SURVEYED MAY 23, 1968

BY T. JONES  
BY V. GARNER

DOV-10N 51  
DOV-10N 53  
DOV-10N 84  
1968 B.

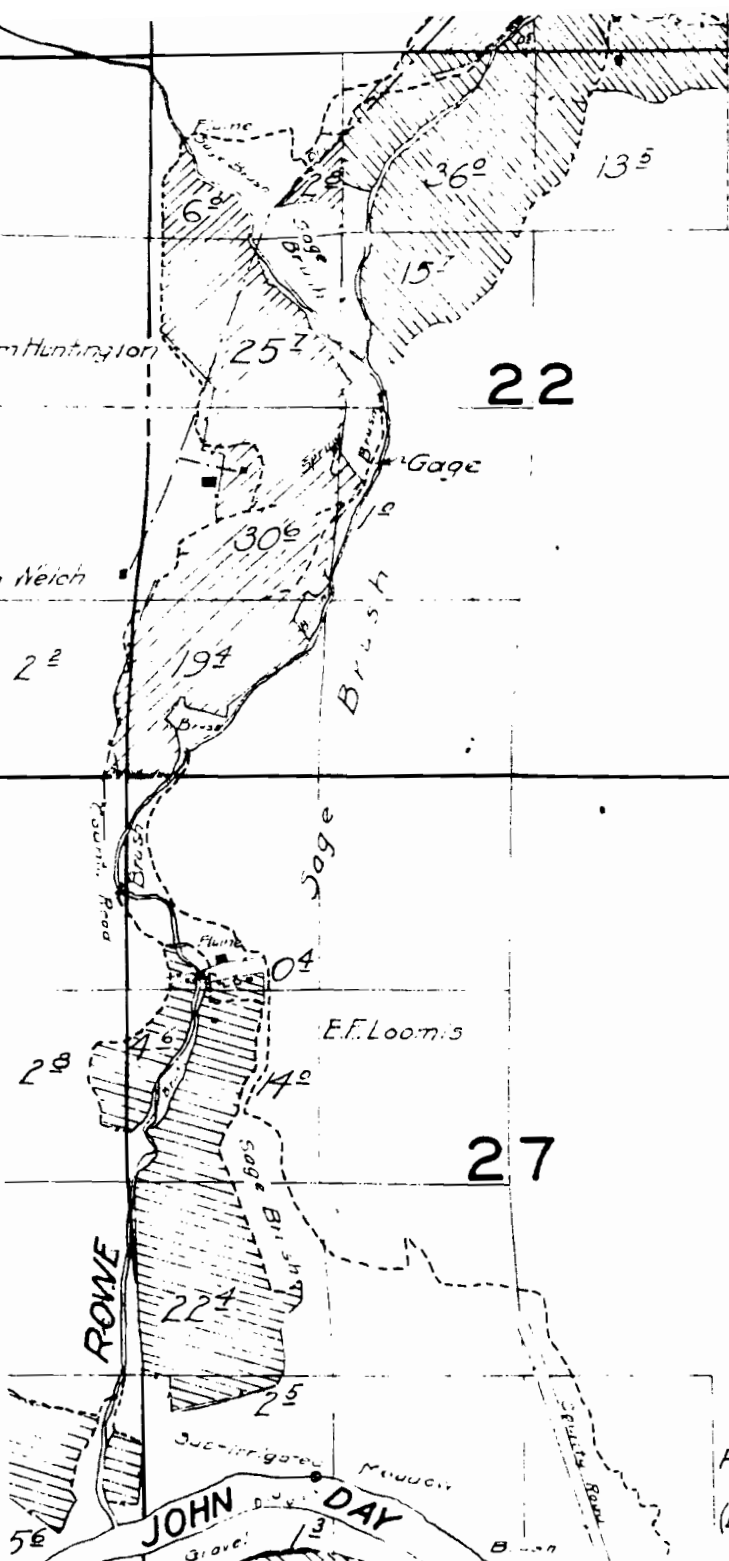

Admiral Wheeler Map No. 1

Surveyed Aug. 30, & 31, & Sept. 1, & 2, 1926.

22

23

2

27

26

25

**RECEIVED**

JUN 30 2008

WATER RESOURCES DEPT  
SALEM, OREGON

Parson Estate  
W. L. Wheeler  
(D.M. Grindstaff)

Spring



## Oregon Water Resources Department Land Use Information Form

THIS FORM IS NOT REQUIRED IF: 1) water is to be diverted, conveyed, and/or used only on federal lands; or 2) the application is for a water-right transfer, allocation of conserved water, exchange, permit amendment, or ground water registration modification, and all of the following apply: a) only the place of use is proposed for change, b) there are no structural changes, c) the use of water is for irrigation, and d) the use is located in an irrigation district or exclusive farm-use zone.

Applicant Name: GIOTTONINI FAMILY TRUST  
 Mailing Address: P.O. BOX 13  
 City: WEDDERBURN State: OR Zip: 97491 Day Phone: 541-247-7232

This application is related to a Measure 37 claim. Yes ☐ No ☒

### A. Land and Location

Please include the following information for all tax lots where water will be diverted (taken from its source), conveyed (transported), or used. Applicants for municipal use, or irrigation uses within irrigation districts may substitute existing and proposed service-area boundaries for the tax-lot information requested below.

| Township  | Range      | Section   | 1/4 1/4     | Tax Lot #  | Plan Designation (e.g. Rural Residential/RR-5) | Water to be:                      |                                   |                                          | Proposed Land Use |
|-----------|------------|-----------|-------------|------------|------------------------------------------------|-----------------------------------|-----------------------------------|------------------------------------------|-------------------|
| <u>9S</u> | <u>24E</u> | <u>22</u> | <u>SENE</u> | <u>101</u> |                                                | <input type="checkbox"/> Diverted | <input type="checkbox"/> Conveyed | <input checked="" type="checkbox"/> Used |                   |
|           |            |           |             |            |                                                | <input type="checkbox"/> Diverted | <input type="checkbox"/> Conveyed | <input type="checkbox"/> Used            |                   |
List all counties and cities where water is proposed to be diverted, conveyed, or used. WHEELER COUNTY

### B. Description of Proposed Use

Type of application to be filed with the Water Resources Department:

- ☒ Permit to Use or Store Water    ☐ Water-Right Transfer    ☐ Exchange of Water  
☐ Allocation of Conserved Water    ☐ Limited Water Use License  
☐ Permit Amendment or Ground Water Registration Modification

Source of water: ☐ Reservoir/Pond    ☐ Ground Water    ☒ Surface Water (name) ROWE CREEK

Estimated quantity of water needed: 2.6 ☒ cubic feet per second    ☐ gallons per minute    ☐ acre-feet

Intended use of water: ☐ Irrigation    ☐ Commercial    ☐ Industrial    ☐ Domestic for    household(s)  
☐ Municipal    ☐ Quasi municipal    ☐ Instream    ☐ Other MULTIPLE USE

Briefly describe: IRRIGATION, FIRE, STOCK

**Note to applicant:** If the Land Use Information Form cannot be completed while you wait, please have a local government representative sign the receipt below and include it with the application filed with the Water Resources Department.

### Receipt for Request for Land Use Information

State of Oregon  
 Water Resources Department  
 725 Summer Street NE, Suite A  
 Salem, OR 97301-1266

## For Local Government Use Only

Signed @  
County  
Planning

The following section must be completed by a planning official from each county and city listed unless the project will be located entirely within the city limits. In that case, only the city planning agency must complete this form.

This deals only with the local land-use plan. Do not include approval for activities such as building or grading permits.

**Please check the appropriate box below and provide the requested information**

☒ Land uses to be served by proposed water uses (including proposed construction) are allowed outright or are not regulated by your comprehensive plan. Cite applicable ordinance section(s): \_\_\_\_\_

☐ Land uses to be served by proposed water uses (including proposed construction) involve discretionary land-use approvals as listed in the table below. (Please attach documentation of applicable land-use approvals which have already been obtained. Record of Action/land-use decision and accompanying findings are sufficient.)

**If approvals have been obtained but all appeal periods have not ended, check "Being pursued".**

| Type of Land-Use Approval Needed<br>(e.g. plan amendments, rezones,<br>conditional-use permits, etc.) | Cite Most Significant, Applicable Plan<br>Policies & Ordinance Section References | Land-Use Approval:                                                   |                                                                                      |
|---|-----------------------------------------------------------------------------------|----------------------------------------------------------------------|--------------------------------------------------------------------------------------|
|   |                                                                                   | <input type="checkbox"/> Obtained<br><input type="checkbox"/> Denied | <input type="checkbox"/> Being pursued<br><input type="checkbox"/> Not being pursued |
|   |                                                                                   | <input type="checkbox"/> Obtained<br><input type="checkbox"/> Denied | <input type="checkbox"/> Being pursued<br><input type="checkbox"/> Not being pursued |
|   |                                                                                   | <input type="checkbox"/> Obtained<br><input type="checkbox"/> Denied | <input type="checkbox"/> Being pursued<br><input type="checkbox"/> Not being pursued |
|   |                                                                                   | <input type="checkbox"/> Obtained<br><input type="checkbox"/> Denied | <input type="checkbox"/> Being pursued<br><input type="checkbox"/> Not being pursued |
|   |                                                                                   | <input type="checkbox"/> Obtained<br><input type="checkbox"/> Denied | <input type="checkbox"/> Being pursued<br><input type="checkbox"/> Not being pursued |

Local governments are invited to express special land-use concerns or make recommendations to the Water Resources Department regarding this proposed use of water below, or on a separate sheet.

---

---

---

---

---

---

---

---

Name: Theressa W. Ward Title: County Planner  
 Signature: [Signature] Phone: 541-763-2126 Date: 6/26/2008  
 Government Entity: Wheeler County

**Note to local government representative:** Please complete this form or sign the receipt below and return it to the applicant. If you sign the receipt, you will have 30 days from the Water Resources Department's notice date to return the completed Land Use Information Form or WRD may presume the land use associated with the proposed use of water is compatible with local comprehensive plans.

**Receipt for Request for Land Use Information**

**RECEIVED**

Applicant name: \_\_\_\_\_

JUN 30 2008

City or County: \_\_\_\_\_ Staff contact: \_\_\_\_\_

**WATER RESOURCES DEPT  
SALEM, OREGON**

Signature: \_\_\_\_\_ Phone: \_\_\_\_\_ Date: \_\_\_\_\_