


**APPLICATION FOR PERMIT TO STORE WATER
IN EXISTING RESERVOIR (circa 1950)
(Alternative Review)**

**Existing reservoir situated in
SE 1/4, NW 1/4 of Section 22, T.9S., R.21E., W.M.**

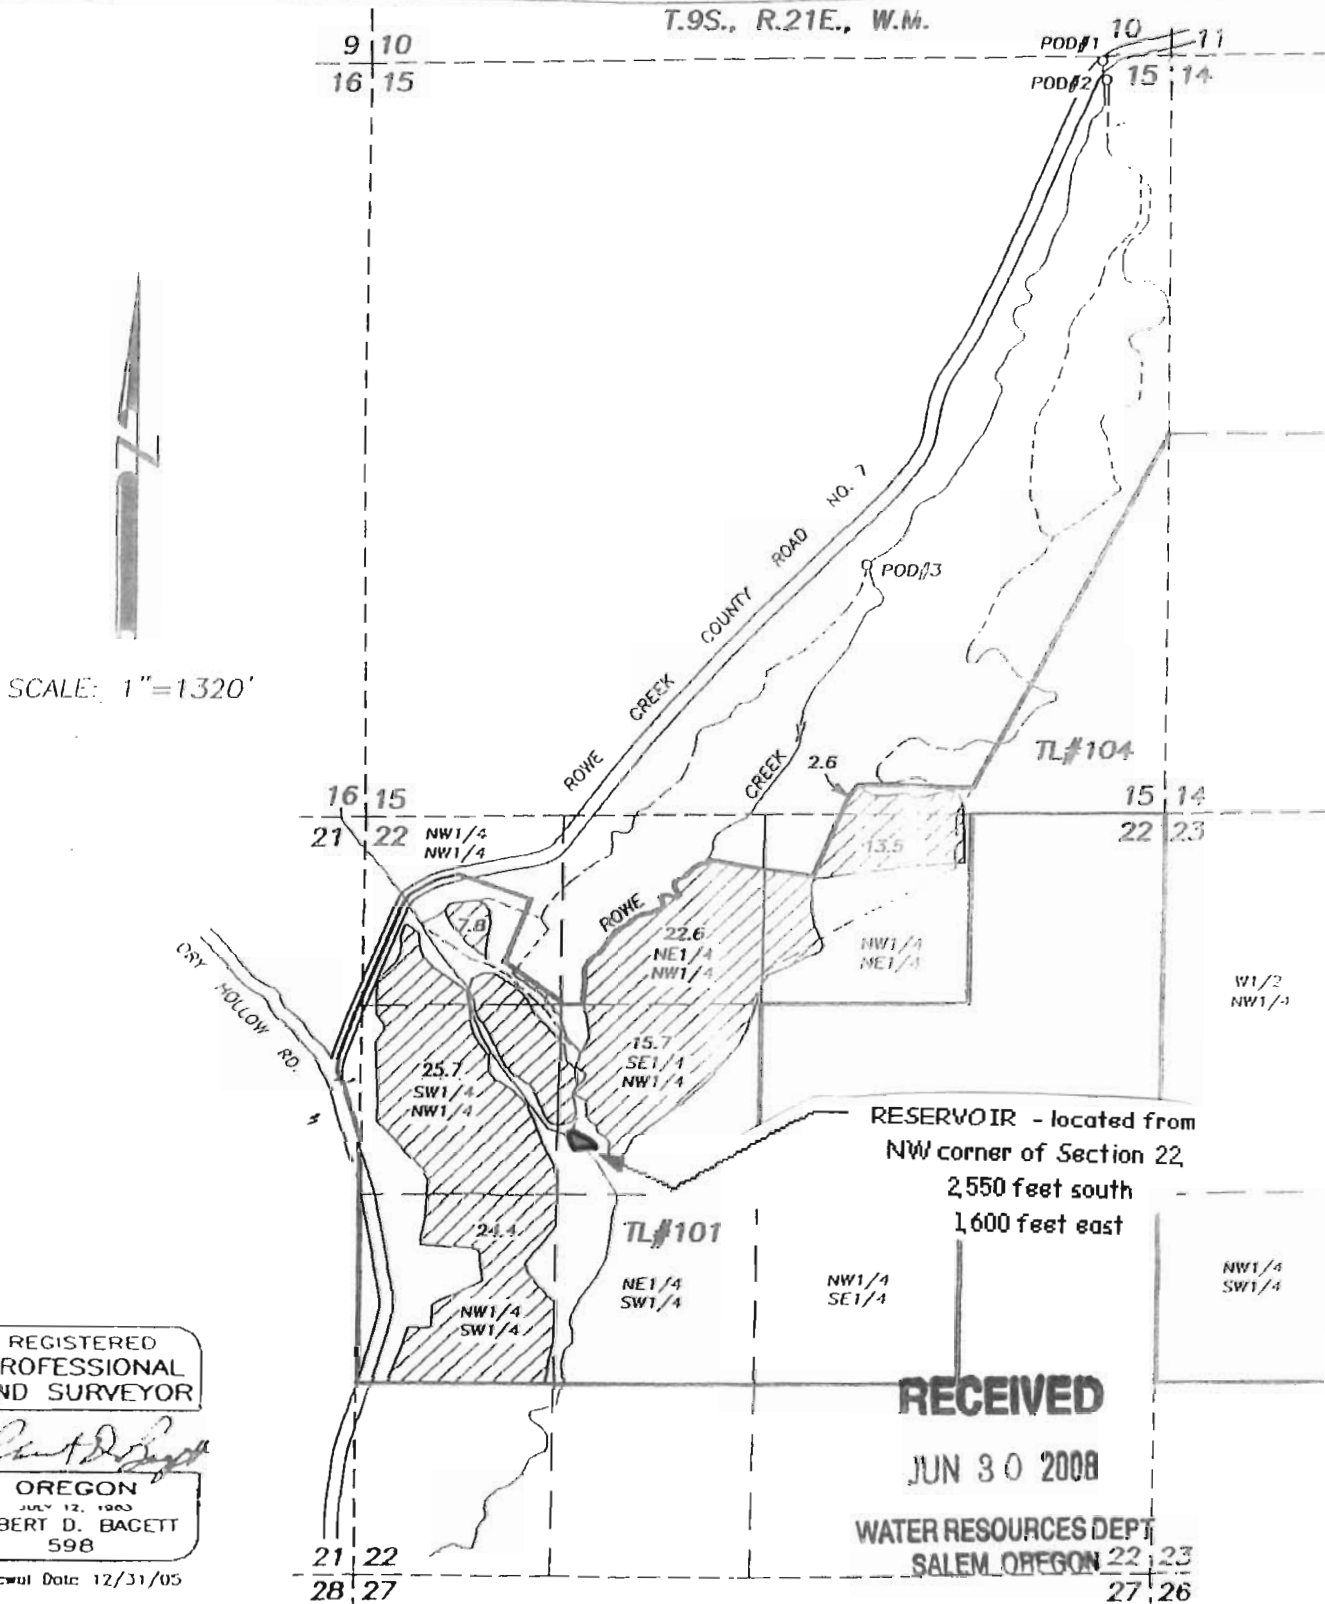

CERTIFICATE NO. 25422

PREPARED FOR

BY

T.9S., R.21E., W.M.



CERTIFICATE NO. 25892

PREPARED FOR

BY

217 N. CANYON BLVD.

Certified Water Right Examiner
009
Robert D. Baggett
Robert D. Baggett
Nov. 19, 1987
STATE OF OREGON

DRY HOLLOW RD

WATER RESOURCES DEPT
SALEM, OREGON

WATER RIGHT MAP

CERTIFICATE NO. 36701

SITUATED IN SECTIONS 15 AND 22, T.9S., R.21E., W.M.

WHEELER COUNTY, OREGON

MARCH 19, 2007

PREPARED FOR


LOU GIOTTONINI

BY

BAGETT, GRIFFITH & BLACKMAN
PROFESSIONAL LAND SURVEYORS

217 N. CANYON BLVD.

JOHN DAY, OREGON

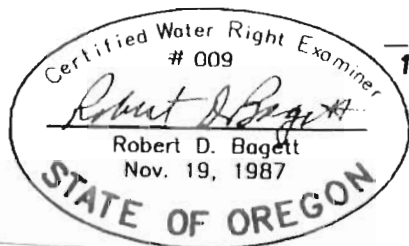

POD#1 IS 30 FEET SOUTH AND 460 FEET WEST OF THE
NE CORNER OF SECTION 15, T.9S., R.21E.


POD#2 IS 60 FEET SOUTH AND 430 FEET WEST OF THE
NE CORNER OF SECTION 15, T.9S., R.21E.

POD#3 IS 3560 FEET SOUTH AND 1980 FEET WEST OF
THE NE CORNER OF SECTION 15, T.9S., R.21E.



SCALE: 1"=1320'

DRY HOLLOW RD.

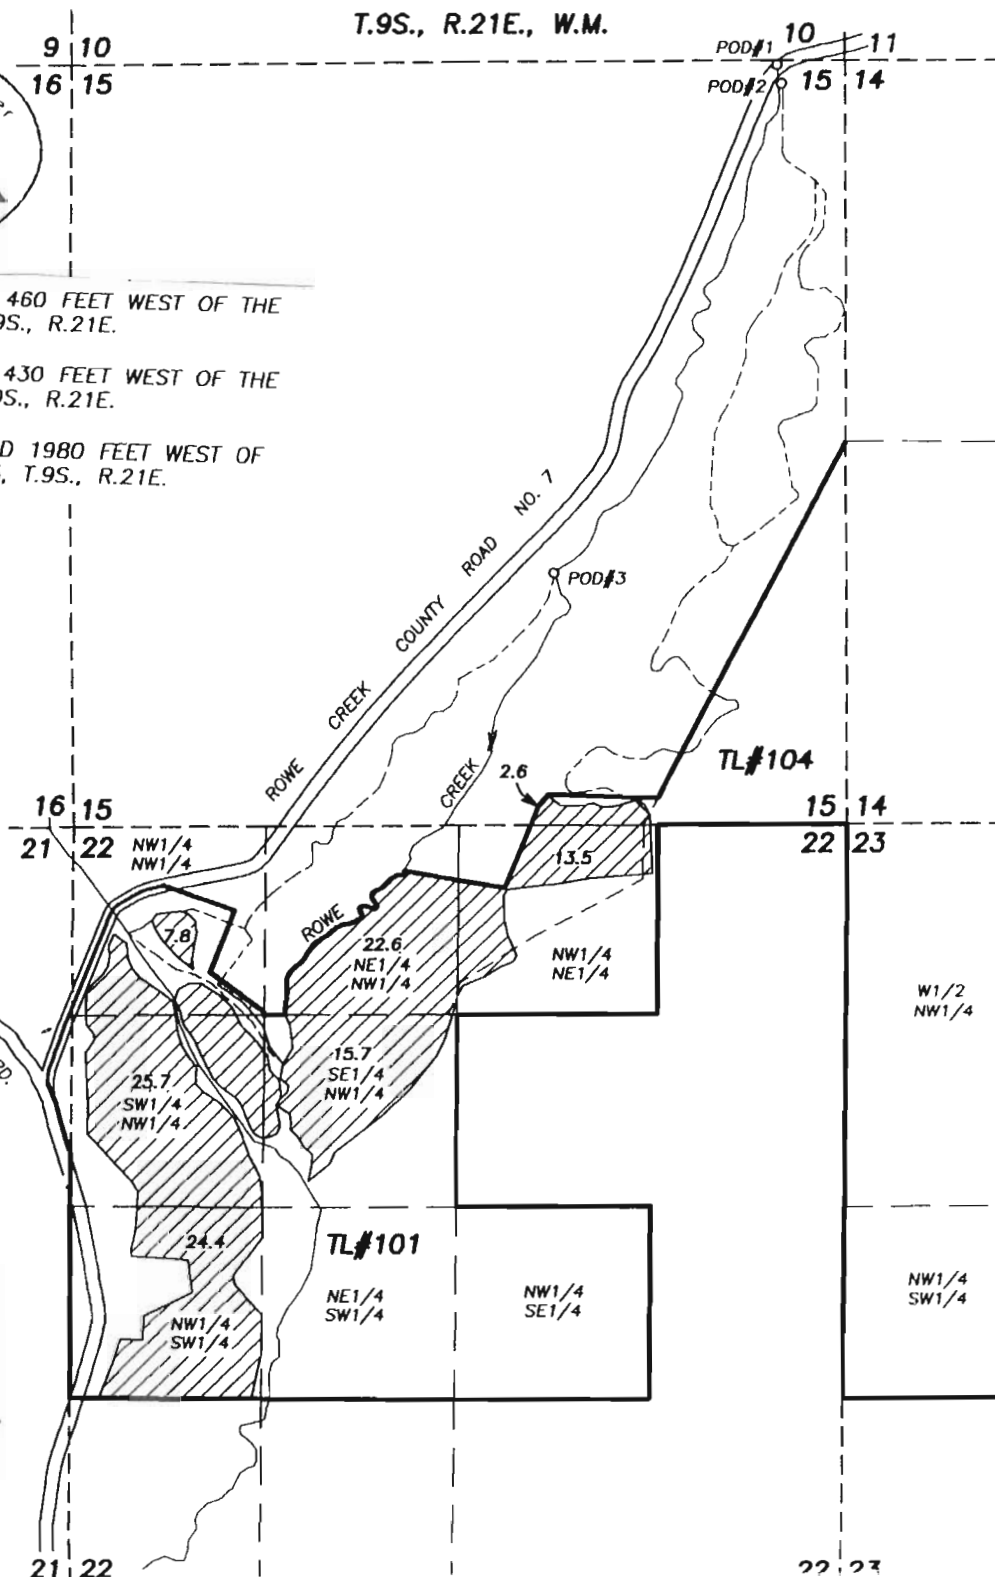

RECEIVED

JUN 30 2008

WATER RESOURCES DEPT
SALEM, OREGON

Big Bottom Ranch - Reservoir

T 9 S R 21 Section 22



0 1,300 2,600 5,200 Feet

RECEIVED

JUN 30 2008

WATER RESOURCES DEPT
SALEM, OREGON

RECEIVED

JUN 09 2008

WATER RESOURCES DEPT
SALEM, OREGON

7
N