


SECTION 03 T.21S. R.46E. W.M. MALHEUR COUNTY

1" = 400'

RESERVOIR LOCATED FROM
NW CORNER SECTION 3
2250 FE EAST
250 FE SOUTH

Danfopp
7/8/08

SEE MAP 20S 46E

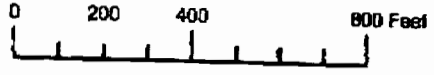

WRD 1ST FL

93 34

4

3

100
82.80
AC.

200
94.67
AC.

LOT 4

39.50

LOT 3 39.60

LOT 2 39.60

RIVER

STANDARD RD

OWYHEE

RIVER

WATER RESOURCES DEPT
SALEM, OREGON

RECEIVED
JUL 07 2008

07/08/2008 09:25 5039860901







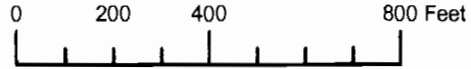


SECTION 03 T.21S. R.46E. W.M. MALHEUR COUNTY

1" = 400'

93 34

SEE MAP 20S 46E

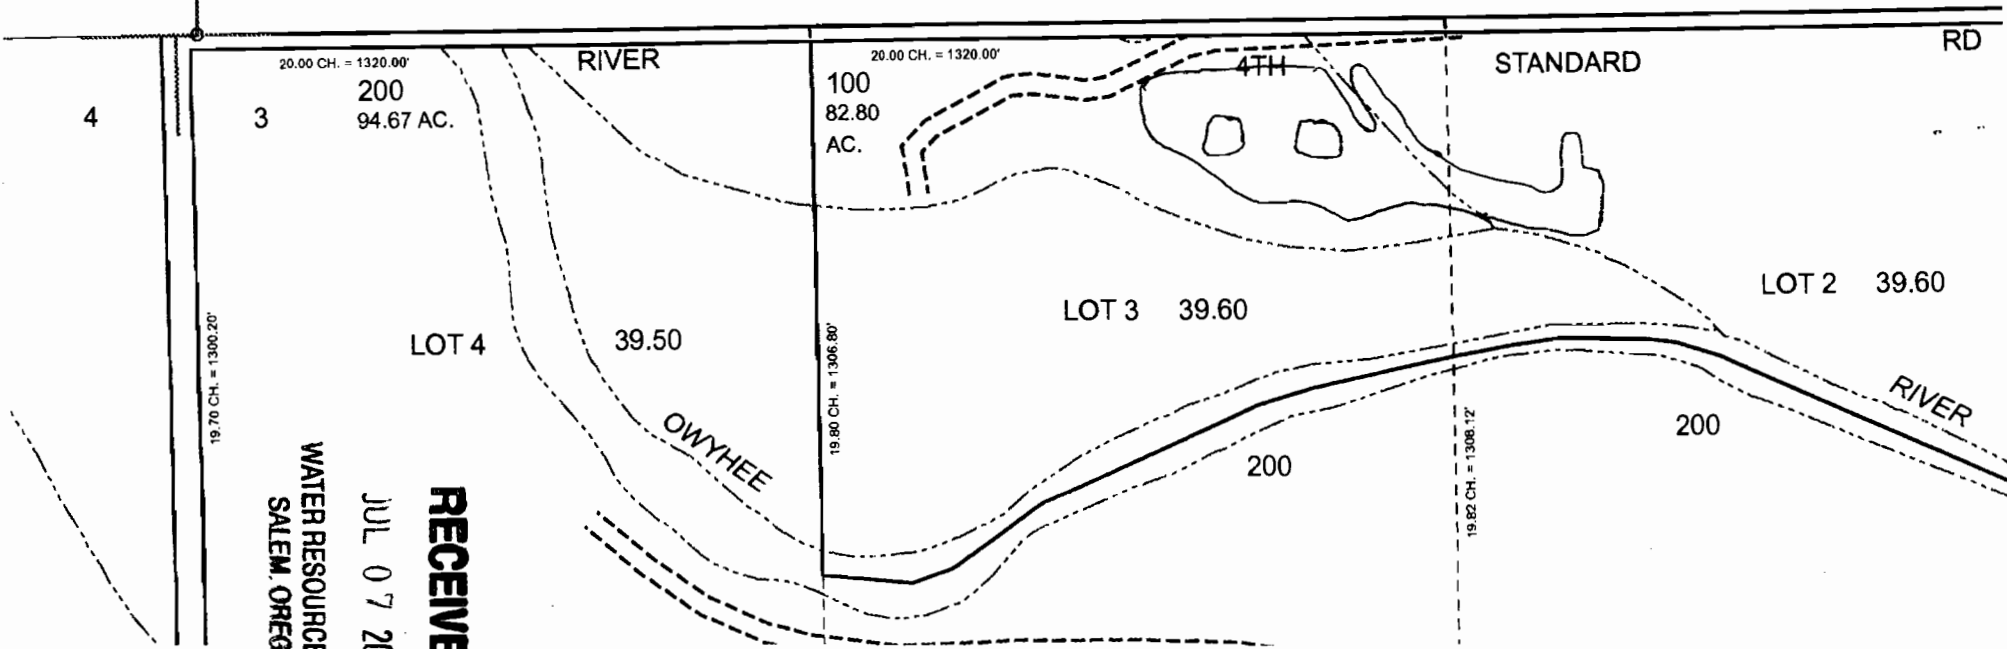

WATER RESOURCES DEPT
SALEM, OREGON

JUL 07 2008

RECEIVED