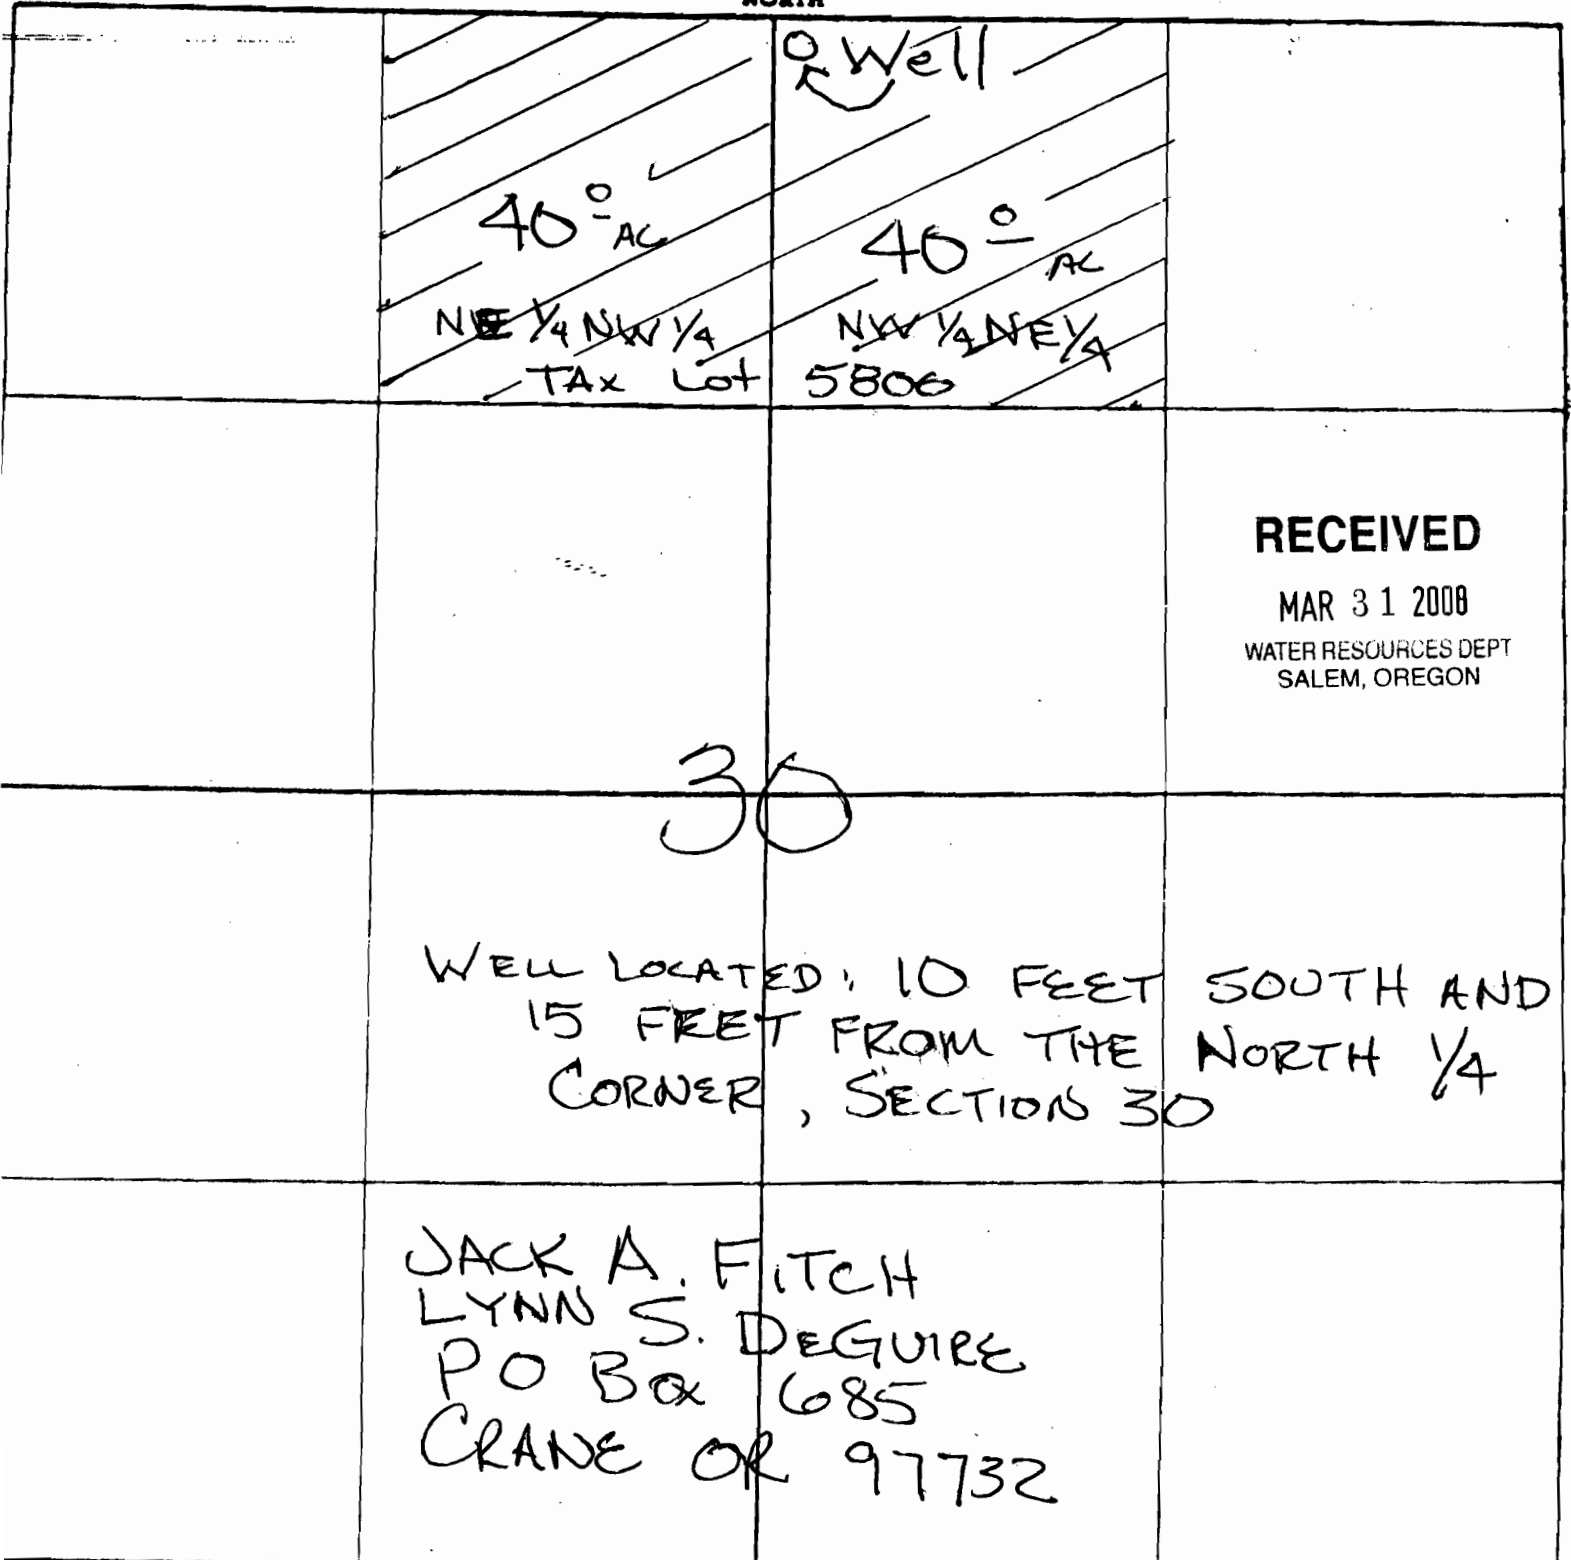


# APPLICATION MAP

## SECTION PLAT

Section 30 Township 26 South Range 33 East, WM  
County of HARNEY State of OREGON

NORTH

|  |                                                                                    |                                                                         |
|--|------------------------------------------------------------------------------------|-------------------------------------------------------------------------|
|  |  |                                                                         |
|  |                                                                                    | <b>RECEIVED</b><br>MAR 31 2008<br>WATER RESOURCES DEPT<br>SALEM, OREGON |
|  |                                                                                    |                                                                         |
|  |                                                                                    |                                                                         |

App No G17028 SCALE 8" = 1 mile