


T 20 S , R 2 W

Sec 6 TL 2400 = SW SW.

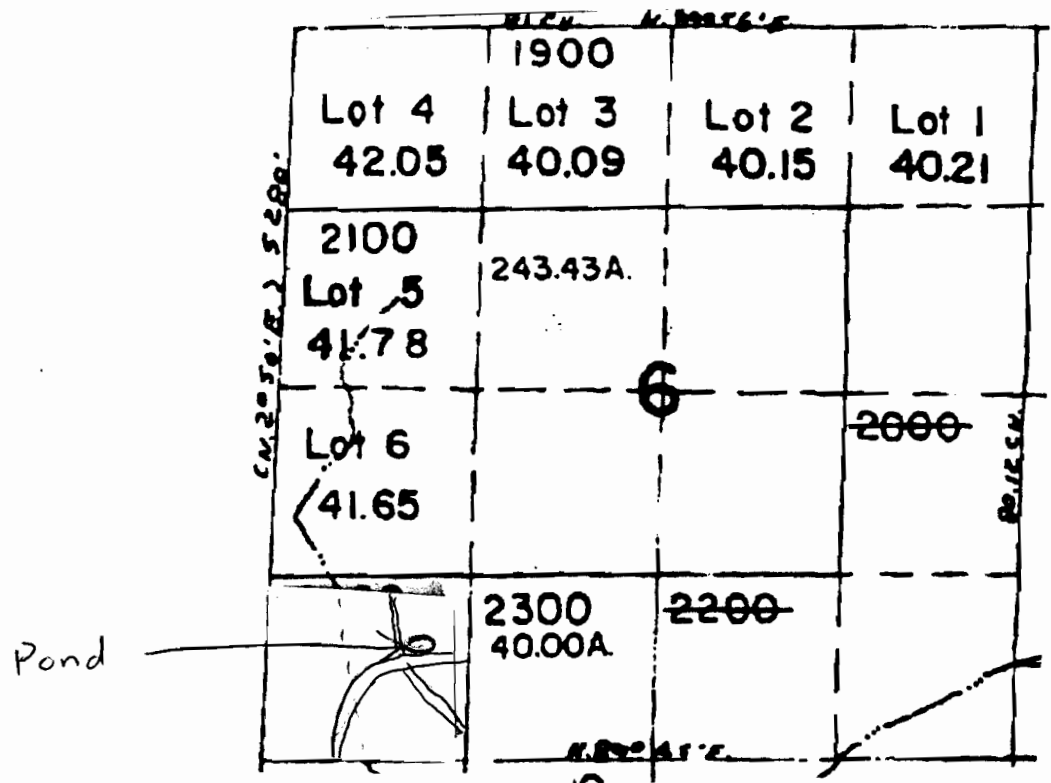

scale 4" = 1 mile

Pond 820' North and 1050' East
from SW corner Section 6

150' wide x 50' x 10' deep (9' tall)

RECEIVED

JUL 14 2008

WATER RESOURCES DEPT.
SALEM, OREGON