


T. 25 S., R. 6 W., W. M.

Scale: 1" = 1000'

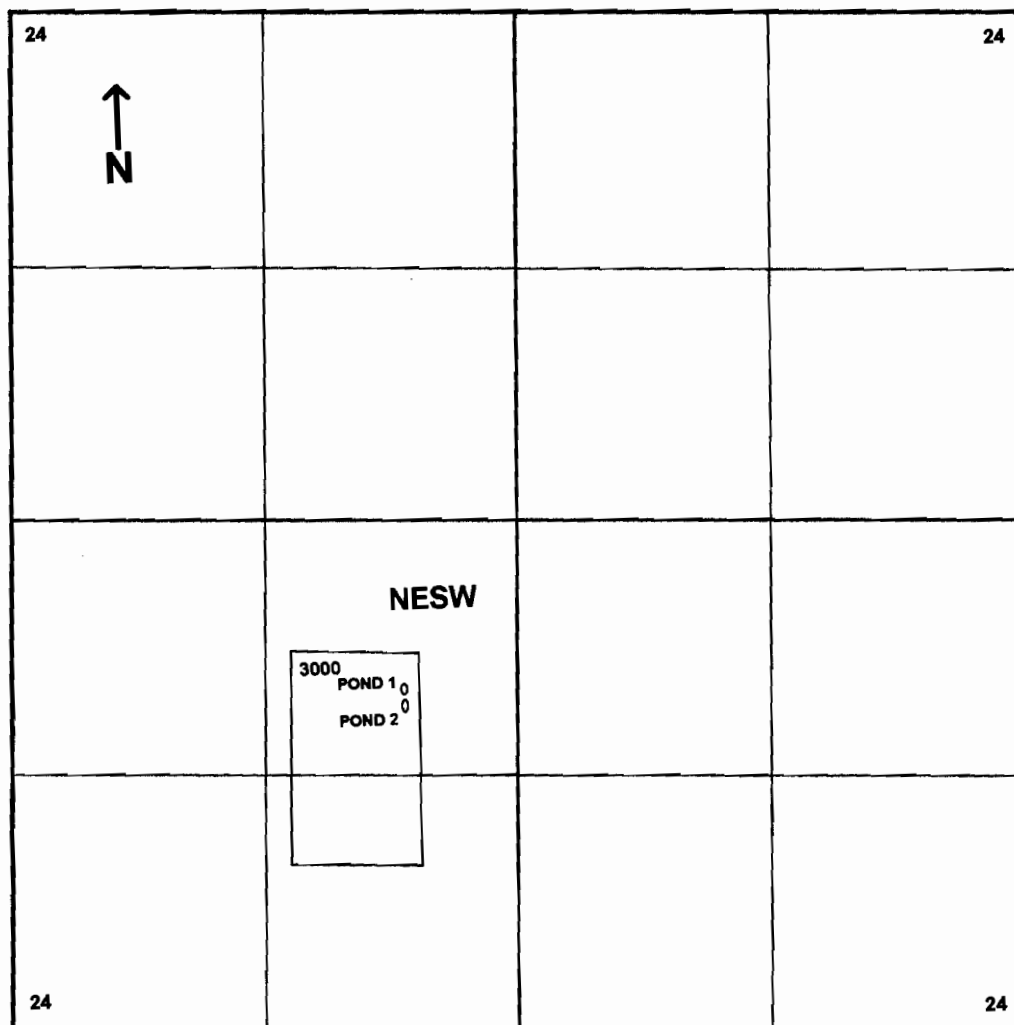

POND 1 - 860 ft. S. and 580 ft. W. } from the center of Sec. 24
POND 2 - 950 ft. S. and 580 ft. W.

RECEIVED

JUL 14 2008

WATER RESOURCES DEPT
SALEM, OREGON

DOUGLAS COUNTY

1" = 400'

3-13-06


25 6 24
& INDEX
SUTHERLIN

SEE MAP 25 6 13C

SEE MAP 25 6 13CD

SEE MAP 25 6 13DC

SEE MAP 25 6 13

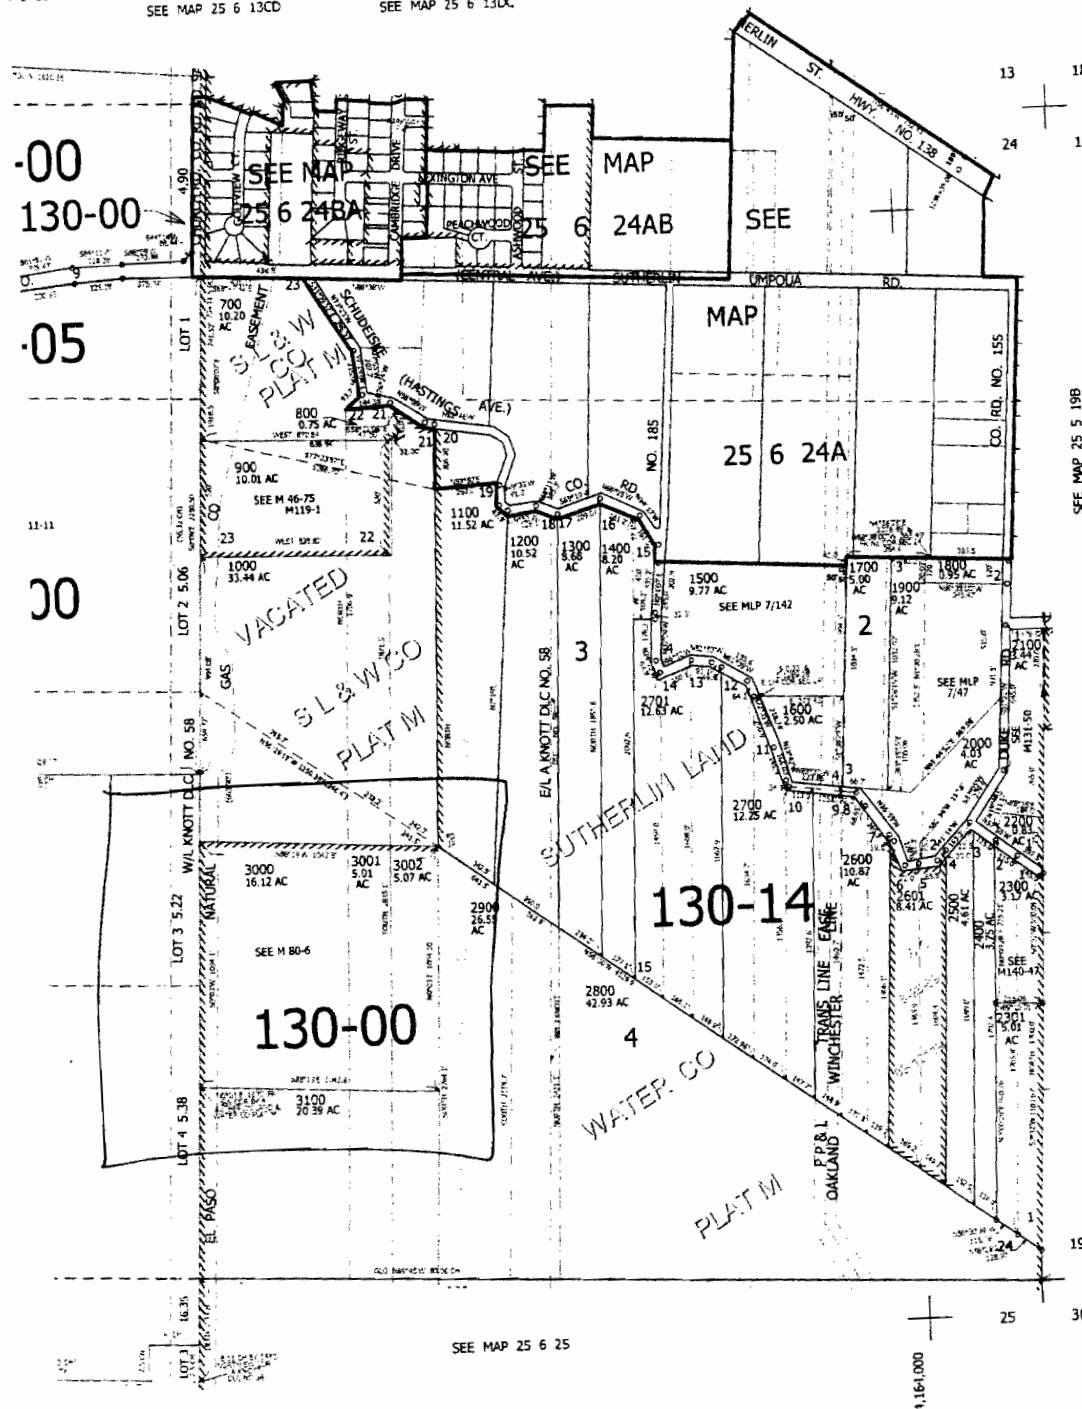

CANCELLED NOS
400A1 102 500
200 101 100
300 502 400
503 501

PARCEL 101

1. 1000 AC
2. 1000 AC
SEE MAP 25 5 19B

SEE MAP 25 5 19C

25 6 24
& INDEX
SUTHERLIN

RECEIVED

JUL 14 2008

WATER RESOURCES DEPT
SALEM, OREGON