


# T.2S.R.24E.W.M.

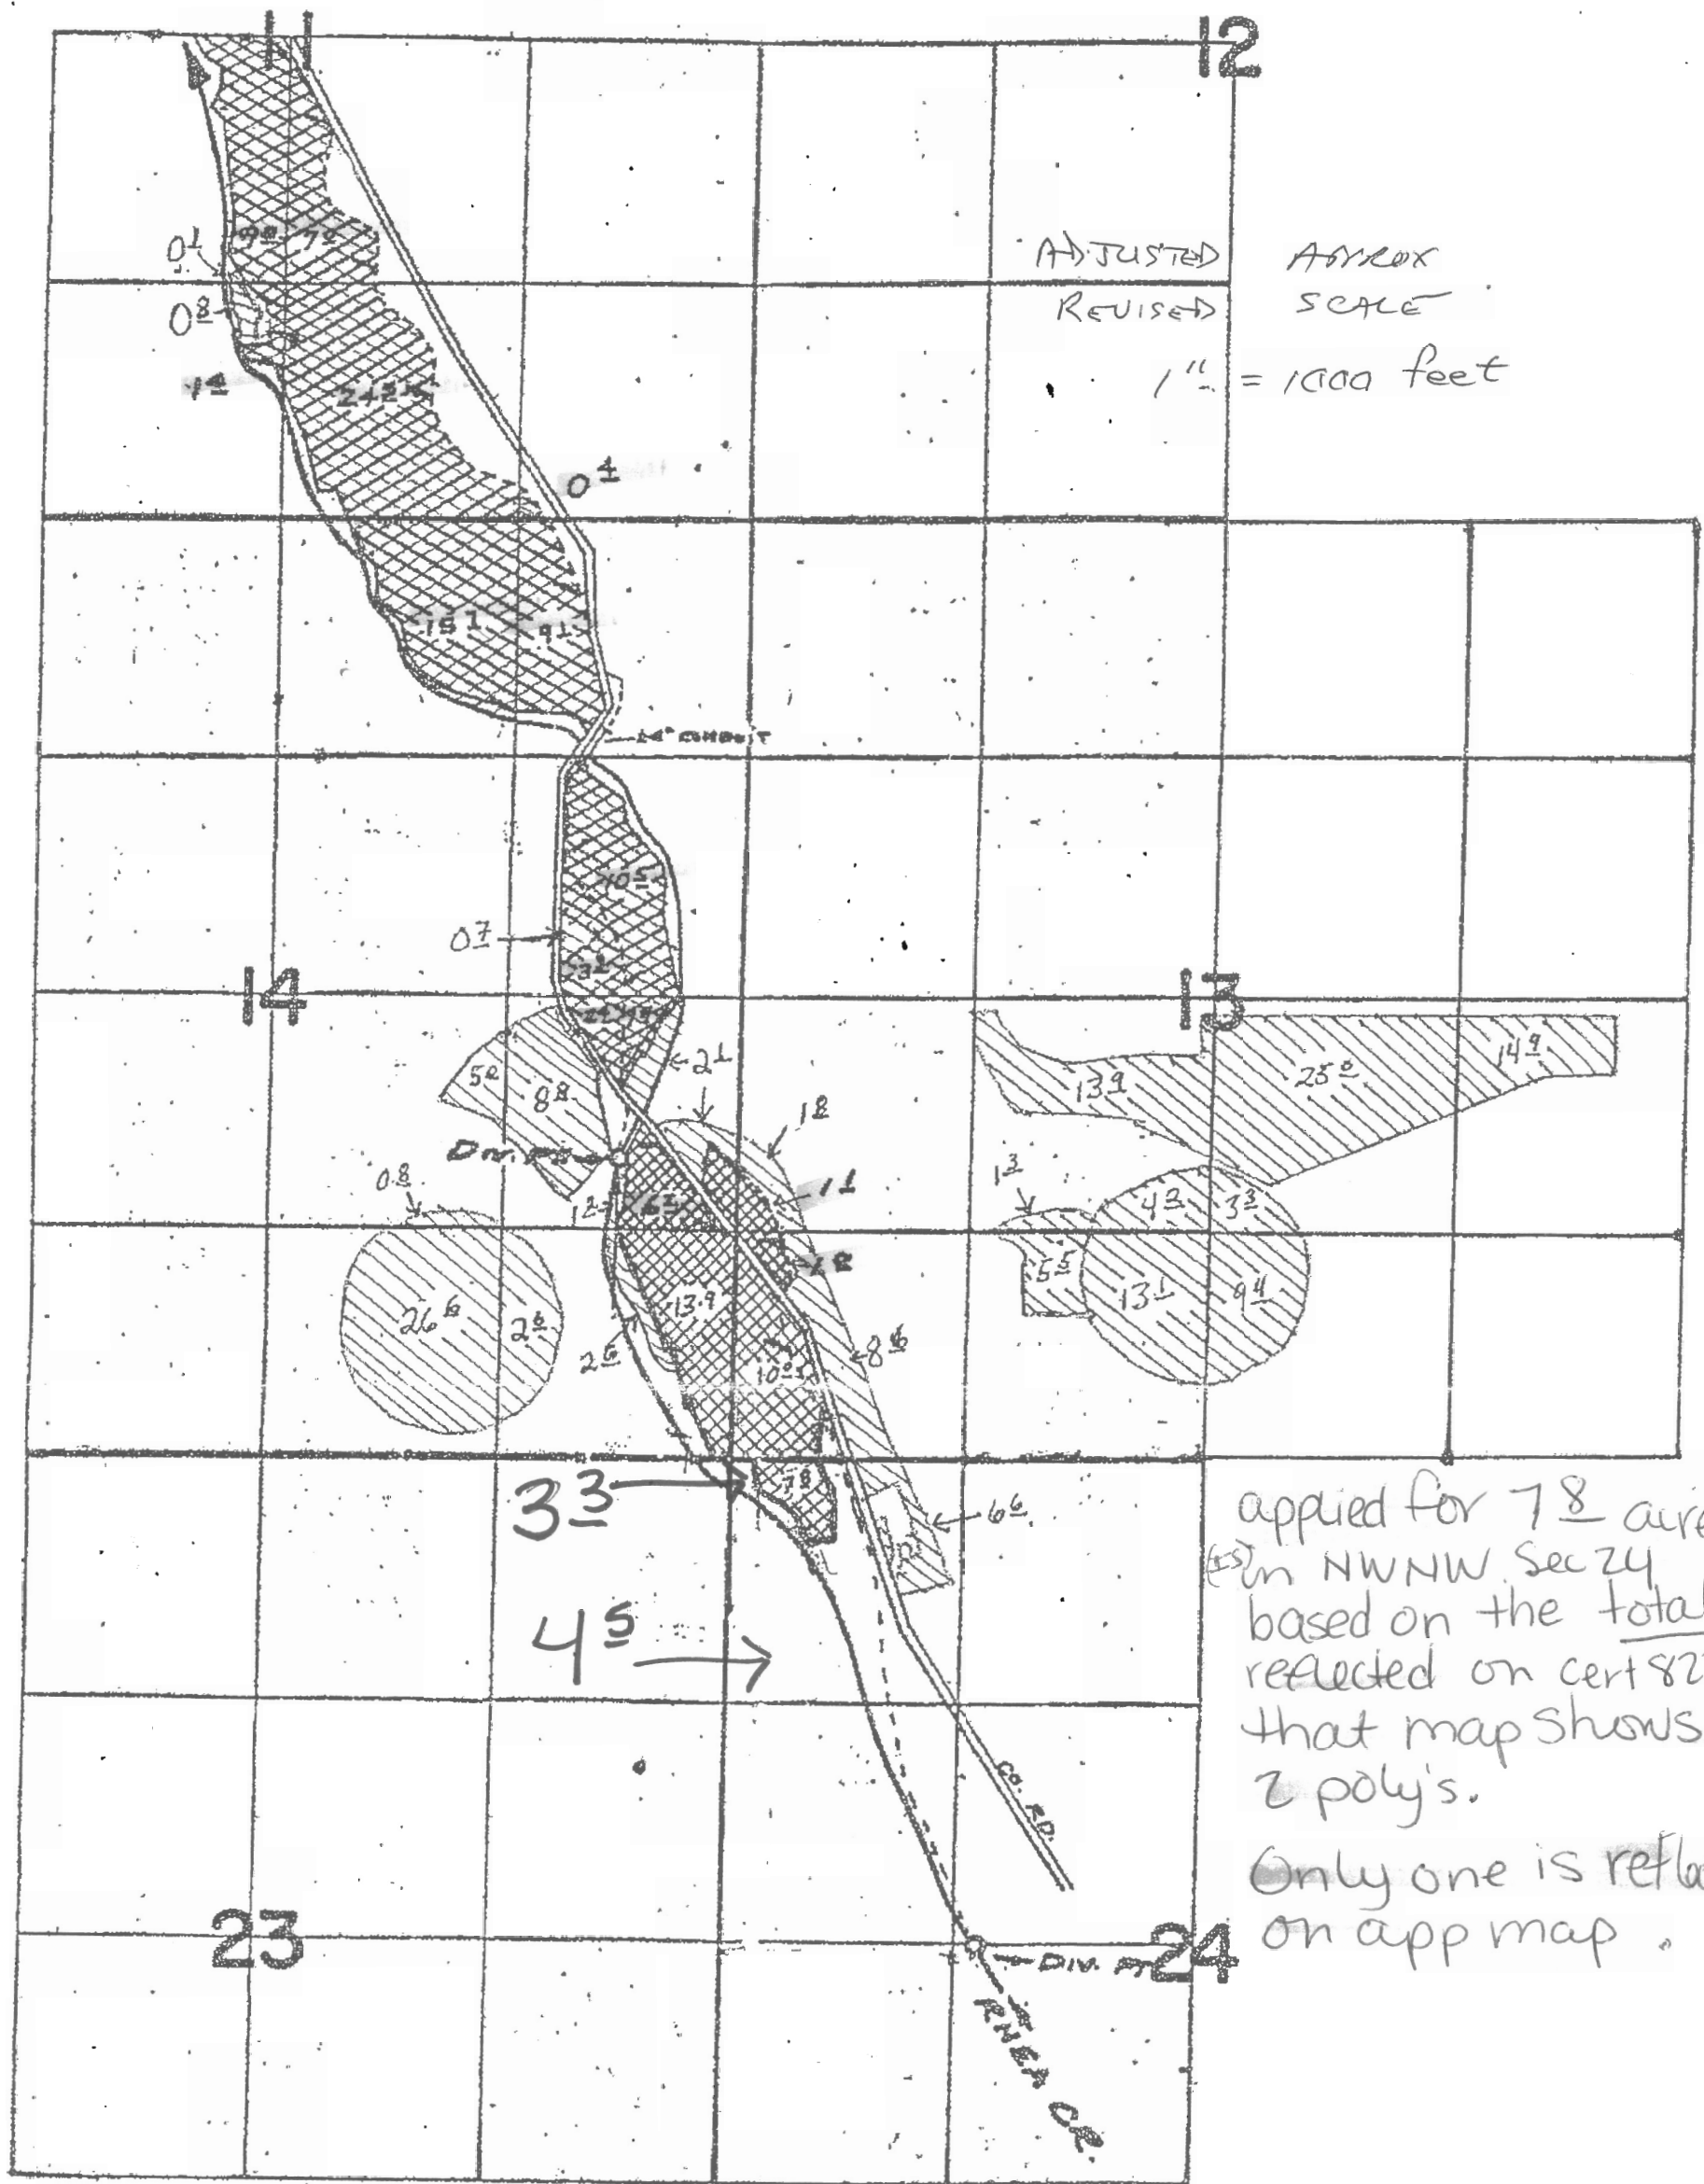

Primary

Supplemental

RECEIVE


DEC 03 2007

WATER RESOURCES D  
SALEM, OREGON

MAP FOR APPLICATION PERMIT USE FOR GROUND WATER

HW and JF (Pachy) Buens

63131 RIVER CREEK ROAD IONE OR

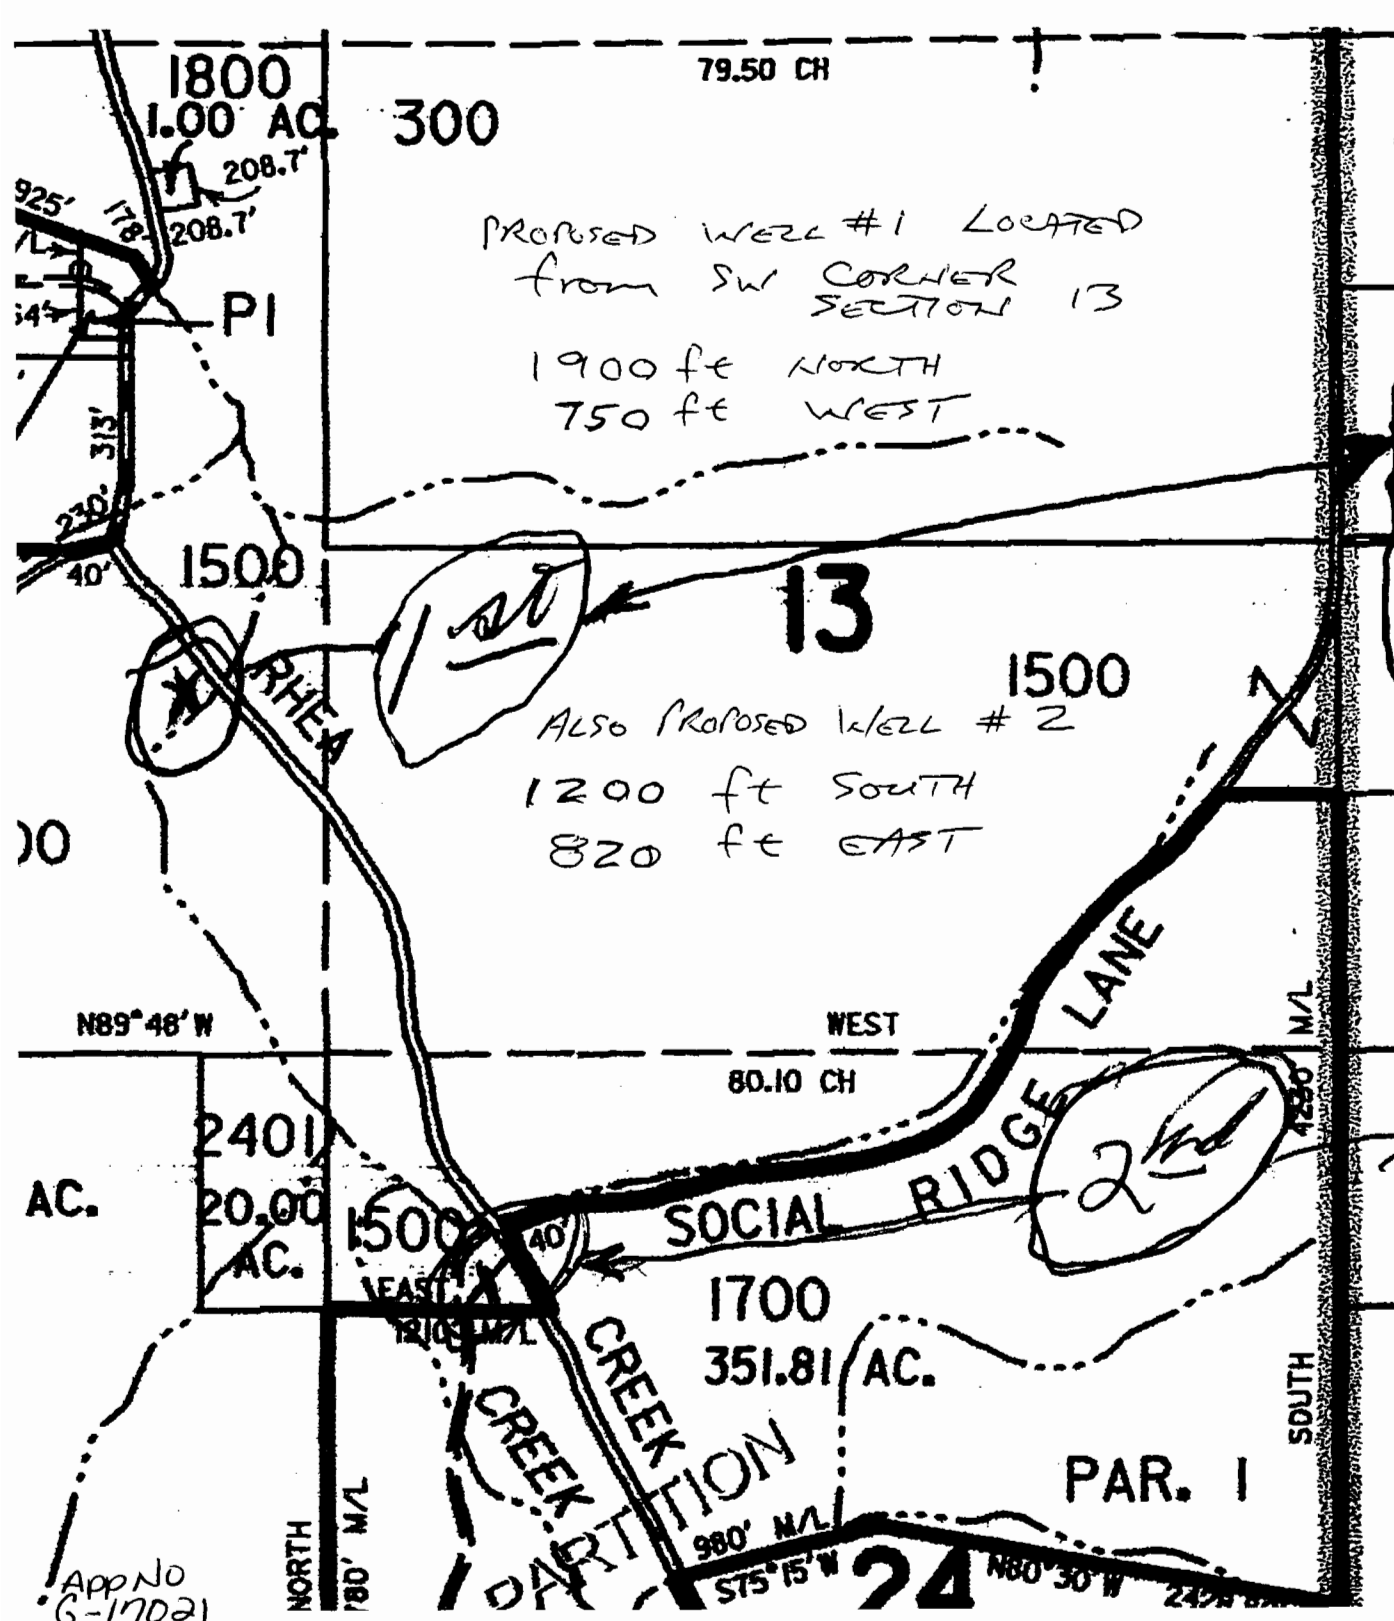

1<sup>st</sup> well  
Proposed  
~~center of~~  
NE 1/4; SE 1/4 sec 13  
T2S; 24E.W.1.


SEE MAR 25 25

2<sup>nd</sup> well  
Proposed  
NE 1/4; NE 1/4  
sec 24  
T2S; 24E.W.1.

REVISED CORRECTED  
APPROX SCALE  
1" = 1000 FEET

App No  
G-17021

T.2S.R.24E.W.M.

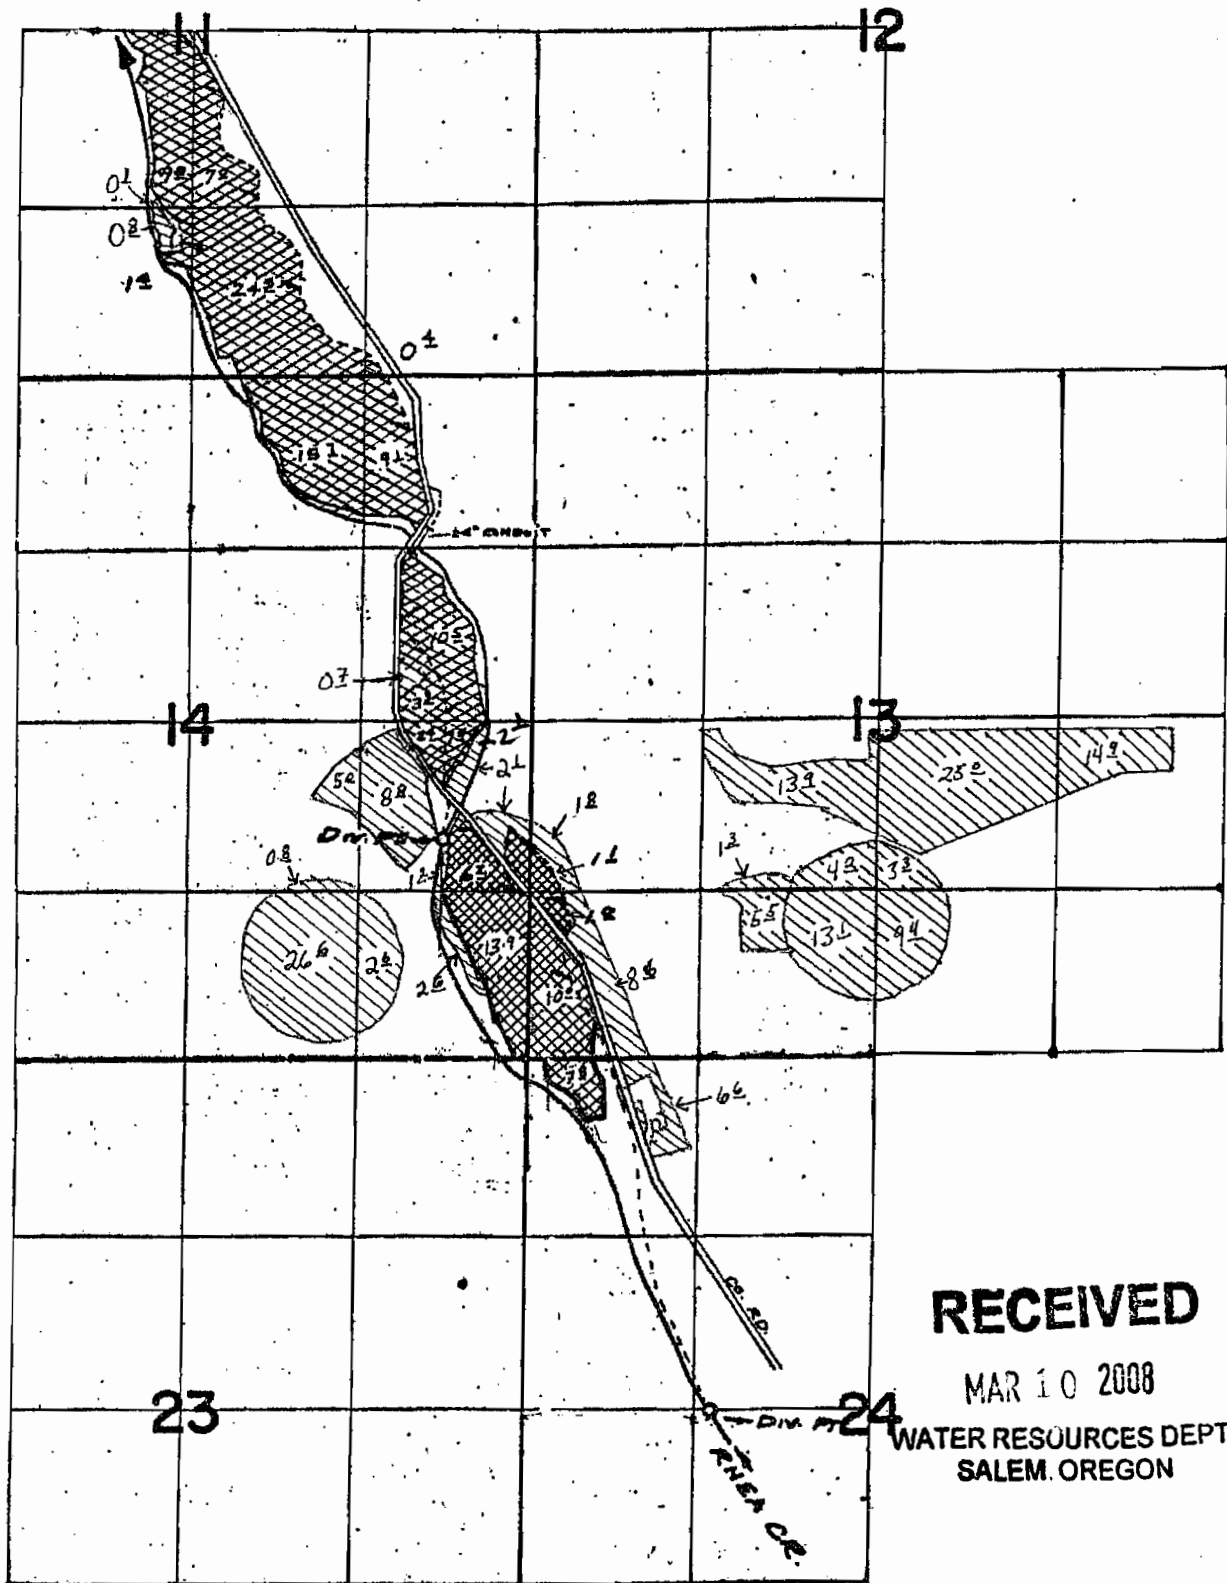

**RECEIVED**

MAR 10 2008

WATER RESOURCES DEPT  
SALEM, OREGON

Primary  Supplemental 

**RECEIVED**

DEC 03 2007


WATER RESOURCES DEPT  
SALEM, OREGON

MAP FOR APPLICATION PERMIT USE FOR GROUND WATER

HW and JF (Pachy) Buens.

App No G-1702163131 RIVER CREEK ROAD IONE OR

25 24

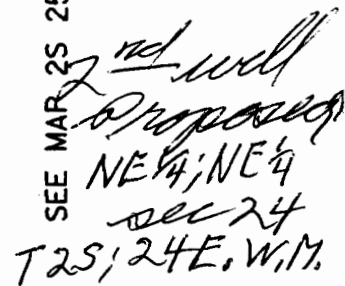

App No  
G-17021