


SECTION PLAT

Section 10 Township 23-S Range 33-E

County of Harney State of OR

NORTH

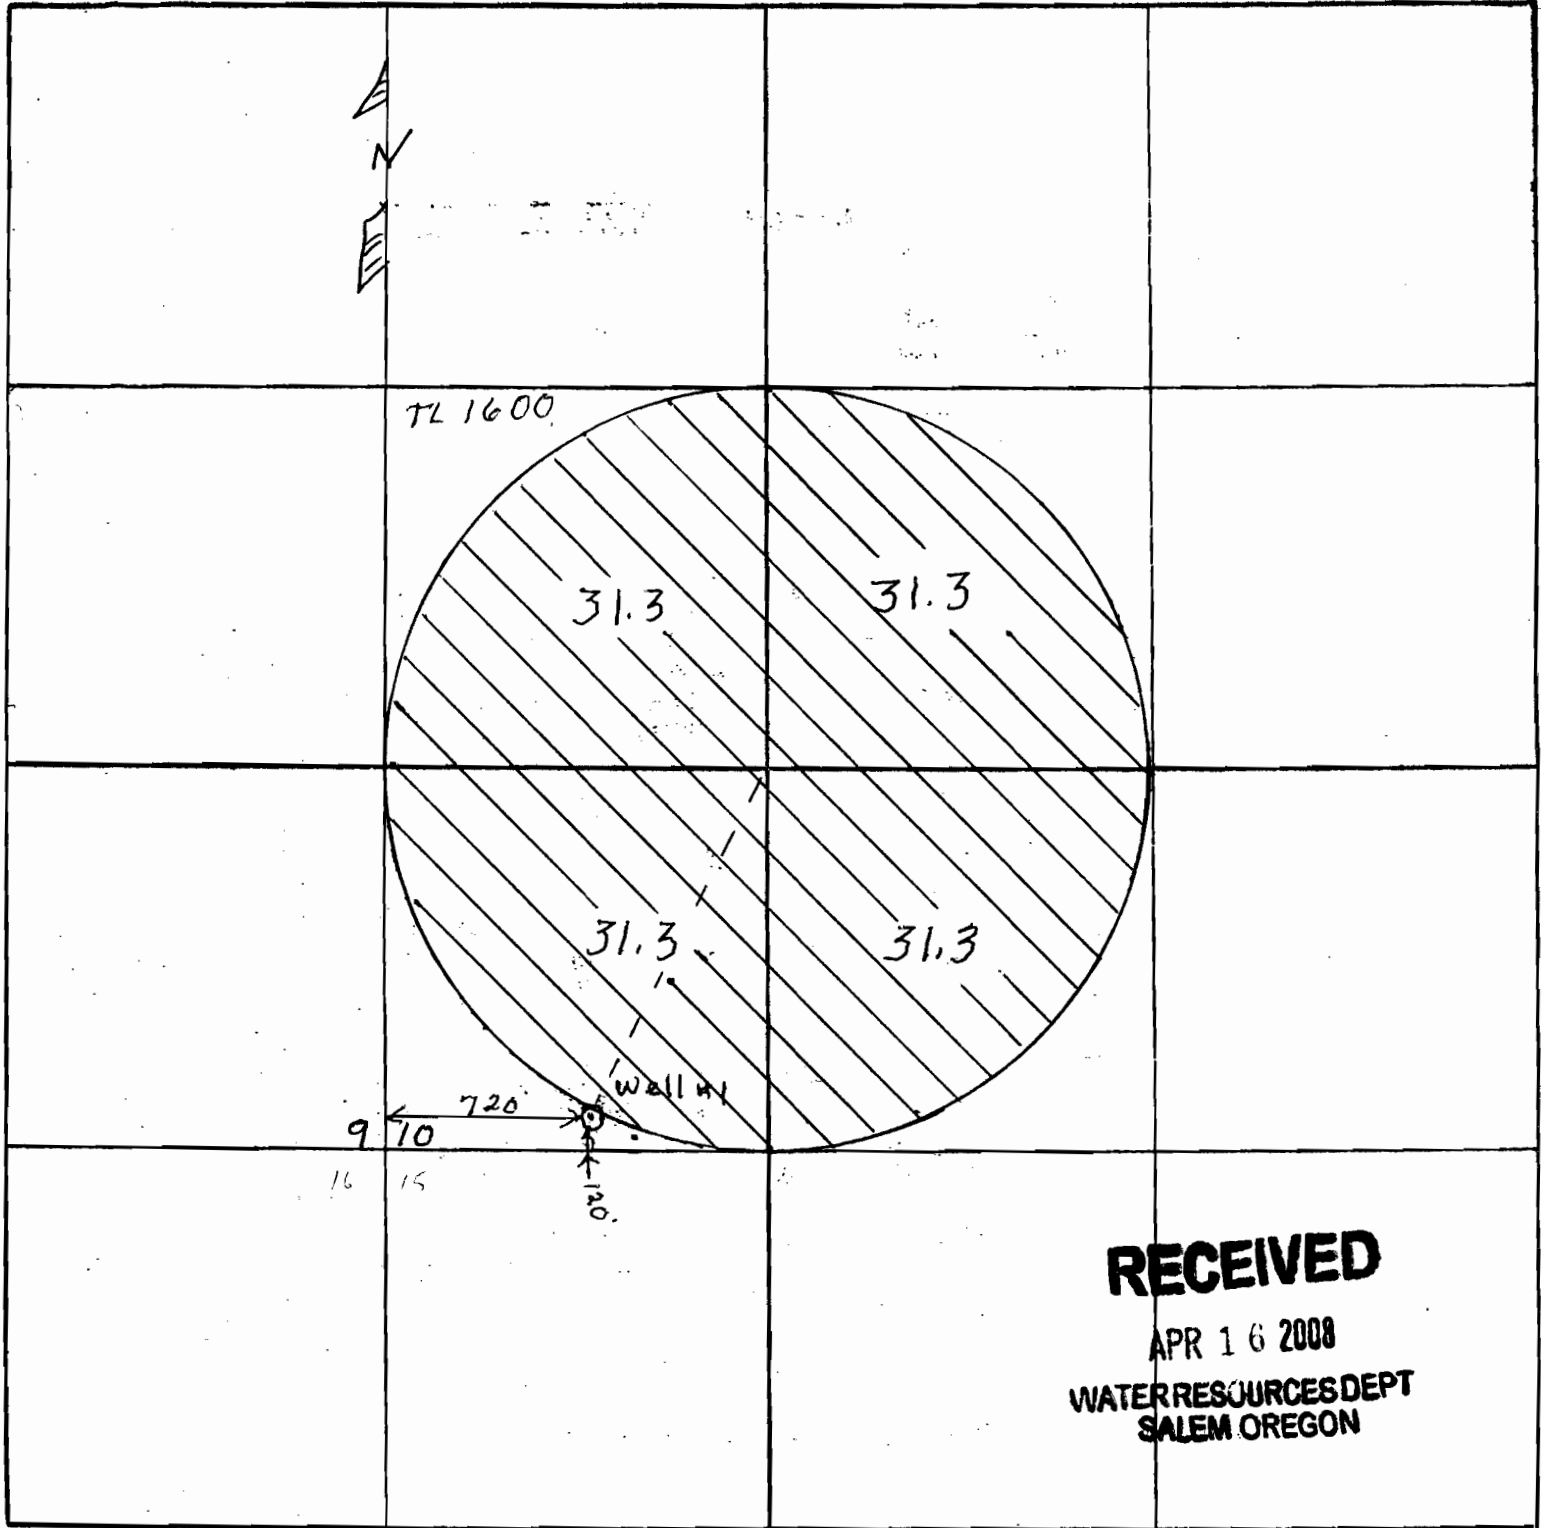

Remarks scale - 8" = 1 mile - 660' -

App No G-17041