

# Big Sarvice Corral Pond - Potter T 82S R 22E Section 36 Tax Lot 4100



0 337.5 675 1,350 Feet

1 inch equals 400 feet


Center of Reservoir: 1250 feet South and 1630 Feet West of the Northeast Corner of Section 36

( = POD: 955 feet North and 2575 feet West of the Northeast Corner of Section 36

— = Northeast Corner of Section 36



This product is for informational purposes and may not have been prepared for, or be suitable for legal, engineering, or surveying purposes. Users of this information should review or consult the primary data and information sources to ascertain the usability of the information.

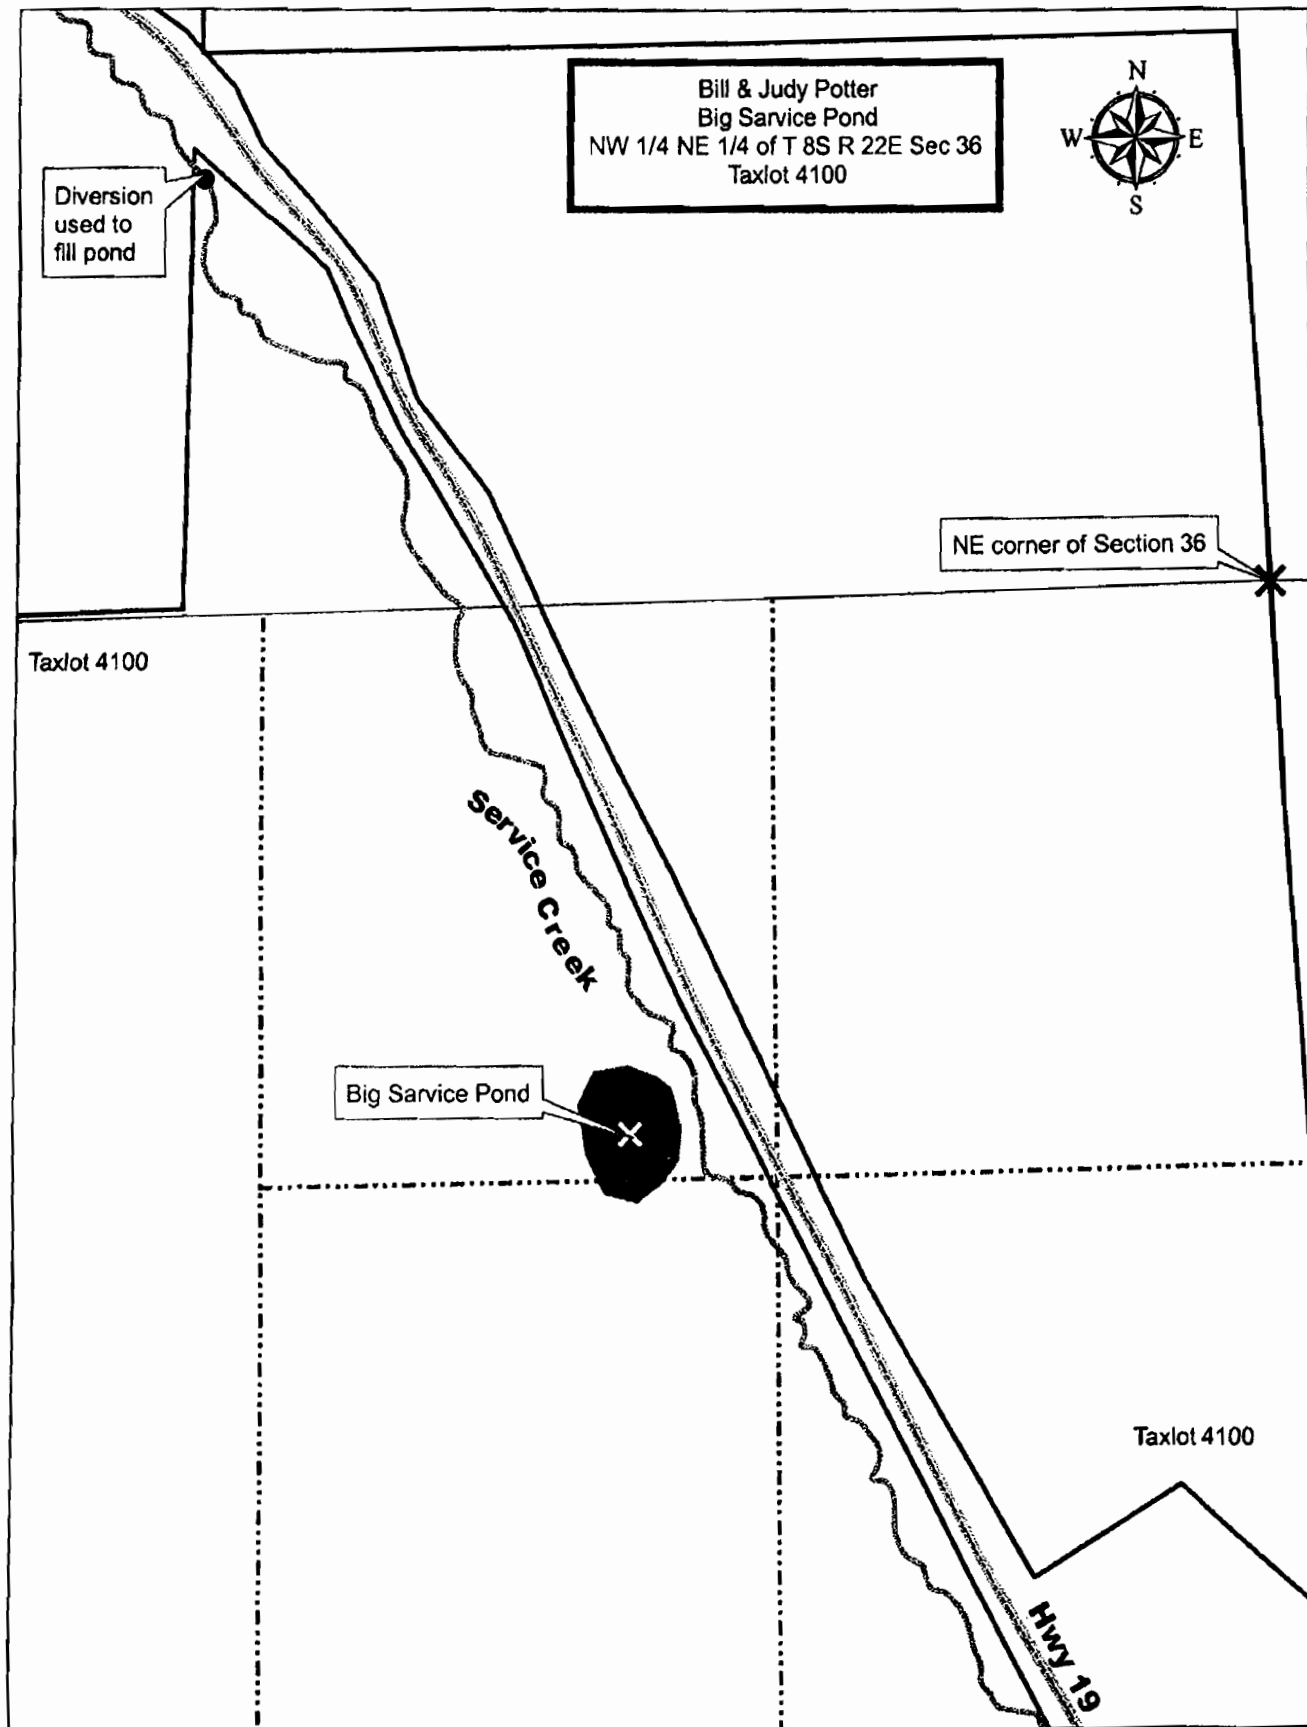

0 200 400 Feet

RECEIVED  
JUL 21 2008  
WATER RESOURCES DEPT.  
SALEM, OREGON

WHEEL

SEE MAP 7 22

WHEEL

CANCELLED NO'S

1101 2305

1501 2001

8 22

TL 1001

SECTION 1001  
1001  
1002  
SEC. 3  
INSERT  
1" = 400'

PART  
1001

SEE MAP 8 23

SEC. 8  
INSERT  
1" = 400'

TL 4000

TL 4000

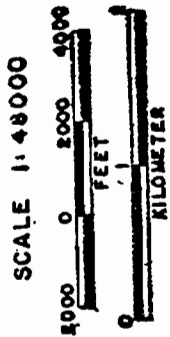

RECEIVED

JUL 21 2008

WATER RESOURCES DEPT.

SALEM, OREGON

