

This map was prepared for assessment purpose only.


CLACKAMAS COUNTY

JAMES SHIRLEY NO. 45

1" = 400'

Approx SCALE

1" = 600 Feet

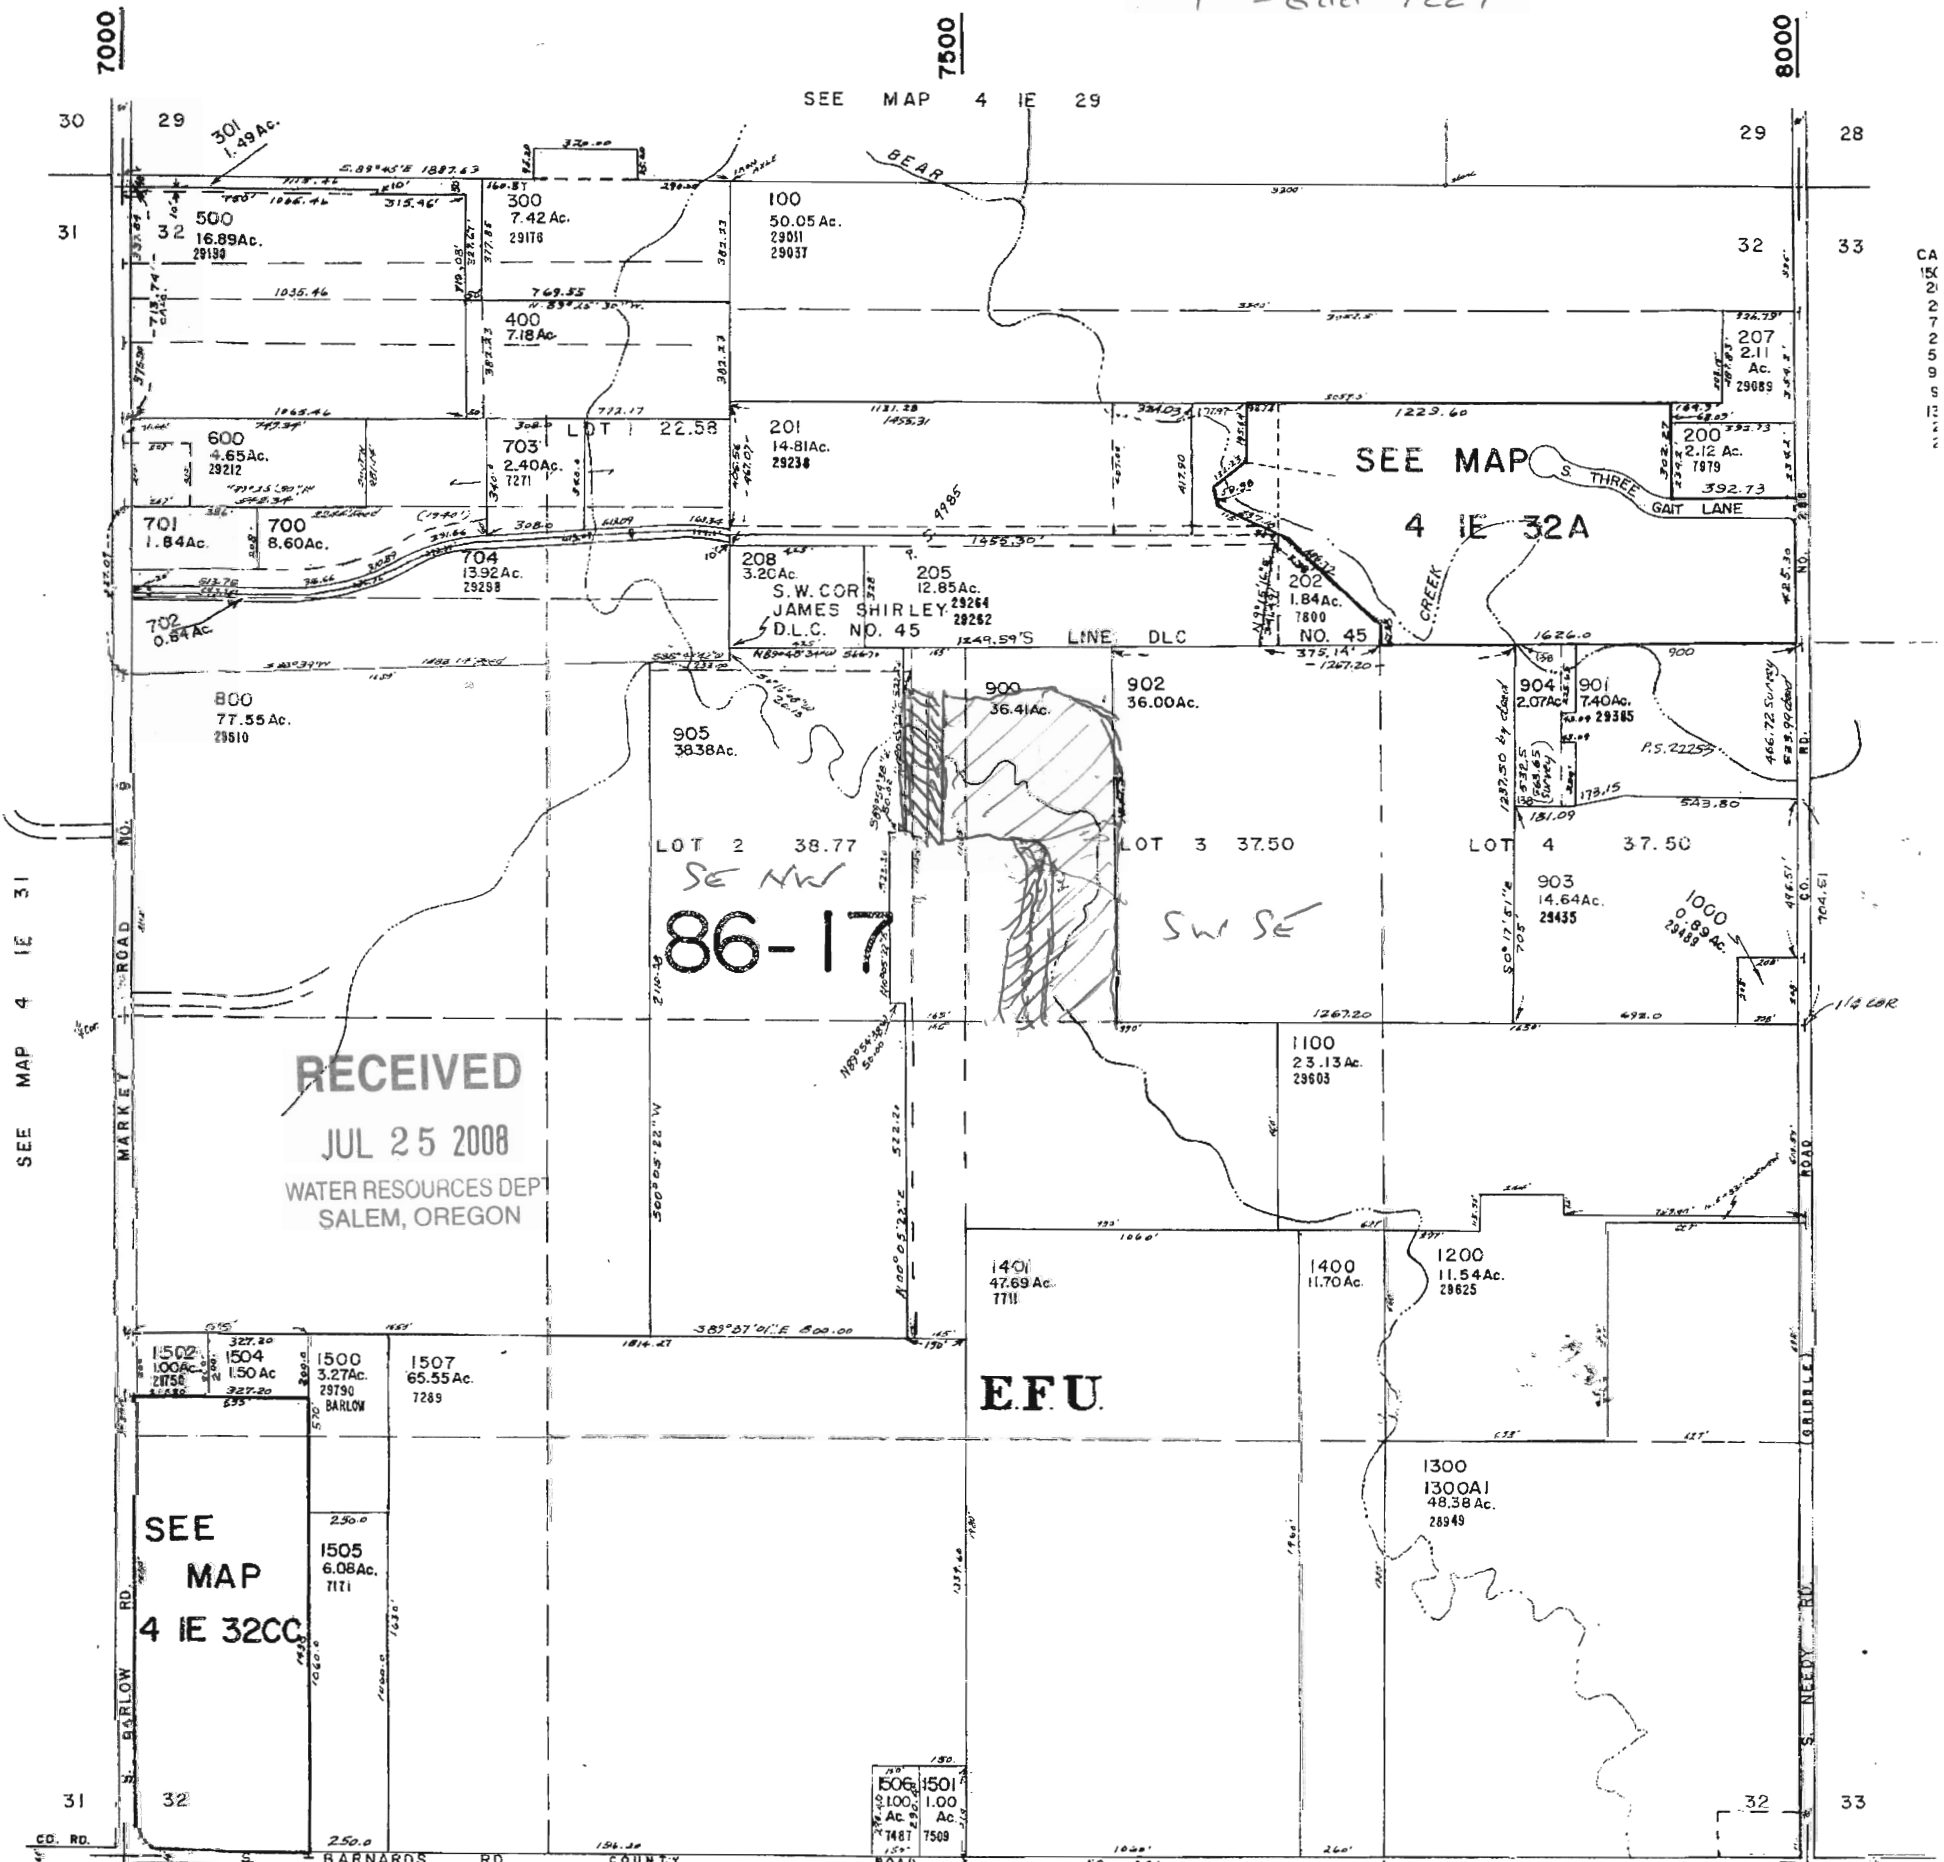


APR 7/25/08

CENTER OF RESERVOIR DAM LOCATED
 FROM NW CORNER SECTION 32
 2500 ft EAST
 2025 ft SOUTH

CA 15 2 2 7 2 5 9 5 1 1

Sec 32 T4S R1E WM App No
TL 900

A. Joel Neuschwander
6097 S. Wiliskey Hill
Hebbard, OR 97032
33 503-651-3253

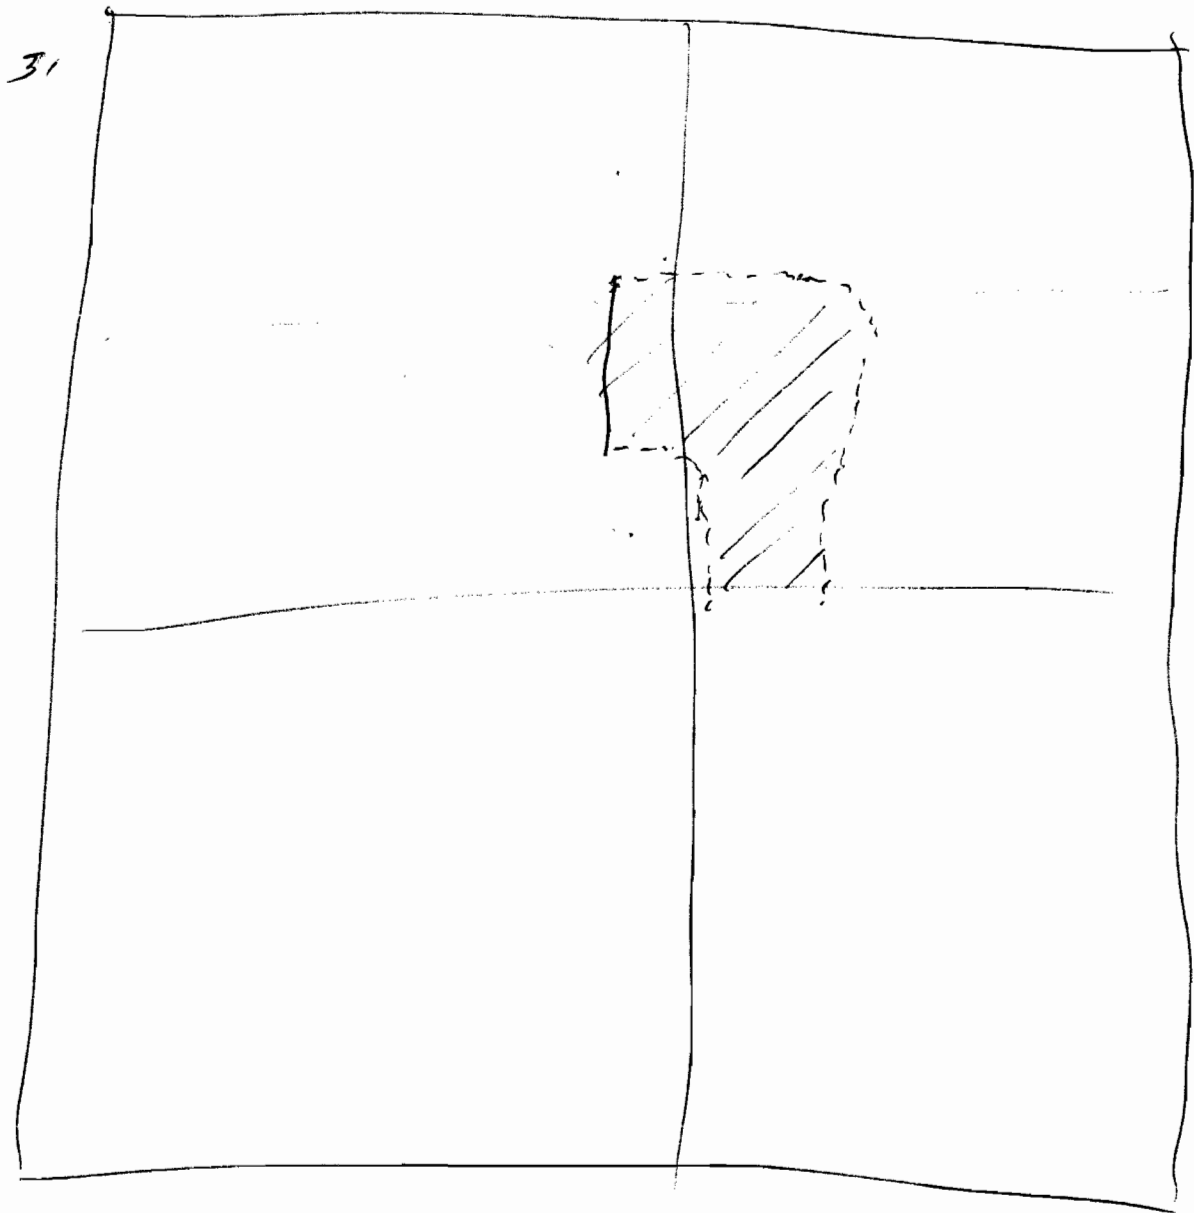

RECEIVED
JUL 25 2008
WATER RESOURCES DEPT
SALEM, OREGON

App No. R-87242

A. Joe / Neuschwander
6097 S. Whiskey Hill Rd
Hubbard, OR 97032
503-651-3253



RECEIVED

JUL 25 2008

WATER RESOURCES DEPT
SALEM, OREGON

