


LEGEND:

- DEMOTES MONUMENTS FOUND AS NOTED
- DEMOTES 5/8"X30" LONG IRON ROD WITH A YELLOW PLASTIC CAP STAMPED "ZTEC LS 1944" AND SET ON
- LR. DEMOTES IRON ROD
- LP. DEMOTES IRON PIPE, INSIDE DIAMETER
- TPC DEMOTES YELLOW PLASTIC CAP
- FD. DEMOTES FOUND
- (M) DEMOTES MEASURED
- SNF DEMOTES SEARCHED FOR NOT FOUND
- O.U. DEMOTES ORIGIN UNKNOWN
- SQ. FT. DEMOTES SQUARE FEET
- S.N. DEMOTES SURVEY NUMBER, CLACKAMAS COUNTY SURVEY RECORDS

- SN(1) SN 3094
- SN(2) SN 29090
- SN(3) SN 20812
- SN(4) SN 24792
- SN(5) SN 35372
- S-137 COUNTY ROAD SURVEY OF LYONS ROAD
- T.S.P. DEMOTES TIED STRAIGHT PORTION
- DEED (1) DOCUMENT NO. 82-10918
- DEED (2) DOCUMENT NO. 94-063652
- DEED (3) DOCUMENT NO. 2000-070000
- DEED (4) BOOK 5, PAGE 306
- DEED (5) DOCUMENT NO. 2002-036877
- DEED (6) DOCUMENT NO. 2003-099670
- DEED (7)

- △ = 281°53' R = 400.40' L = 163.08' CH = N 76°28'4" E 181.48'
- △ = 253°30' R = 409.26' L = 183.88' CH = N 76°43'5" W 181.75'
- △ = 281°53' R = 380.40' L = 173.93' CH = N 76°28'4" E 172.42'
- △ = 253°30' R = 428.26' L = 192.23' CH = N 76°43'5" E 190.83'
- △ = 0°19'34" R = 802.86' L = 323.90' CH = S 50°14'4" E 12.38'
- △ = 180°28' R = 802.96' L = 329.08' CH = S 86°22'13" E 208.10'
- △ = 0°19'34" R = 1879.85' L = 313.88' CH = N 44°32'26" W 313.31'
- △ = 201°70' R = 542.98' L = 192.21' CH = N 58°47'38" W 191.21'

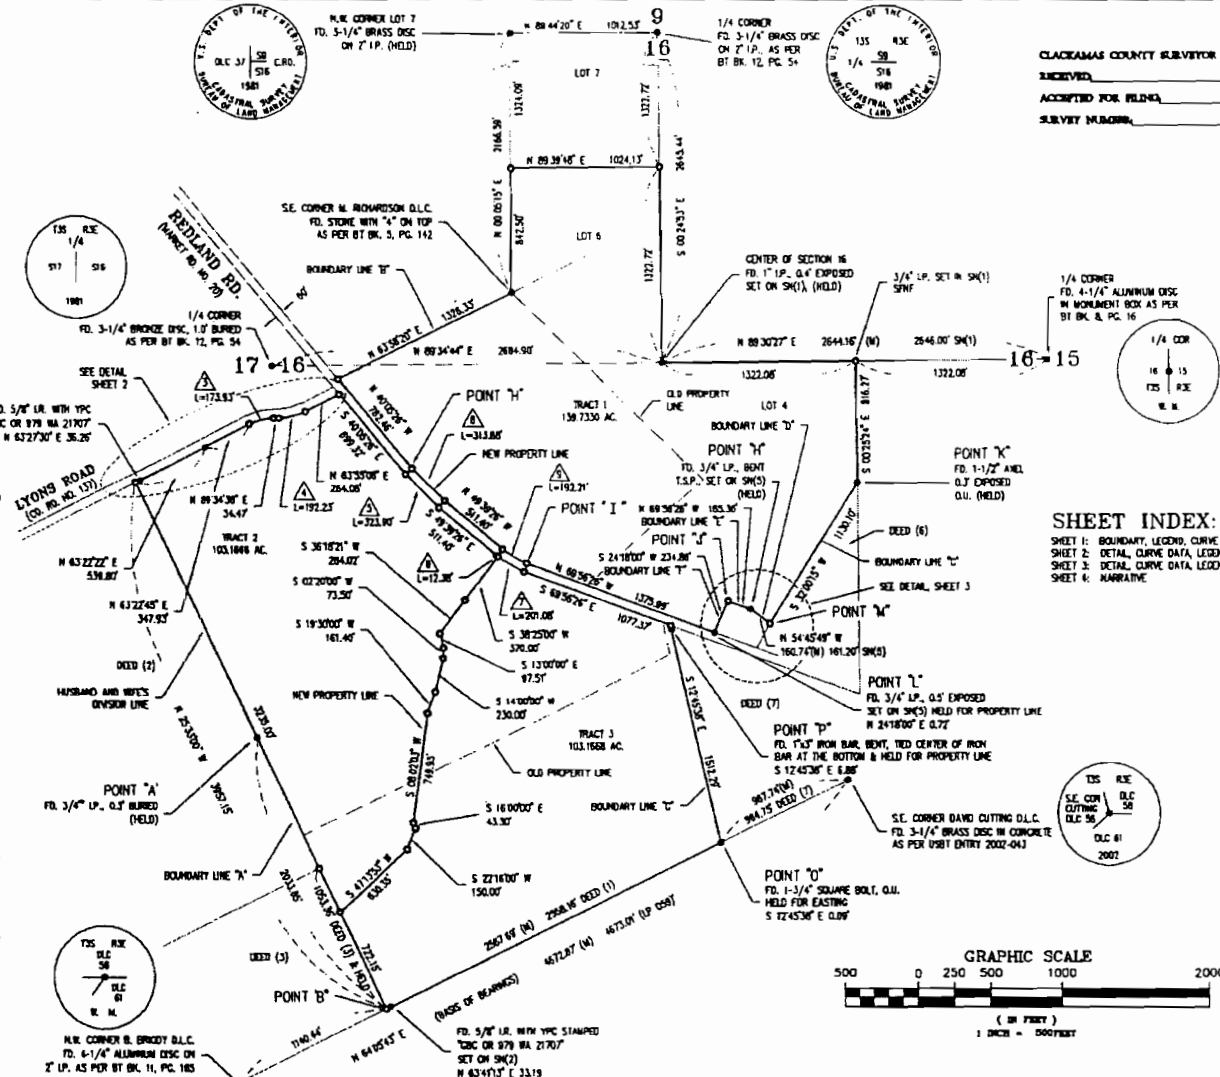

CLACKAMAS COUNTY SURVEYOR
 RECEIVED
 ACCEPTED FOR FILING
 SURVEY NUMBER

SHEET INDEX:
 SHEET 1: BOUNDARY, LEGEND, CURVE DATA
 SHEET 2: DETAIL, CURVE DATA, LEGEND
 SHEET 3: DETAIL, CURVE DATA, LEGEND
 SHEET 4: NARRATIVE

SHEET 1 OF 4

JOB#: P3451-1
 DATE: 4-13-07
 SCALE: 1"=500'
 DRAWN: JMH
 CHECK: CCF
 FILE: P3451180
 PLOT: 5-15-07

ZTEC ENGINEERS INC.
 3737 S.E. 8TH AVE., PORTLAND, OREGON 97202
 PH: (503) 235-8795 FAX: (503) 233-7889
 LOCATED IN THE N.E. 1/4, S.E. 1/4, S.W. 1/4, & N.W. 1/4 OF SECTION 16,
 IN THE S.E. 1/4 OF SECTION 17, IN THE N.E. 1/4 OF SECTION 20,
 AND IN THE N.W. 1/4 OF SECTION 21, ALL IN T.35., R.3E.,
 W.M., CLACKAMAS COUNTY, OREGON

REGISTERED
 PROFESSIONAL
 LAND SURVEYOR

OREGON
 JULY 17, 1981
 CHRIS FISCHBORN
 1944
 EXPIRATION DATE 1/1/2008

GENE WOLF

PROPERTY LINE ADJUSTMENT