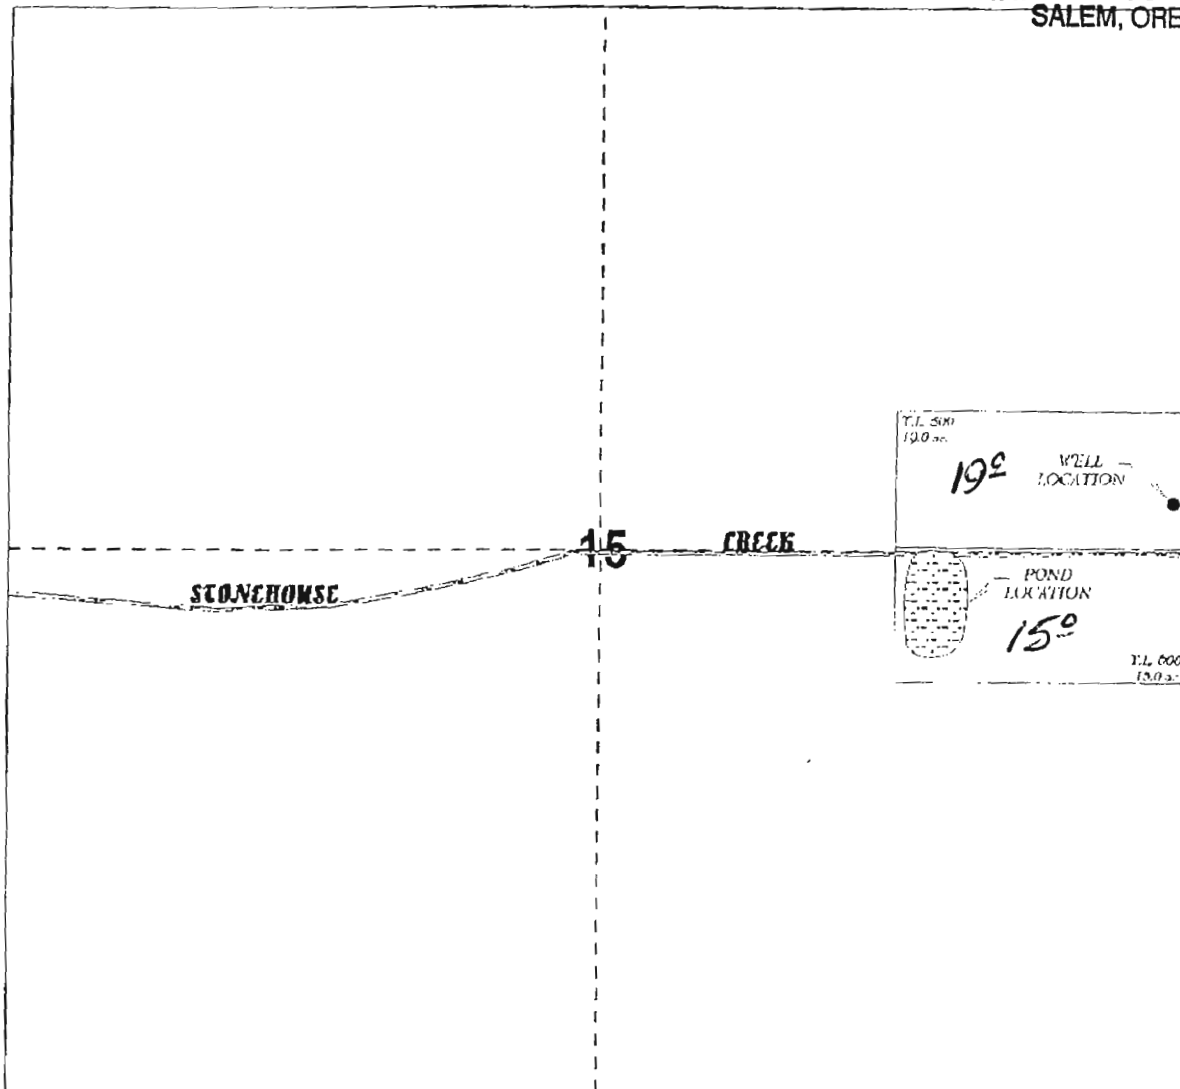


T. 35 S., R. 33 E., W.M.
SEC. 15

RECEIVED

OCT 06 2008

WATER RESOURCES DEPT
SALEM, OREGON

POINT OF ORIGIN: CENTER 1/4 COR., SEC 15

WELL LOCATION: 240' N. & 2500' E.

POND LOCATION: 20' S. & 1400' E.

AmendedMAP TO ACCOMPANY
APPLICATIONS IN THE
NAME OF:

GEORGE R. STROEMPLE

GEORGE R. STROEMPLE:**APPLICATION TO STORE WATER (R-87245)
IN A RESERVOIR / G-17089 / S-87246**

SCALE: 1" = 880'


DATE: MAP REVISED 09/20/08

PAGE: 1 of 1

MISC.: APP. # R 87245
STONEHOUSE POND

BY: J. WITZEL

T.35S, R.33E, W.M.

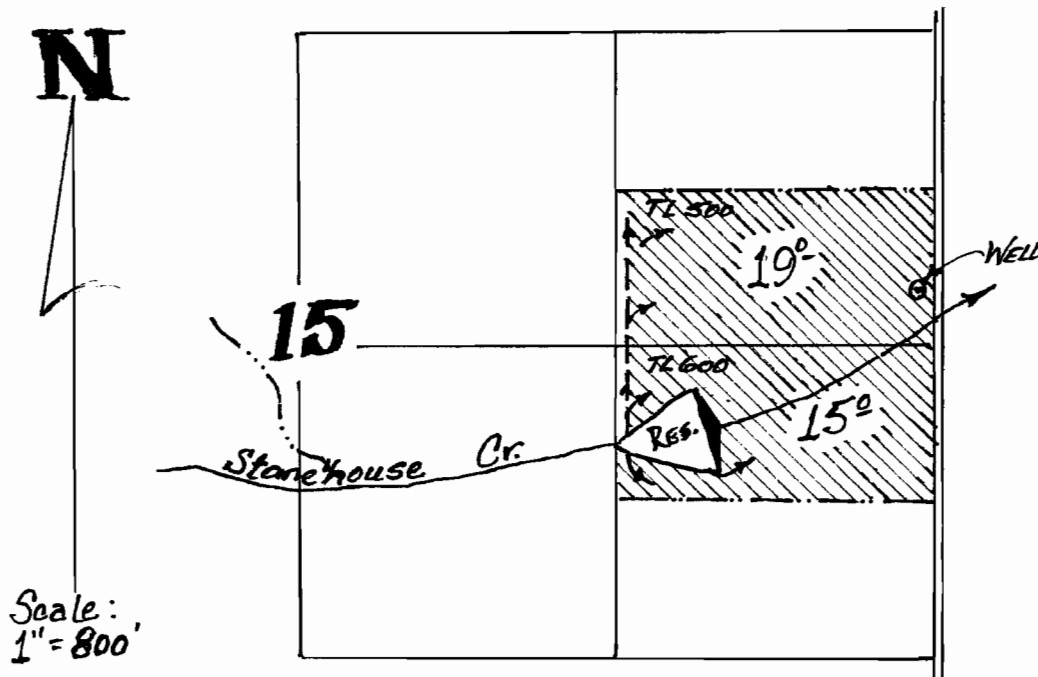

Reservoir Location: 340' S. & 1720' E.;

Well Location: 240' N. & 2560' E.;

- both from the Center 1/4 Cor., Sec. 15.

**Map to Accompany Applications
in the Name of
George Stroemple**

RECEIVED

JUL 31 2008

WATER RESOURCES DEPT
SALEM, OREGON

05/08 *SP*