
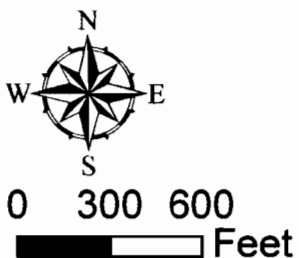


Map 12633, Taxlot 410
Northeast Quarter of the Northeast Quarter of Section 33,
Township 12 South, Range 6 West, Willamette Meridian

Benton County, Oregon

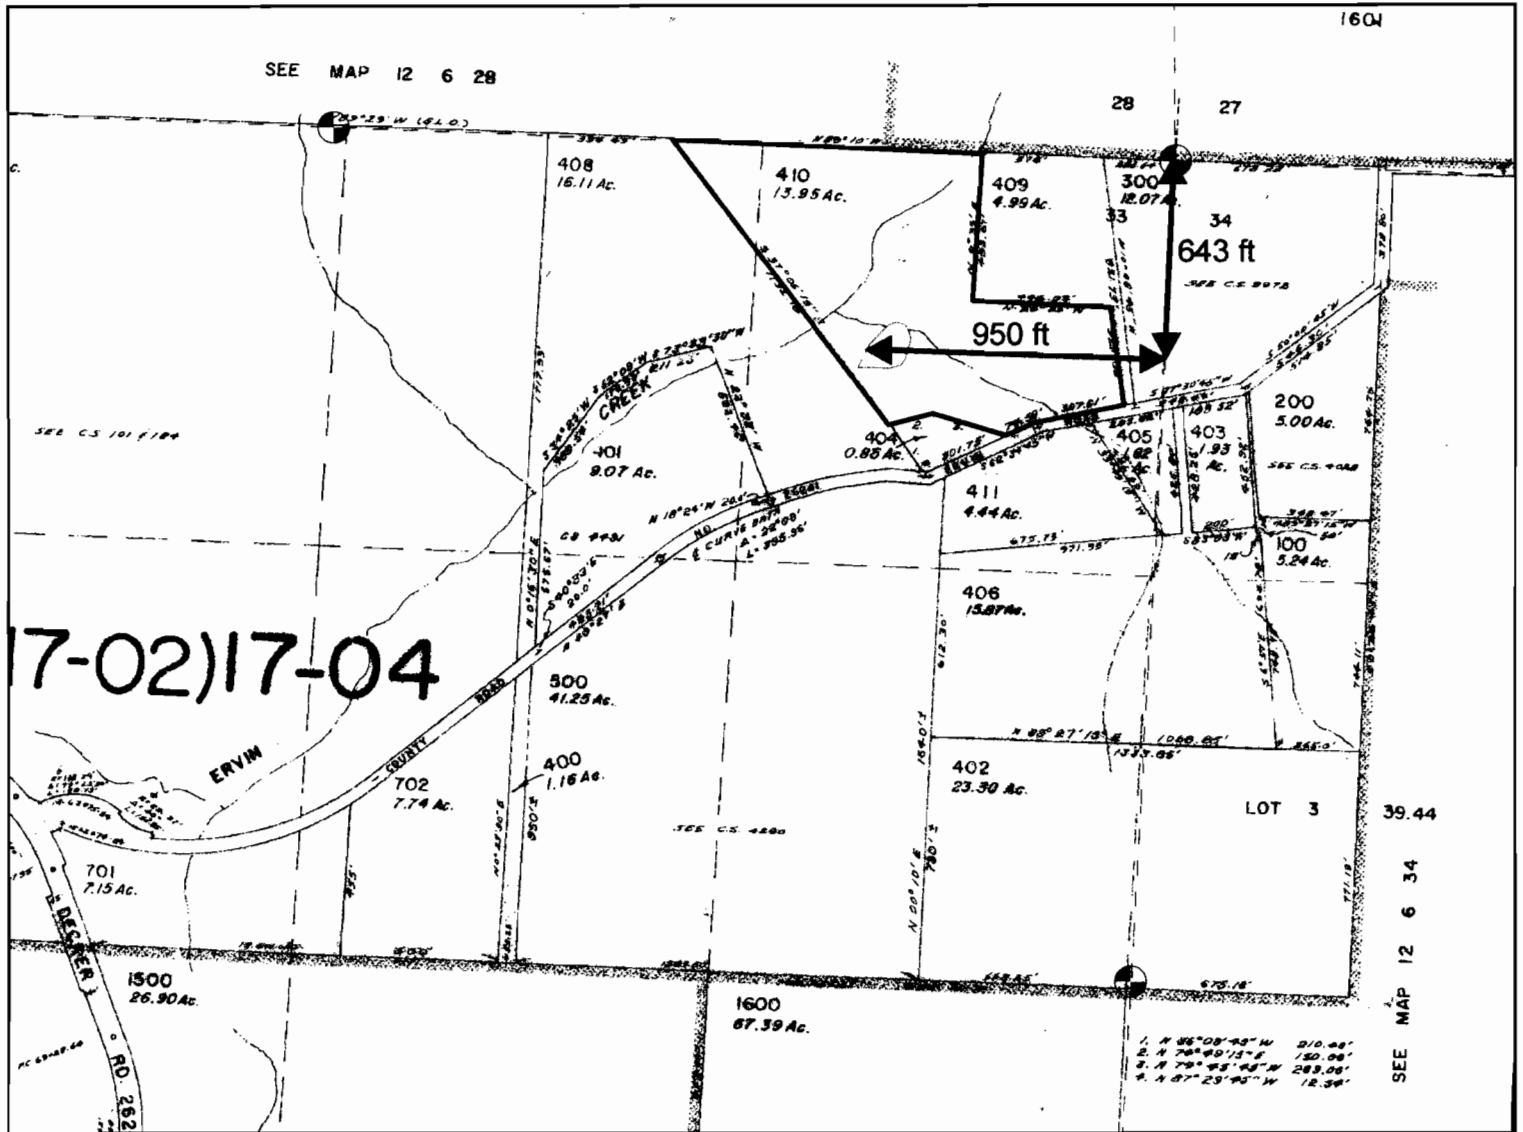

(1 inch = 600 feet)

Alba, David & Deborah

RECEIVED
 JUN 31 2008
 WATER RESOURCES DEPT.
 SALEM, OREGON

This product is for informational purposes and may not have been prepared for, or be suitable for legal, engineering, or surveying purposes.

Users of this information should review or consult the primary data and information sources to ascertain the usability of the information.