




THIS MAP WAS PREPARED FOR
ASSESSMENT PURPOSE ONLY

SECTION 30 T.2S. R.10W. W.M.
TILLAMOOK COUNTY

1"=400'

2S 10 30

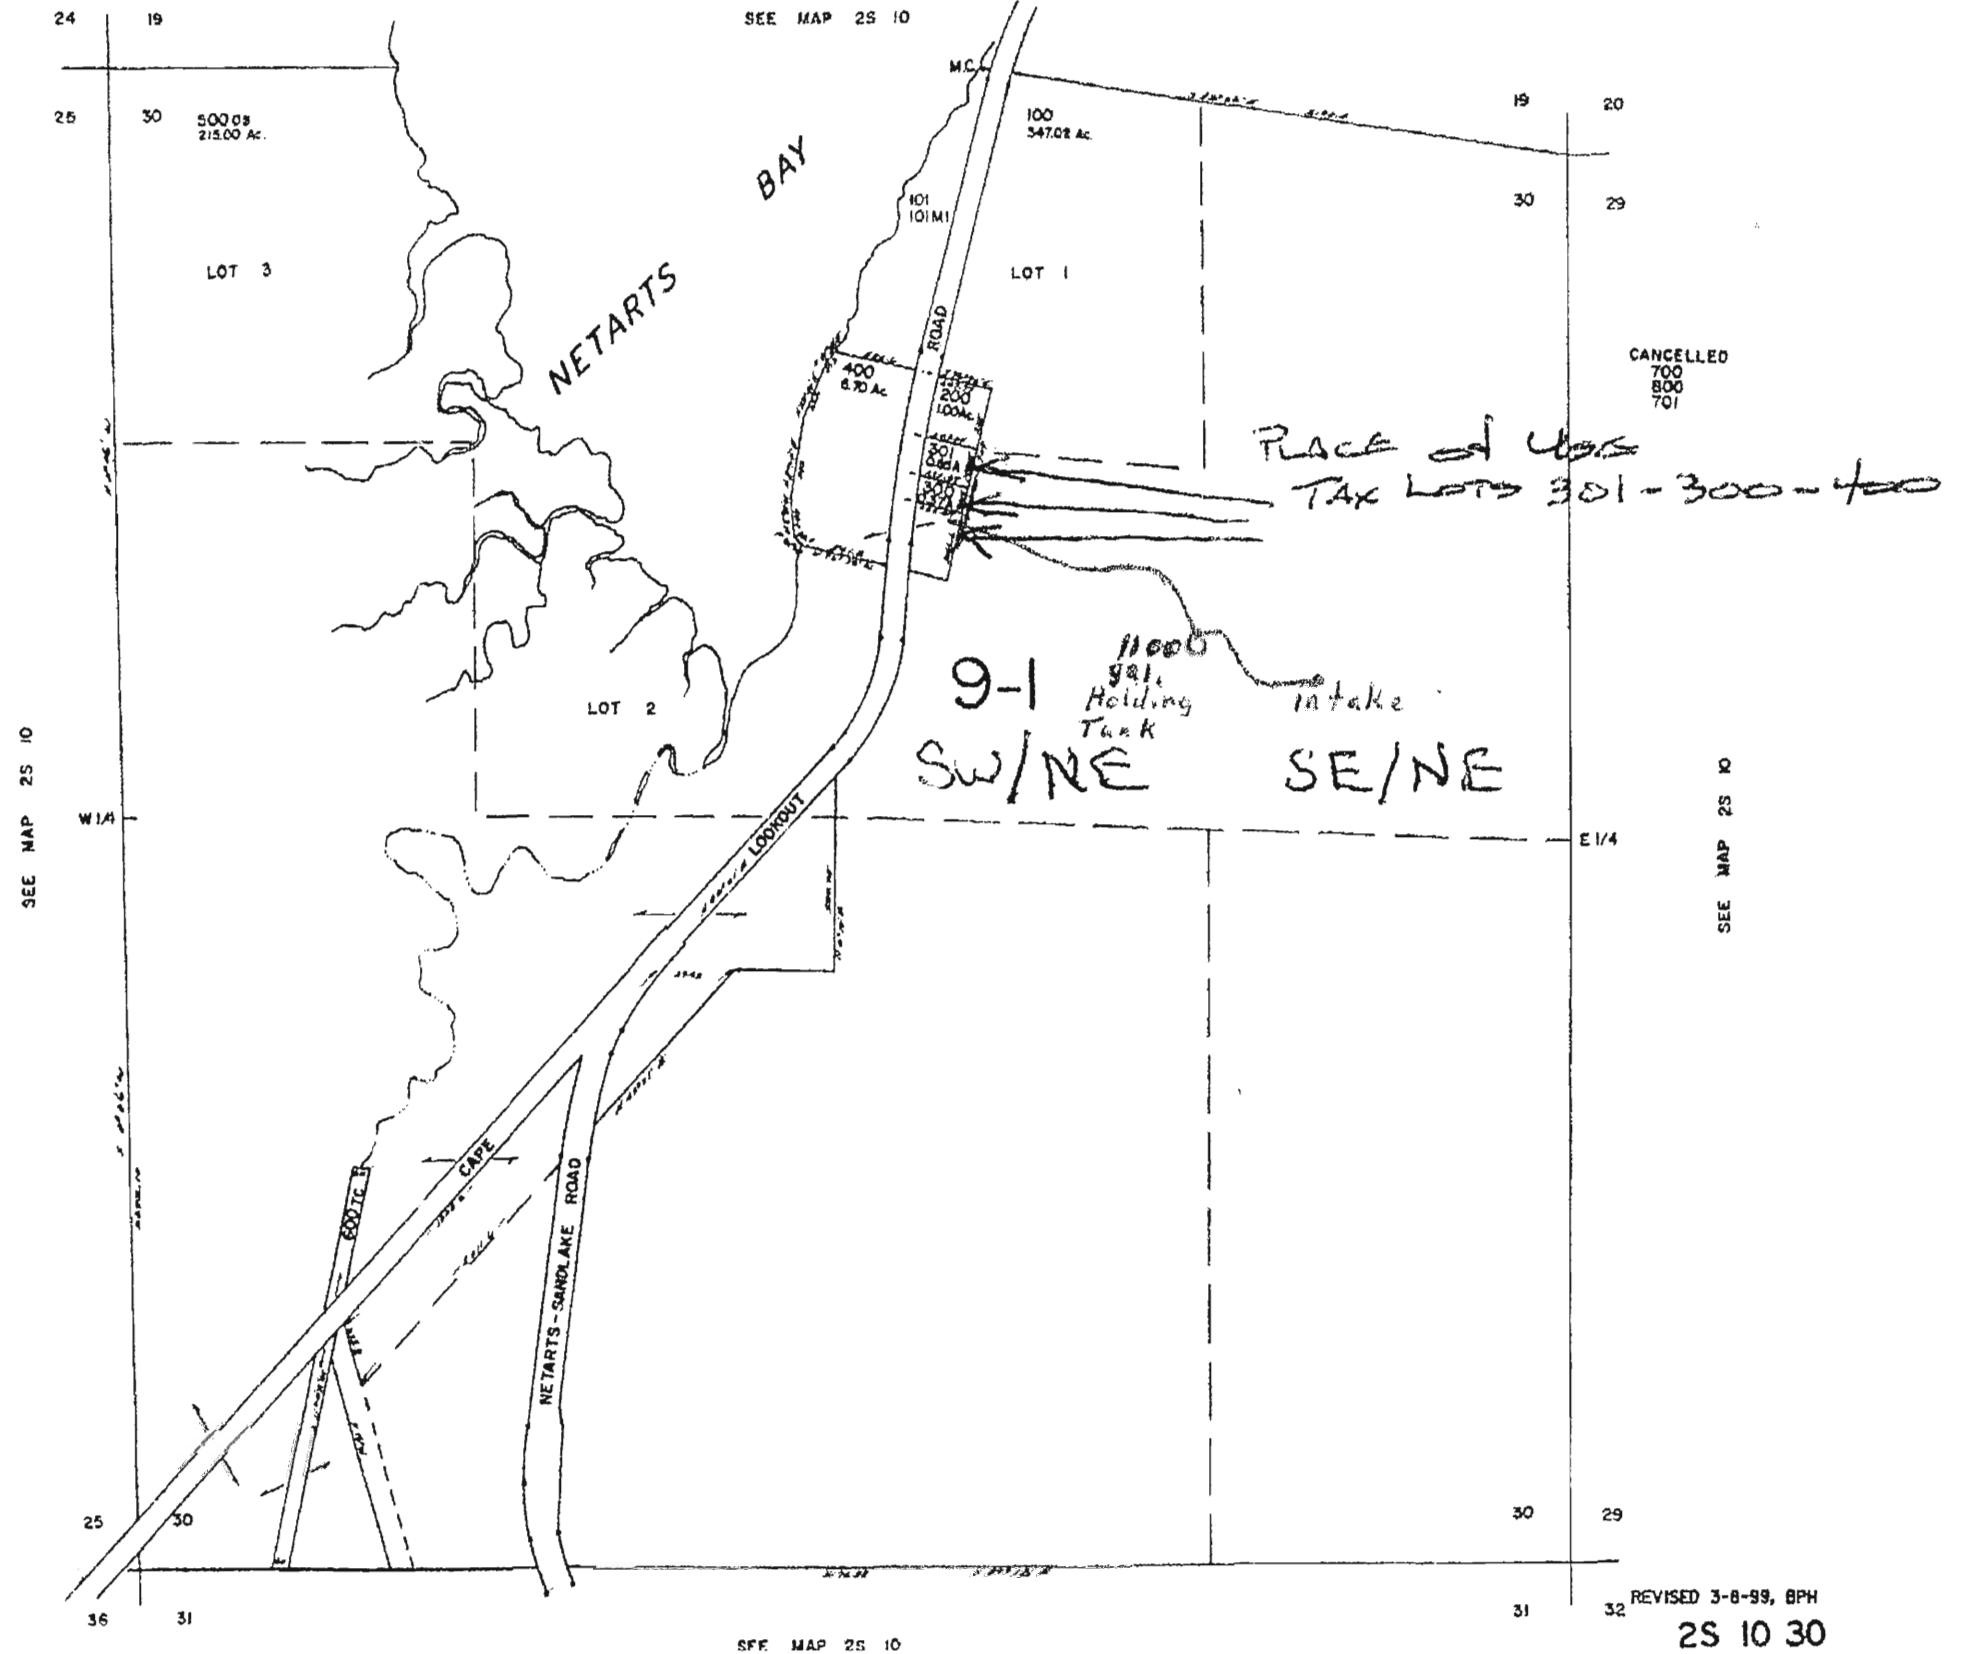


SECTION 30 T.2S. R.10W. W.M.
TILLAMOOK COUNTY

2S 10 30

APPROX CORRECTED
ADJUSTED SCALE
1" = 600 FEET

SEE MAP 2S 10

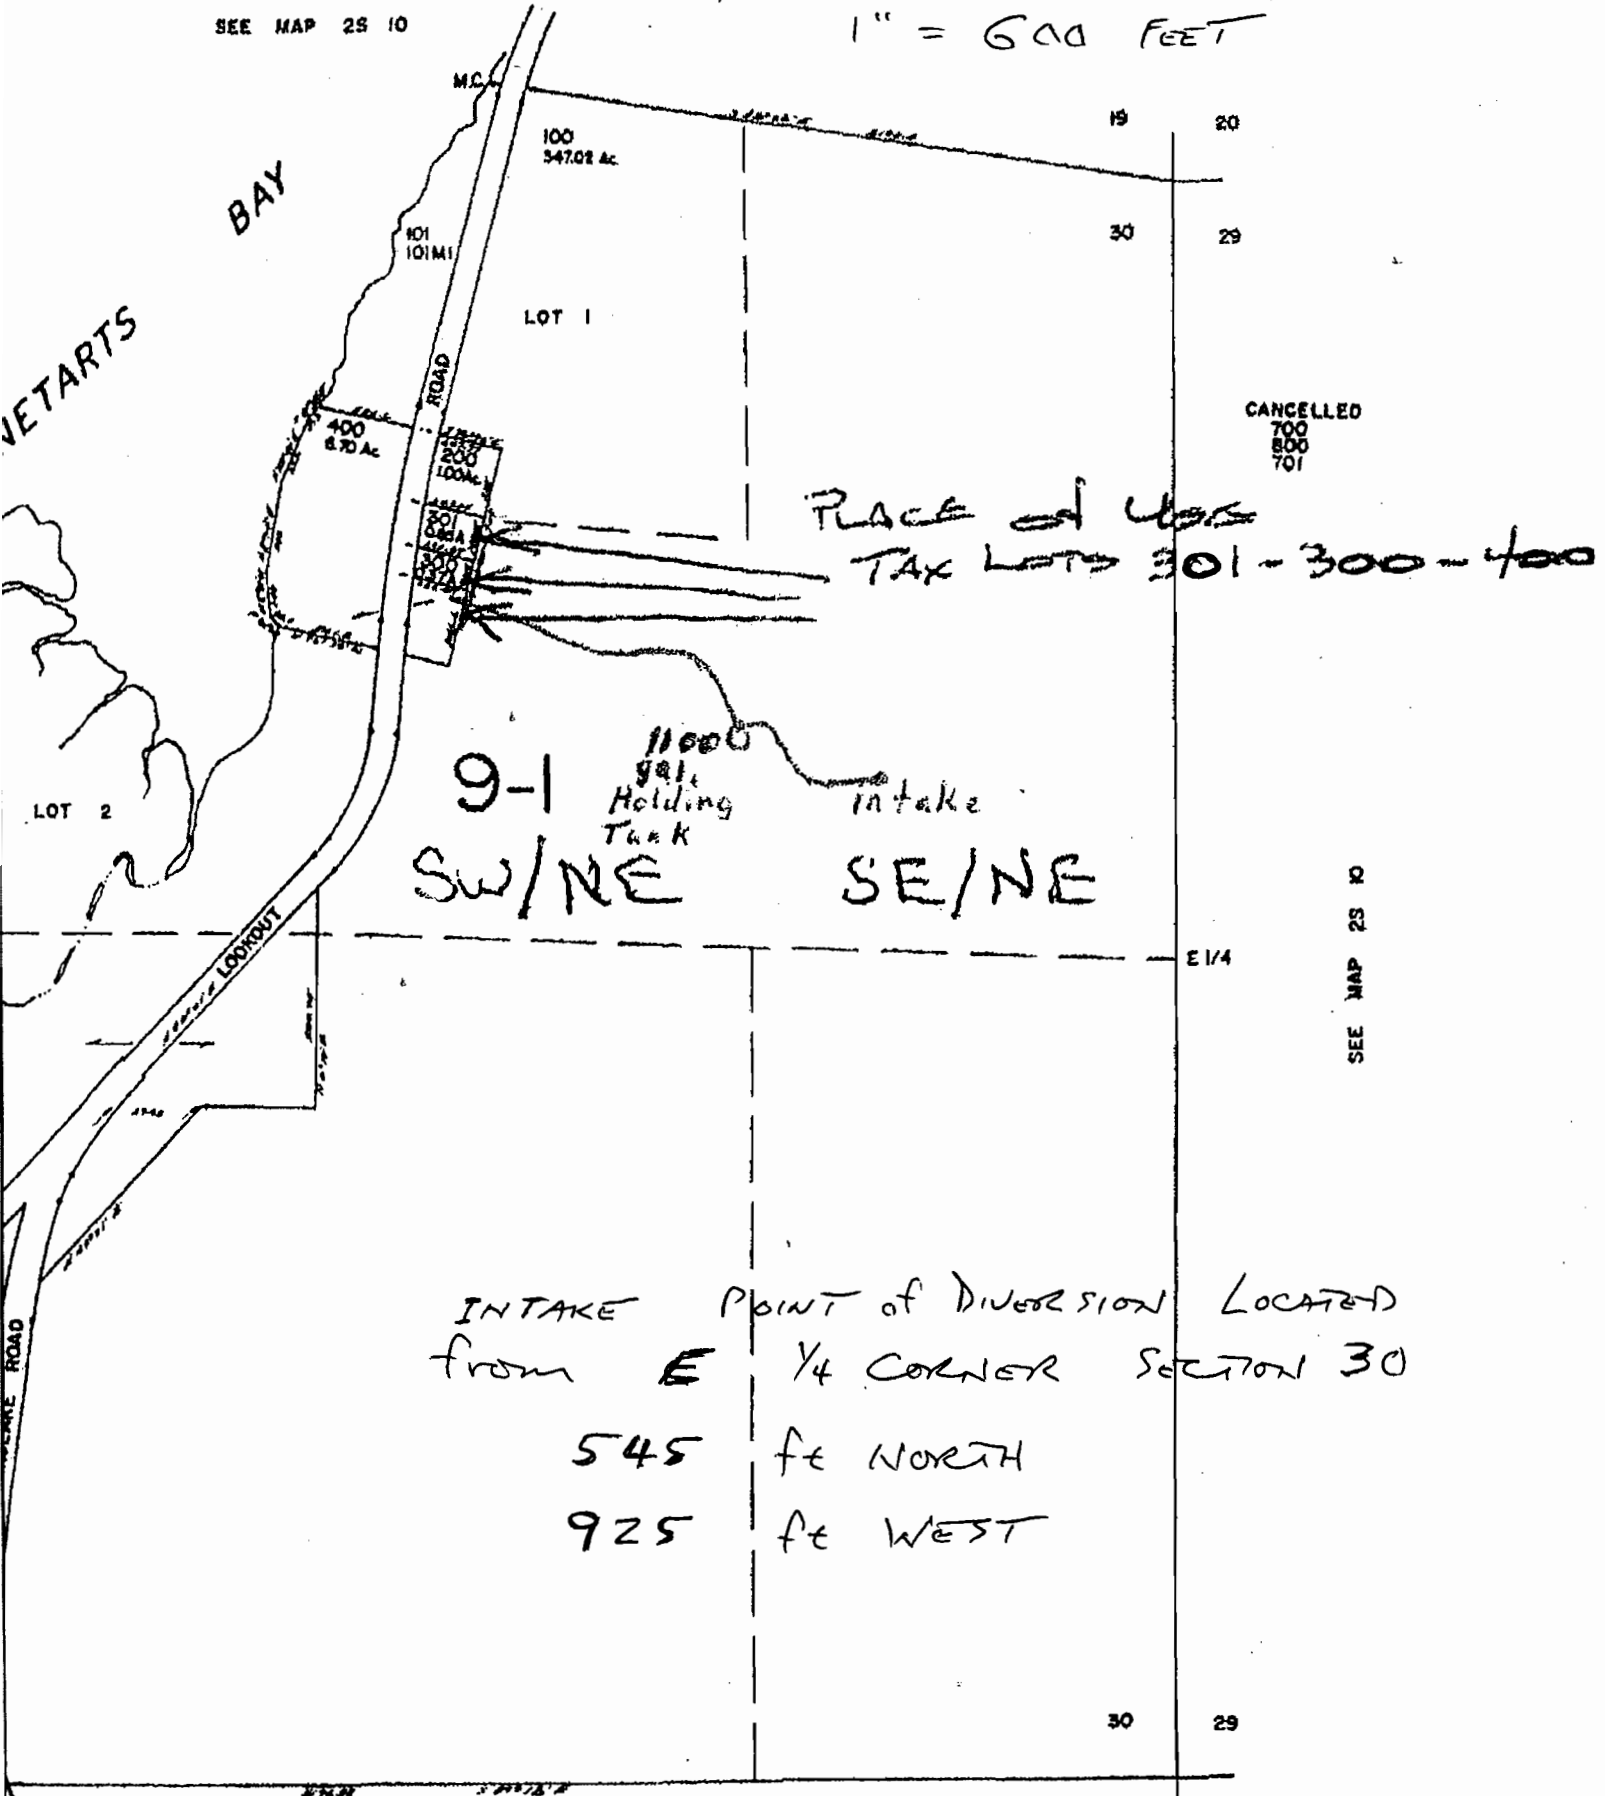

INTAKE POINT of DIVERSION LOCATED
from E 1/4 CORNER SECTION 30
545 ft NORTH
925 ft WEST

SEE MAP 2S 10

RECEIVED
AUG 06 2008
WATER RESOURCES DEPT.
SALEM, OREGON



THIS MAP WAS PREPARED FOR
ASSESSMENT PURPOSE ONLY

SECTION 30 T.2S. R.10W. W.M.
TILLAMOOK COUNTY

1"=400'

25 10 30

