


WILLIAMSON RESERVOIR
T12S R20E SECTION 15 TAX LOT 1701

T.12S. R.20E. W.M. WHEELER COUNTY

RECEIVED
AUG 06 2008
WATER RESOURCES DEPT.
SALEM, OREGON

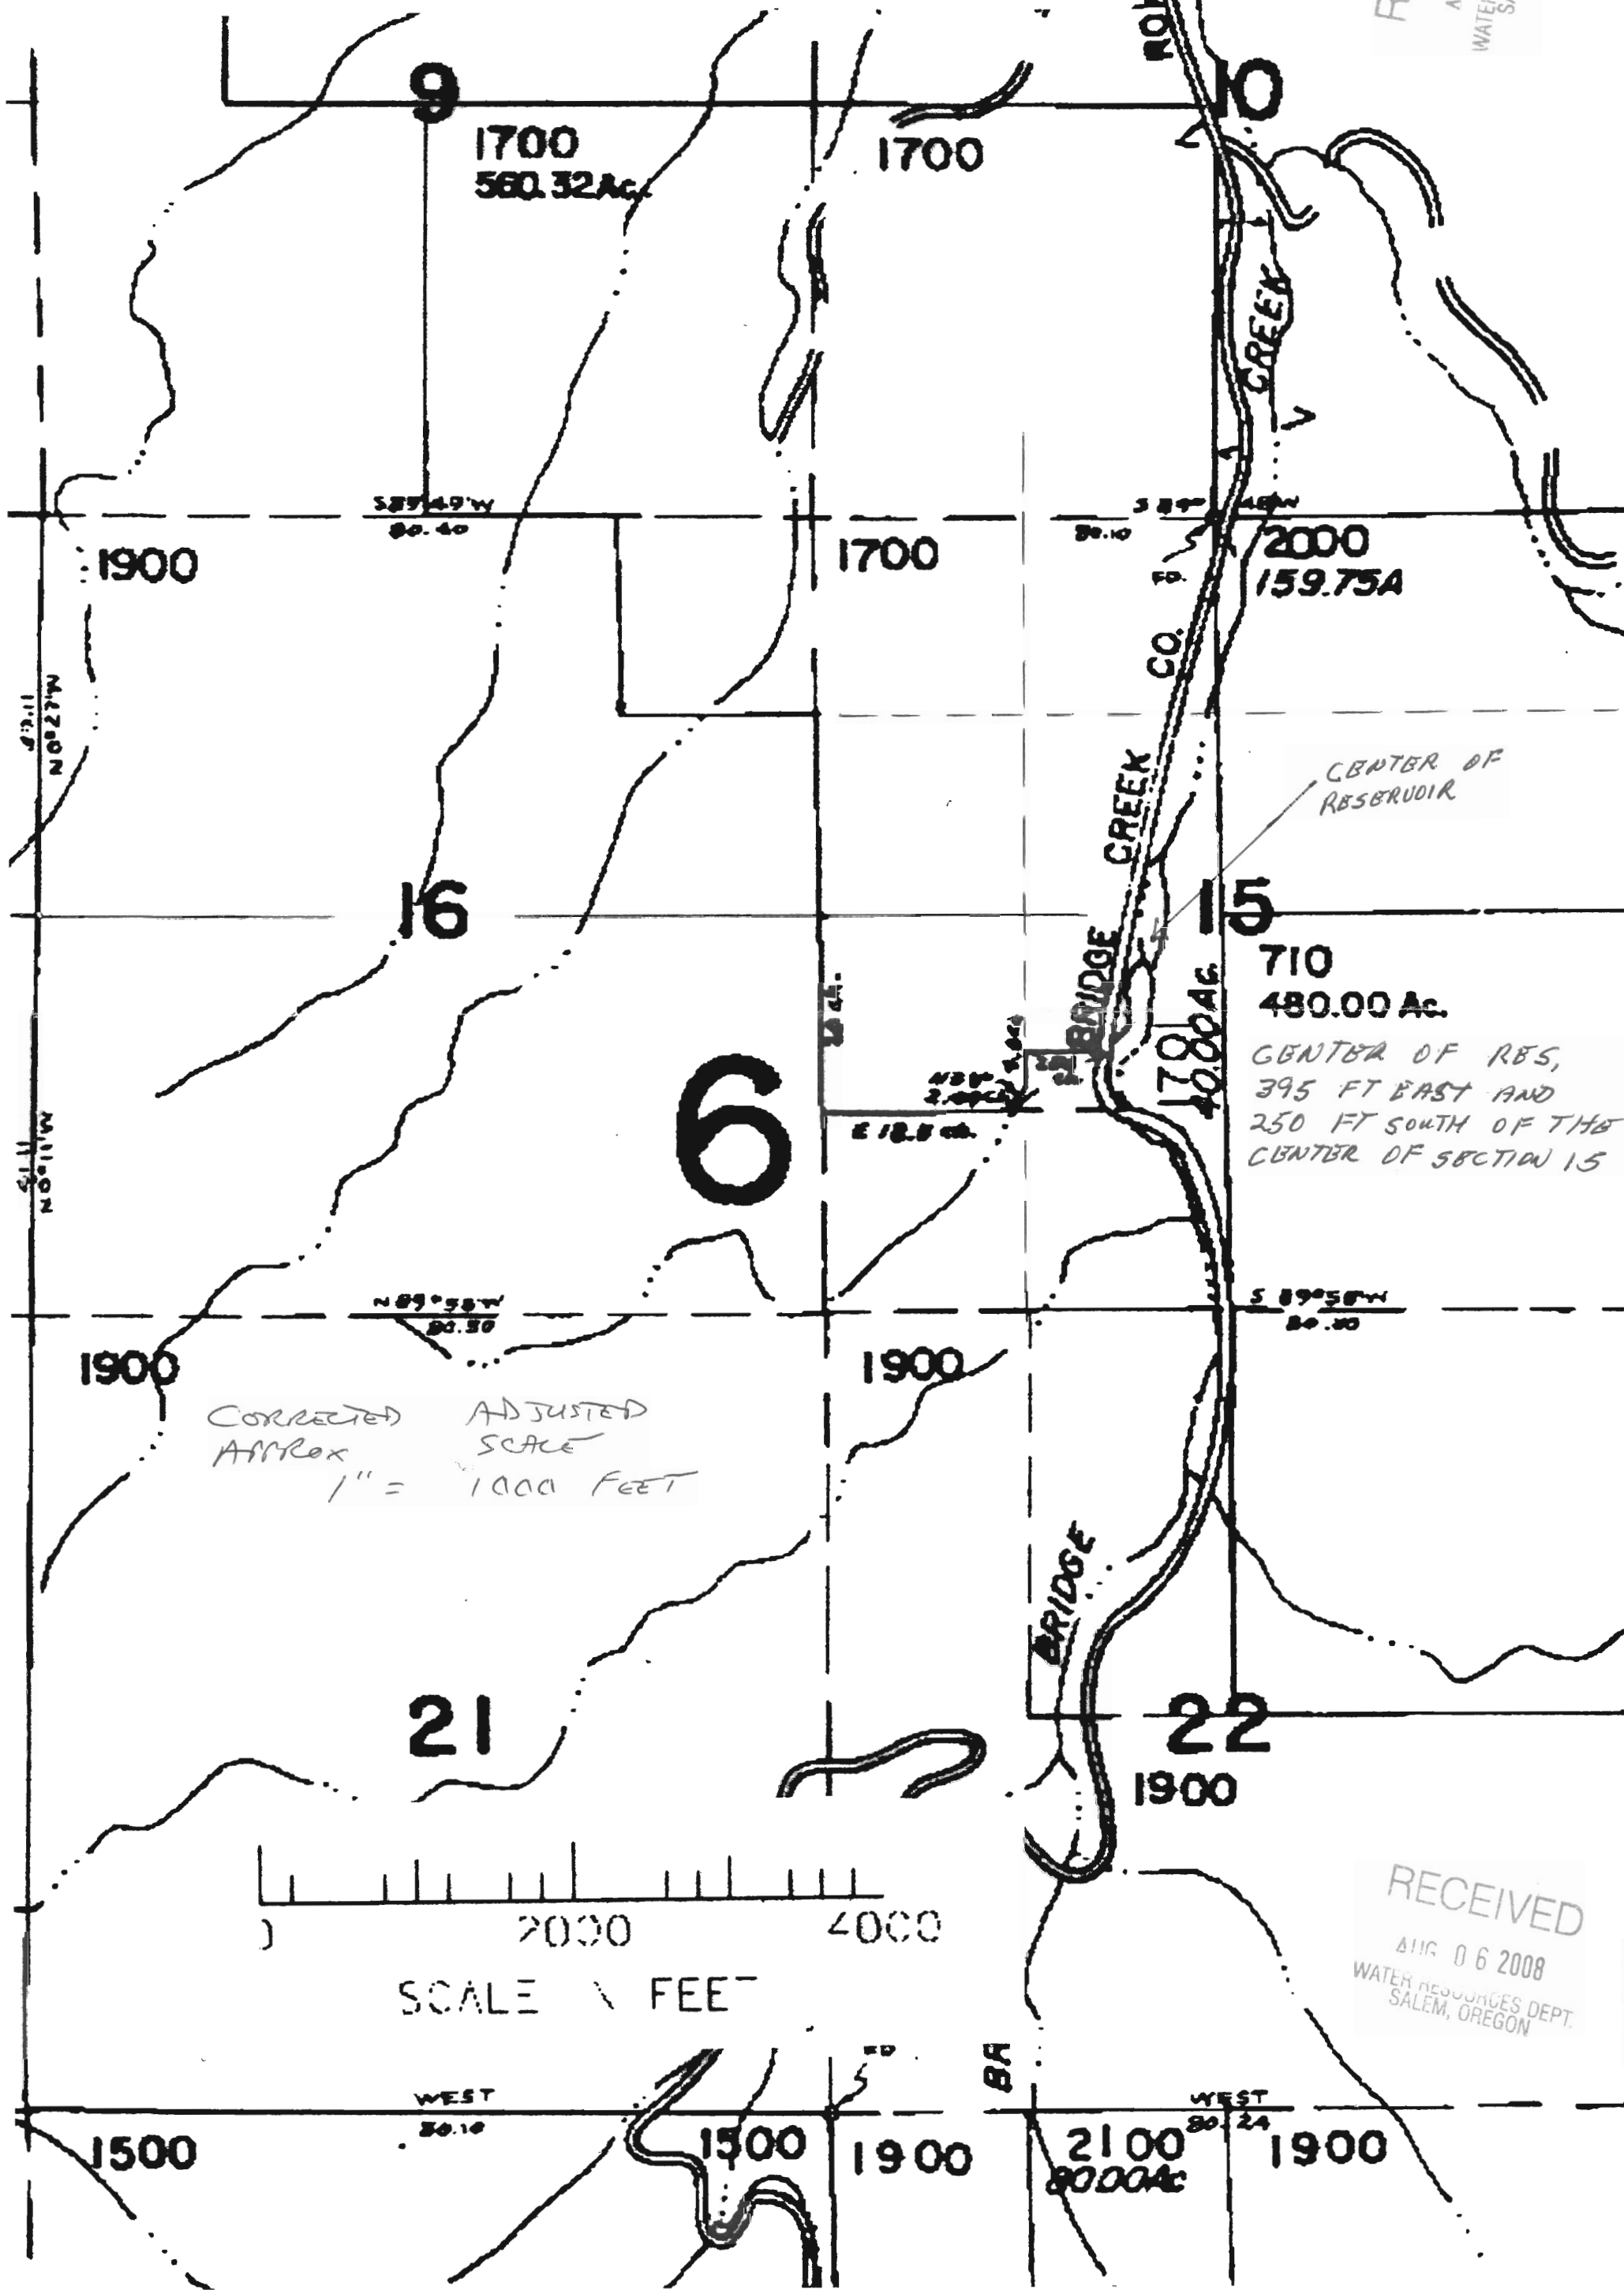

T.12S. R.20E. W.M.
WHEELER COUNTY

