

STATE ENGINEER
Salem, Oregon

LINN
14667

Well Record

STATE WELL NO. 12/2W-24K
COUNTY Linn
APPLICATION NO. GR-3792

OWNER: Harvey Duerksen


MAILING ADDRESS: Route 1, Box 375

LOCATION OF WELL: Owner's No.

CITY AND STATE: Lebanon, Oregon

NW 1/4 SE 1/4 Sec. 24 T. 12 S., R. 2 W., W.M.

Bearing and distance from section or subdivision
corner 1749' N. & 2772' E. of SW Cor. Sec. 24

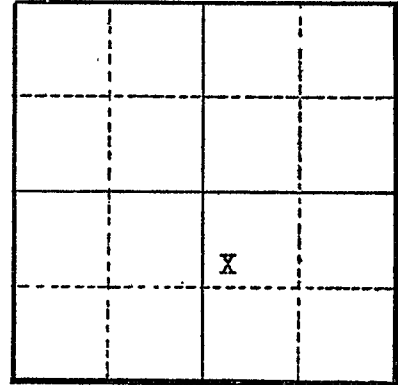

Section 24

Altitude at well

TYPE OF WELL: Drilled Date Constructed 1953

Depth drilled 35 feet Depth cased 35 feet

CASING RECORD:

6 inch steel casing set to 35 feet

FINISH:

Slot perforations from 0 to 20 feet

AQUIFERS:

WATER LEVEL:

PUMPING EQUIPMENT: Type Denning centrifugal H.P. 5
Capacity G.P.M.

WELL TESTS:

Drawdown ft. after hours G.P.M.

Drawdown ft. after hours G.P.M.

USE OF WATER Irrigation Temp. °F., 19

SOURCE OF INFORMATION Well Registration Statement

DRILLER or DIGGER Harvey White

ADDITIONAL DATA:

Log Water Level Measurements Chemical Analysis Aquifer Test

REMARKS: