


GR-3792

RECEIVED  
AUG 1 1958  
STATE ENGINEER  
SALEM, OREGON

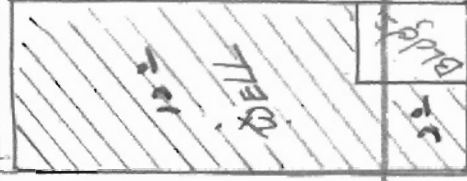

S. 24 S. 125 B. 24W

Map No. 20-141

